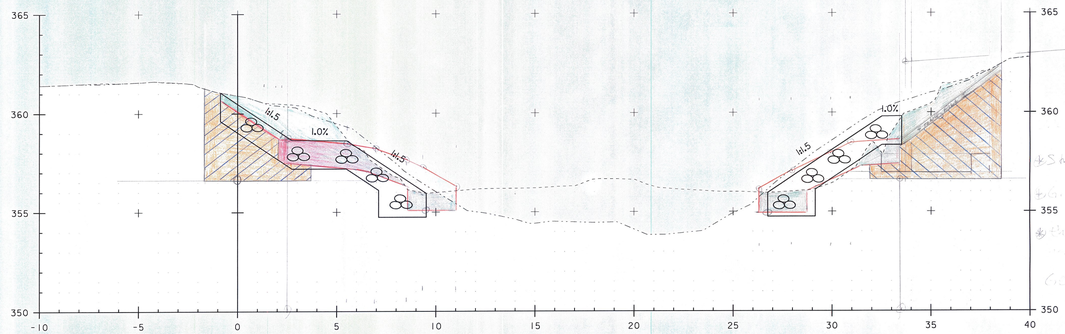

5+007.80

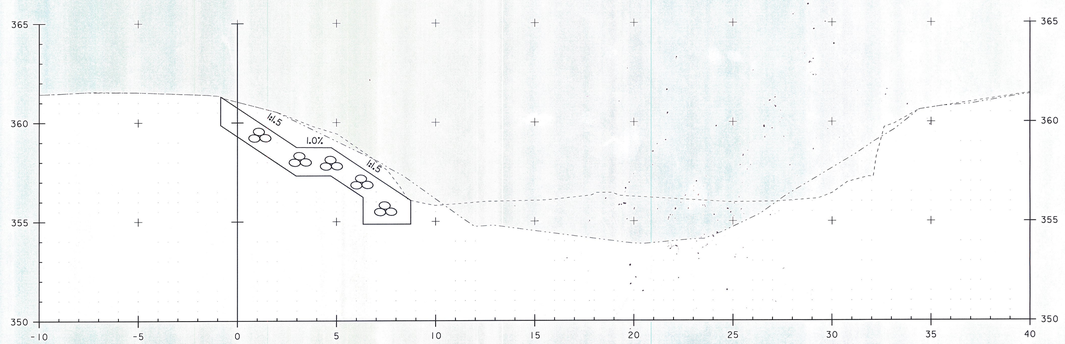

5+005.00

SURFACE LEGEND

- OG 2012
- OG 2009

STA. 5+005 TO STA. 5+008

PROJECT NAME: READSBORO	
PROJECT NUMBER: BRF 0105(3) 300	
FILE NAME: s89J088channelCrossSections300.dgn	PLOT DATE: 15-FEB-2013
PROJECT LEADER: J. LACROIX	DRAWN BY: D. KARABEGOVIC
DESIGNED BY: ------	CHECKED BY: M. LONGSTREET
CH XS SHEET 2	SHEET 3 OF 11