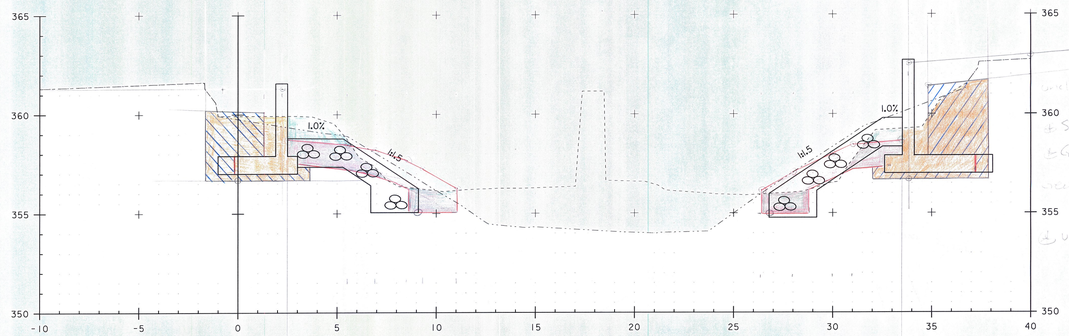

5+011.50

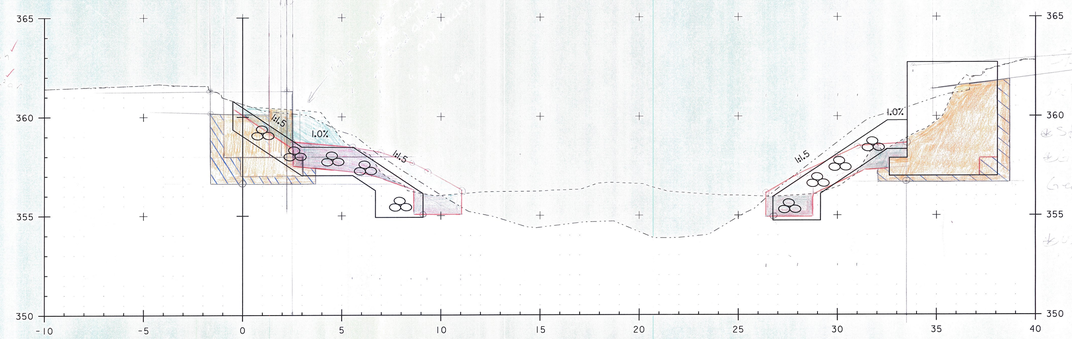

5+008.40

SURFACE LEGEND

- OG 2012
- OG 2009

STA. 5+008 TO STA. 5+011

PROJECT NAME:	READSBORO
PROJECT NUMBER:	BRF 0105(3) 300
FILE NAME: s89J088channelCrossSections300.dgn	PLOT DATE: 15-FEB-2013
PROJECT LEADER: J. LACROIX	DRAWN BY: D. KARABEGOVIC
DESIGNED BY: -----	CHECKED BY: M. LONGSTREET
CH XS SHEET 3	SHEET 4 OF 11