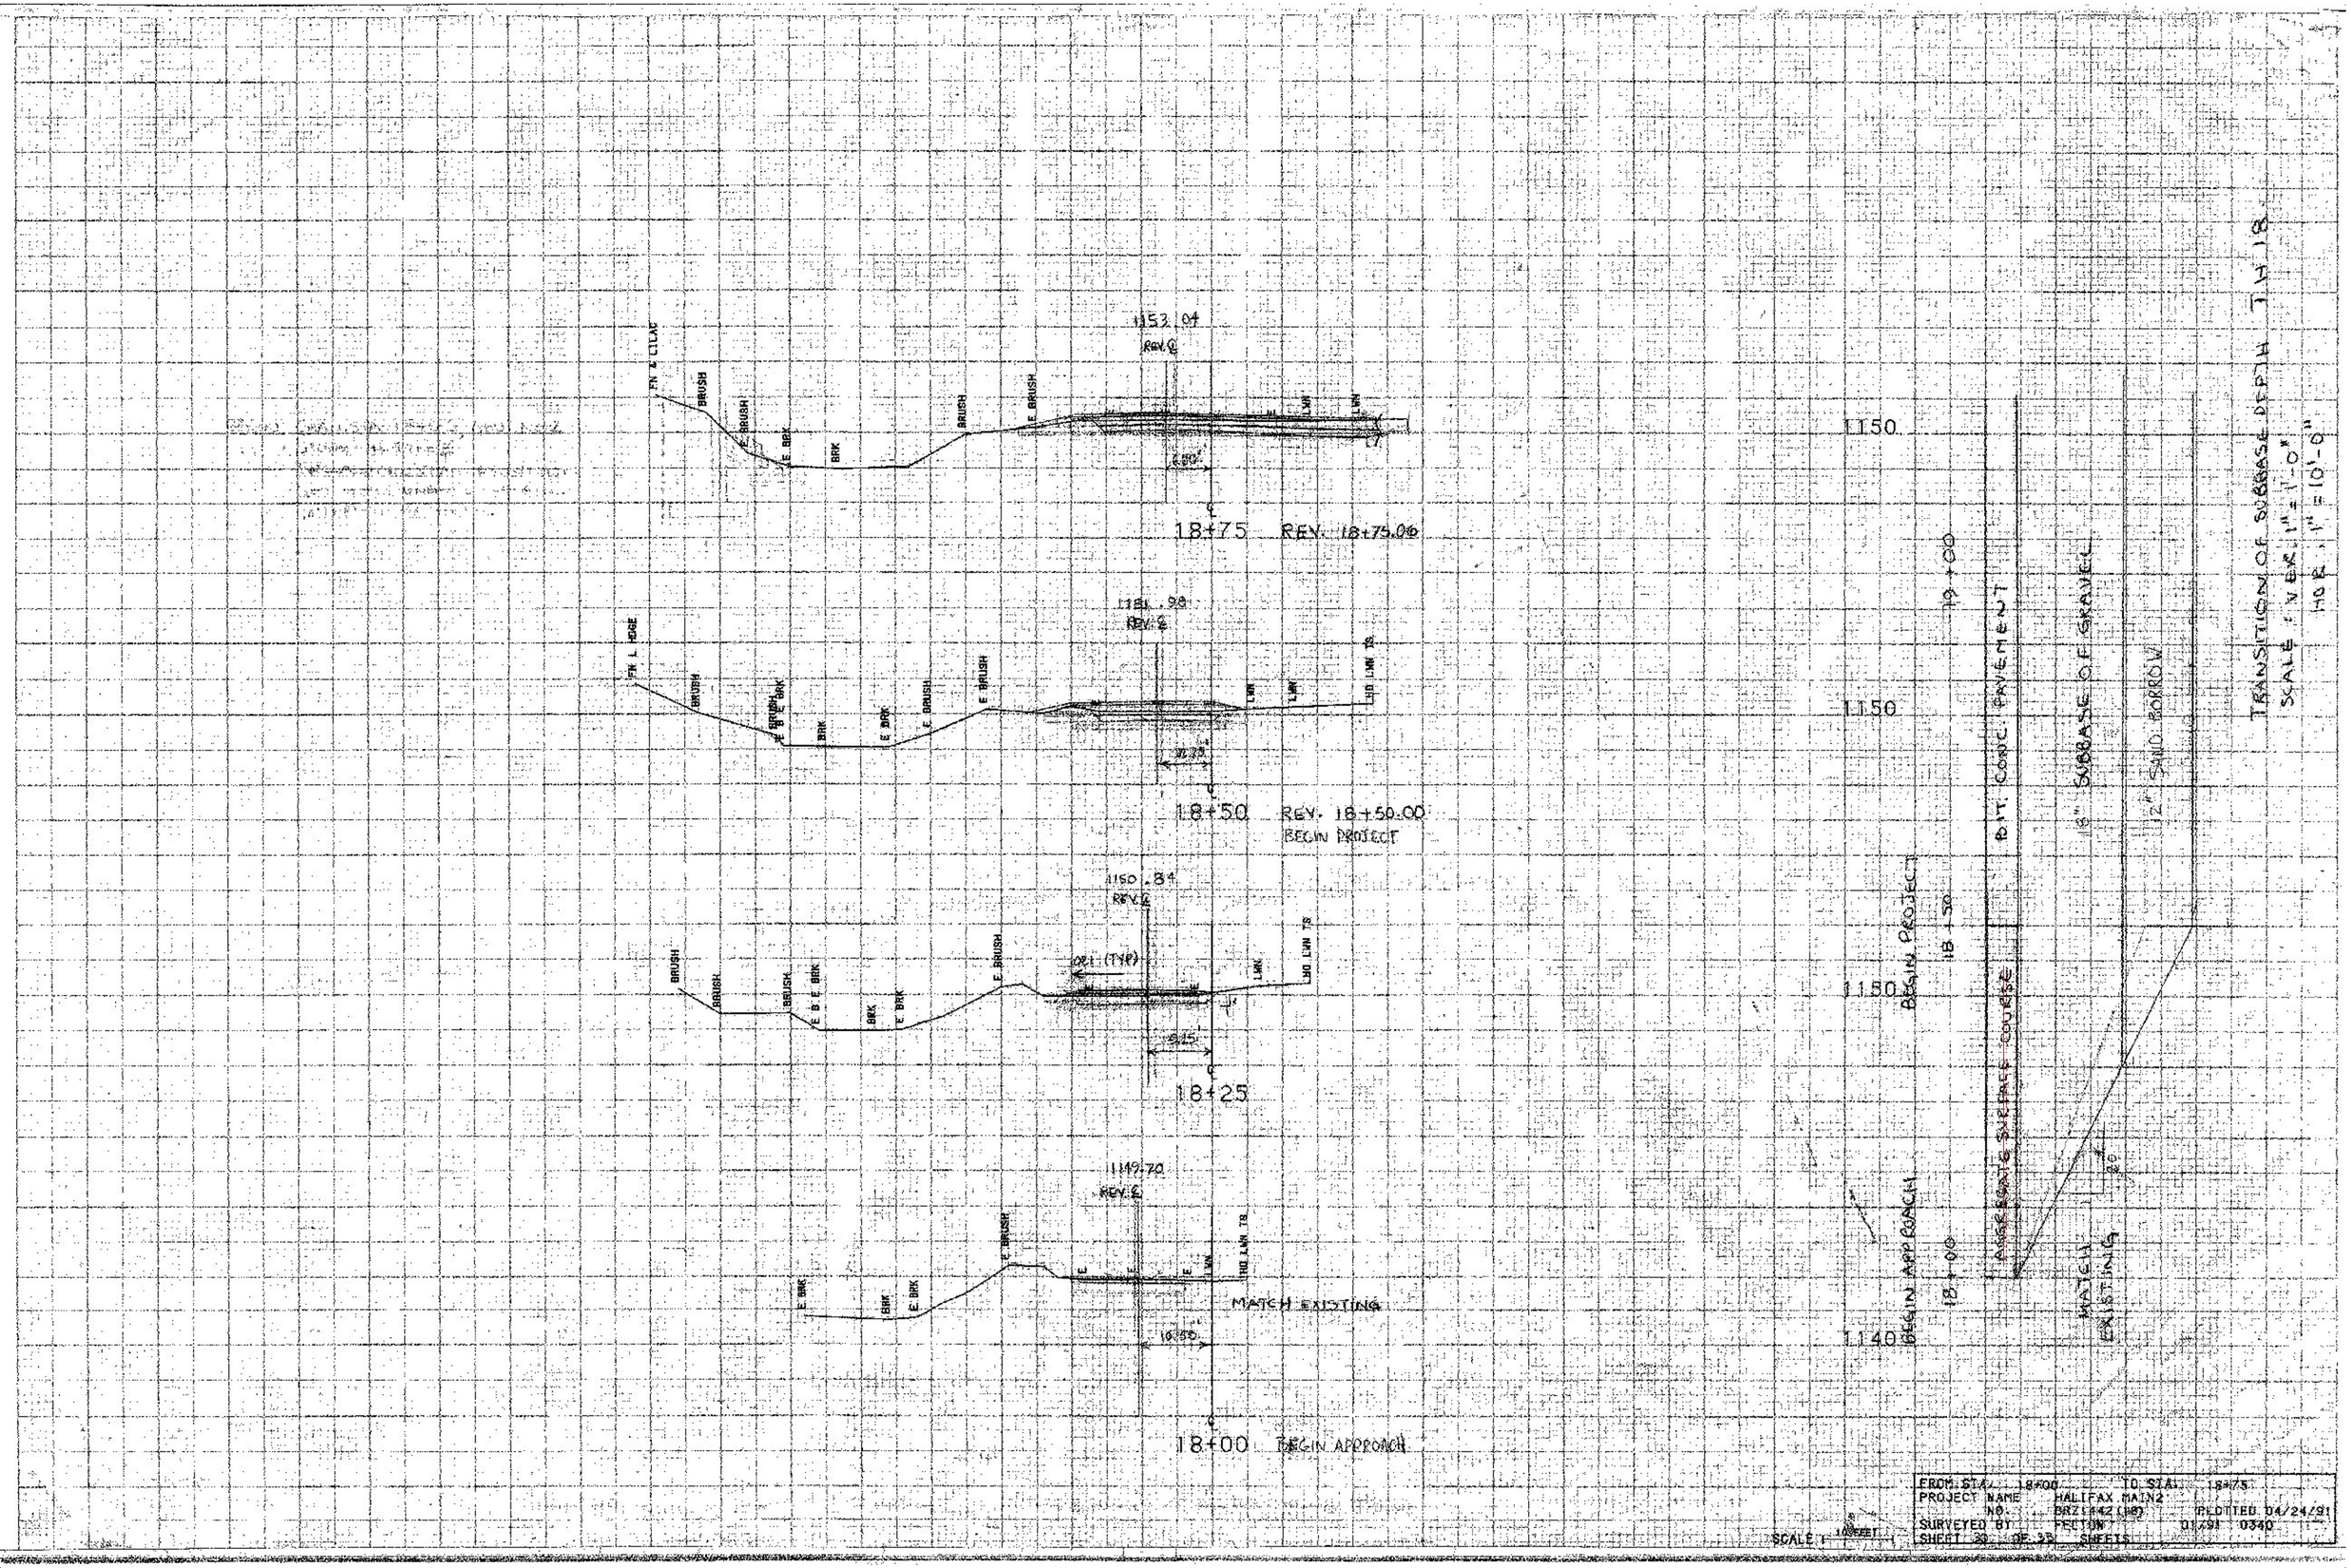
TRANSITION OF SUBBASE DEPTH TH 18
SCALE: VER. 1" = 1'-0"
HOR. 1" = 10'-0"
1153.04
REV.℄
FN & LILAC
BRUSH
E. BRUSH
E. BRK
BRK
LWR
LWR
18+75 REV. 18+75.00
1151.98
REV.℄
FN & HEDGE
E. BRK
E. BRUSH
LWR
LWR
LWD LWR TB
18+50 REV. 18+50.00
BEGIN PROJECT
1150.84
REV.℄
E. BRUSH
LWR
LWD LWR TB
18+25
1149.70
REV.℄
E. BRUSH
E. BRK
BRK
LWR
LWD LWR TB
MATCH EXISTING
18+00 BEGIN APPROACH
1150
1150
1150
1140
19+00
18+50
BEGIN PROJECT
18+00
BEGIN APPROACH
1" ASPHALTIC SURFACE COURSE
8" BIT. CONC. PAVEMENT
18" SUBBASE OF GRAVEL
12" SAND BORROW
MATCH EXISTING
FROM STA. 18+00 TO STA. 18+75
PROJECT NAME HALIFAX MAIN2
NO. BRZ-142(08)
PLOTTED 04/24/91
SURVEYED BY FECTON 01/91 0340
SHEET 30 OF 33 SHEETS
SCALE 1" = 10 FEET