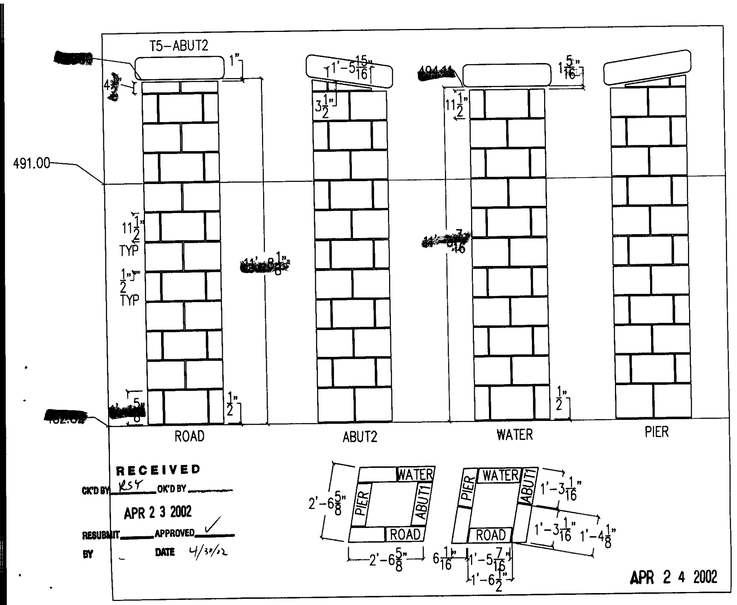
T5-ABUT2
[redacted]
1"
1'-5 15/16"
1 5/16"
3 1/2"
11 1/2"
491.00
11 1/2" TYP
1/2" TYP
1/2"
ROAD
ABUT2
WATER
PIER
WATER
PIER
ABUT1
ROAD
2'-6 5/8"
1'-3 1/16"
1'-4 1/8"
6 1/16"
1'-5 7/16"
1'-6 1/2"
RECEIVED
CK'D BY KSY OK'D BY
APR 2 3 2002
RESUBMIT APPROVED ✓
BY DATE 4/30/02
APR 2 4 2002