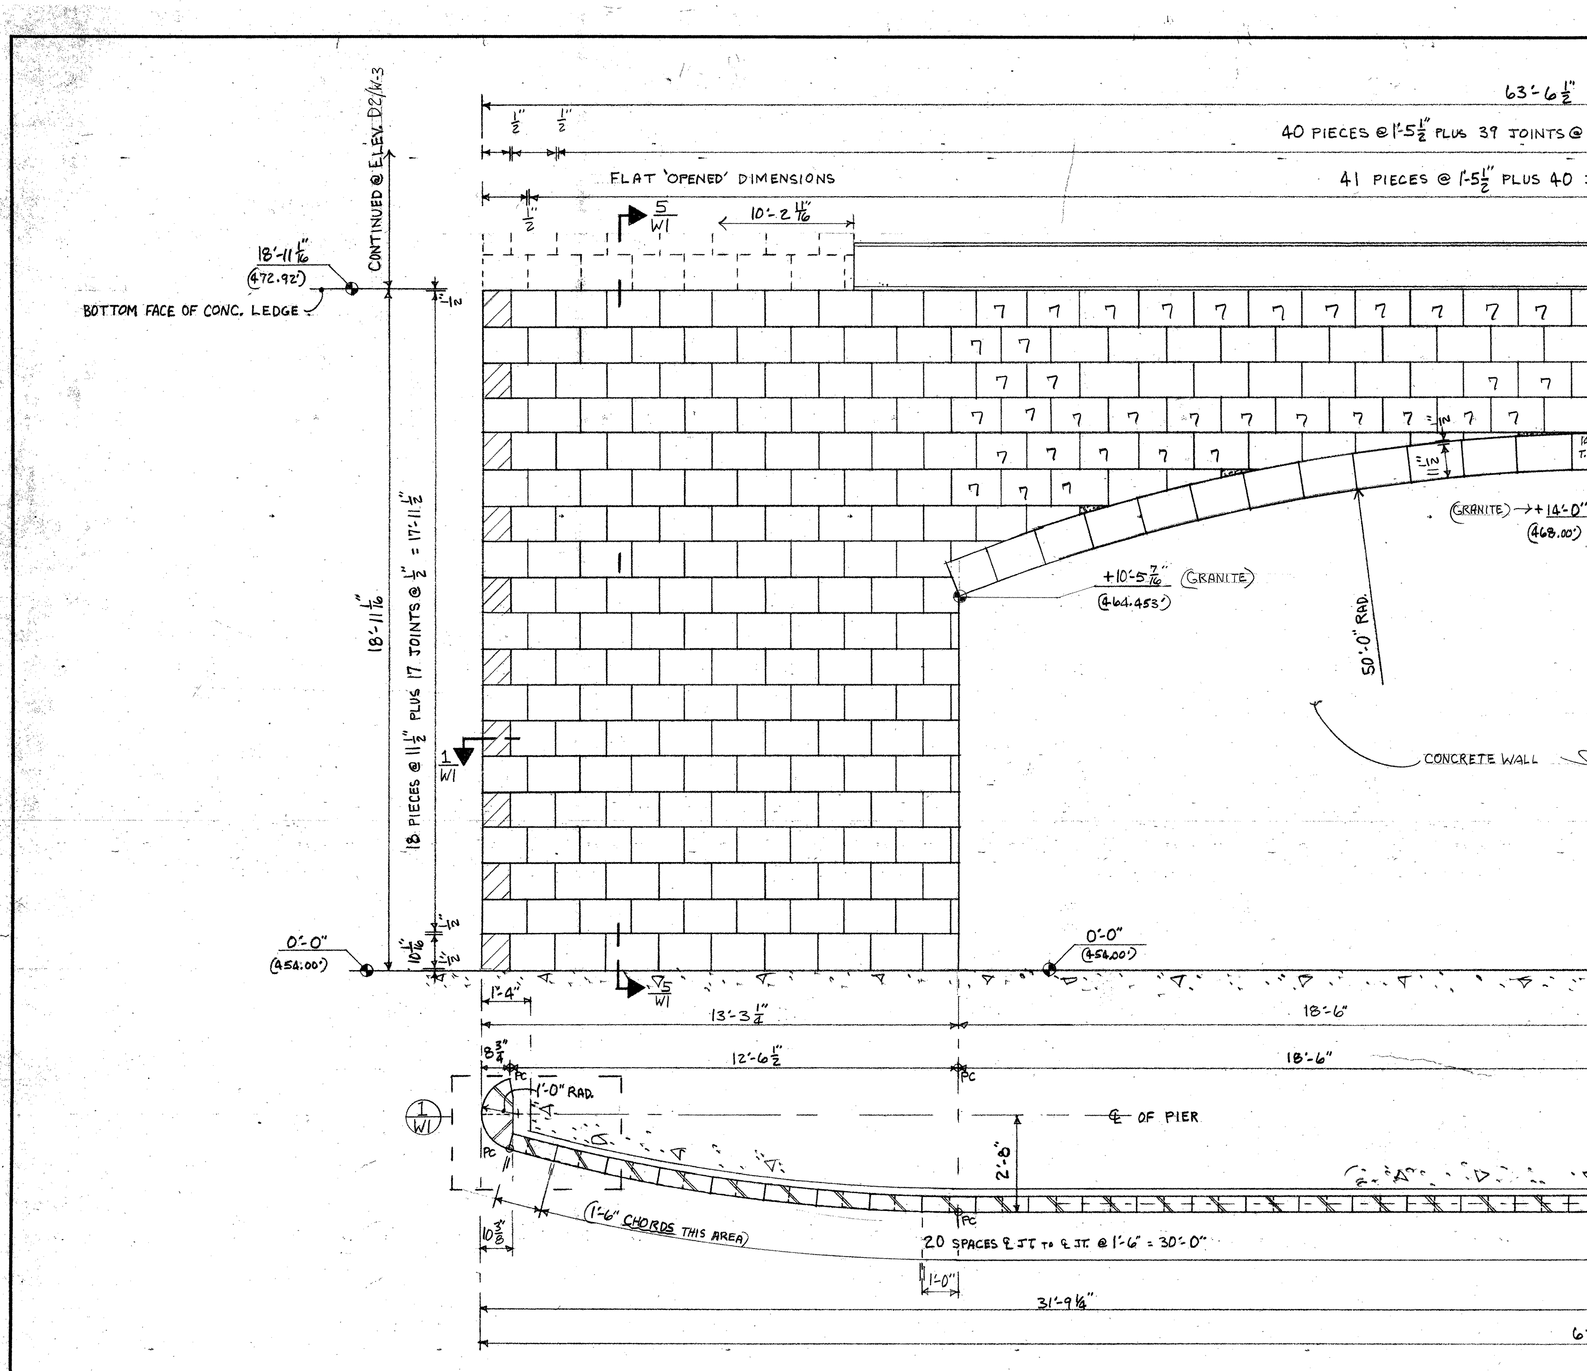

B PLAN & ELEVATION 1/2" = 1'-0"

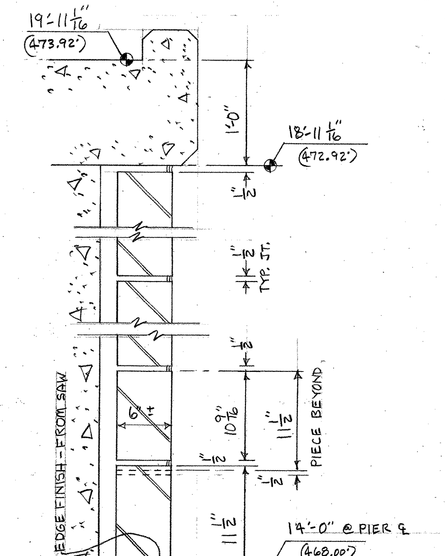

1 1/2" = 1'-0" SECTION 1

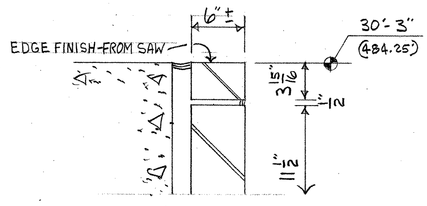

2 SECTION 1 1/2" = 1'-0"

REF: D2/W3

TYPICAL CONDITIONS - SEE 1/W9 2/W9 3/W9

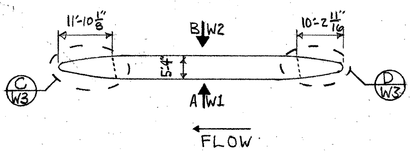

KEY PLAN

NOTE:

This shop drawing rep
specifications, and our c

Prior to manufacture
construction, and existing
by our customer.

No stone will be schedu
by our customer that our
Approval delay results i

Any stone fabricated i
not fit job conditions will b
expense, and only after

We assume no respon
trades unless adequate
ings at the time they are

We assume no respons
but our own, and will no
use of this drawing by o