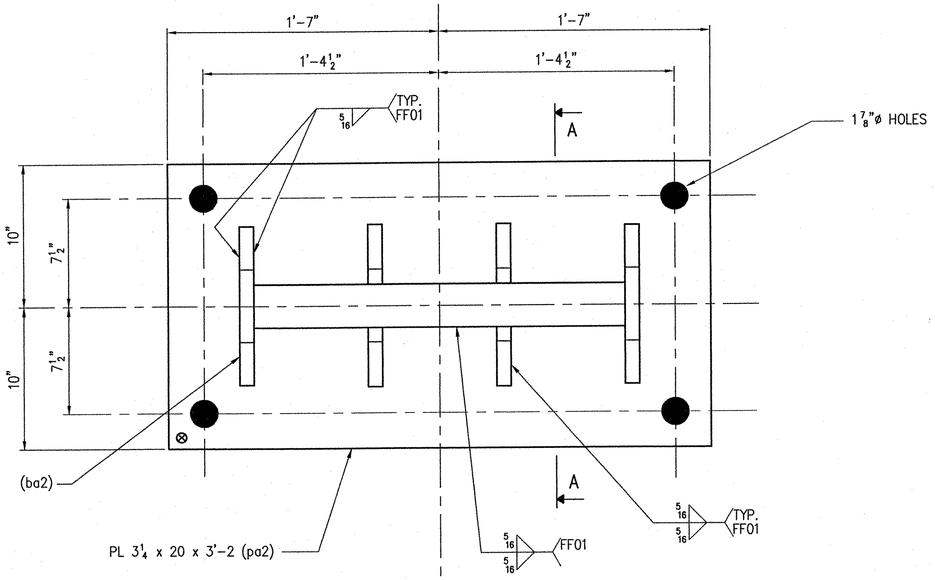

SHOP NOTE :
⊗ – INDICATES LOCATION OF SHIPPING PIECE MARK

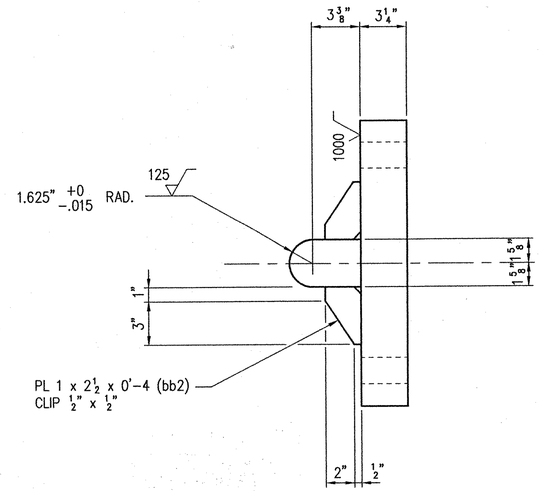

SECTION A–A

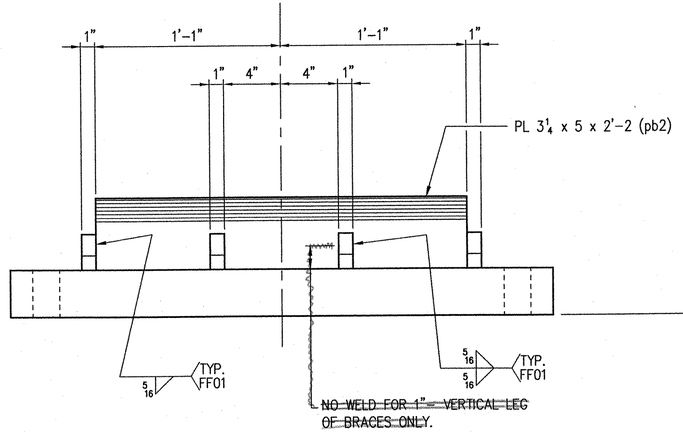

5 – MASONRY PLATE ASSEMBLY – 2A

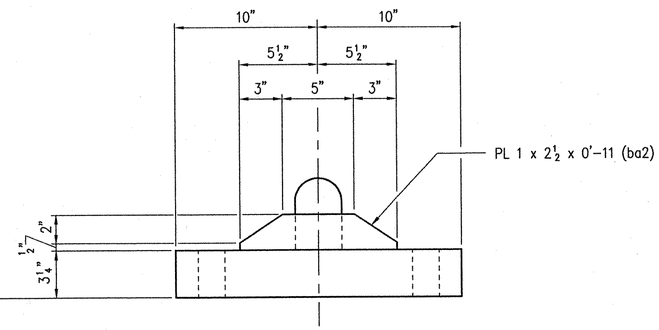

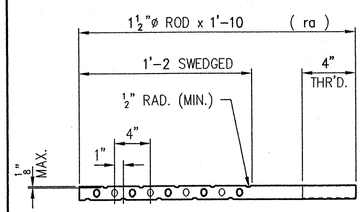

20 – ANCHOR RODS – 2B

ONE DEFORMATION WITHIN EACH INCH, DEFORMATIONS ARE 90° OUT OF PHASE WITH ADJACENT DEFORMATIONS.

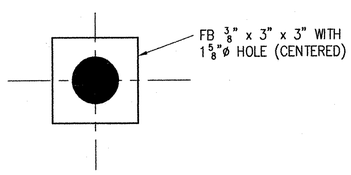

20 – PLATE WASHERS – 2C

GENERAL NOTES: SEE SHT. GN1.

LINE	NO. REQ'D.	DESCRIPTION	LENGTH	MK	REMARKS	PART NO.
1	5	MASONRY PLATE ASSEMBLY		2A	METALIZE/ PAINT	
2	5	PL 3¼ x 20 A709 GR. 50	3'-2	pa2	MACH./ ADD MAT'L. FOR MACH.	
3	5	PL 3¼ x 5 A709 GR. 50	2'-2	pb2	MACH./ ADD MAT'L. FOR MACH.	
4	10	PL 1 x 2½ A709 GR. 50	0'-11	ba2	SHAPE CUT	19-60
5	20	PL 1 x 2½ A709 GR. 50	0'-4	bb2	SHAPE CUT	19-60
6						
7						
8	20	ANCHOR RODS		2B	HDG	
9	20	RB 1½" A36	1'-10	2B	SWEDGE	
10						
11	20	PLATE WASHERS		2C	HDG	
12	20	FB ⅜ x 3 A36	0'-3	2C		
13						
14						
15	21	HN 1½"ø HVY. A563A HDG		2D	20	
16						
17						
REV.	DESCRIPTION	DATE	INT.

RECEIVED
CKD BY LWSS CKD BY RSK
MAR 12 2001
ACCEPTED APPROVED As Noted
BY CPW DATE 3/29/01

ANY AND ALL BACKCHARGES WILL BE REJECTED UNLESS WRITTEN CONSENT IS GIVEN BY LEWIS ENGINEERING COMPANY PRIOR TO ANY WORK PERFORMED FOR OUR ACCOUNT. SUCH REJECTION MEANS THAT INVOICES WILL NOT BE HONORED OR DEDUCTIONS FROM PAYMENT WILL BE CHARGED BACK.

LEWIS ENGINEERING COMPANY
4201 NOREX DRIVE – CHASKA, MINNESOTA 55318 – (612) 368-3000

PROJECT – ROYALTON/ RTE. NO. TH 1, CL 1 BRIDGE NO. 3
STATE PROJECT – AC BRZ 1444(22)
FEDERAL PROJECT –
CUSTOMER – BECK & BELLUCCI, INC.
LOCATION – WINDSOR COUNTY, VT
DESCRIPTION – PIER FIXED BEARING DETAILS

ORIG.
W.P. chk'd JDK
Drawn By TSF
Chk'd. By NY
Date: 2/01

SHEET NO. 2 OF 2
Job. No. : 2034.1121.1

SHOP	
APPROVAL	
DIST.	
CUST.	
FOR PRINTS ISSUED	DATE