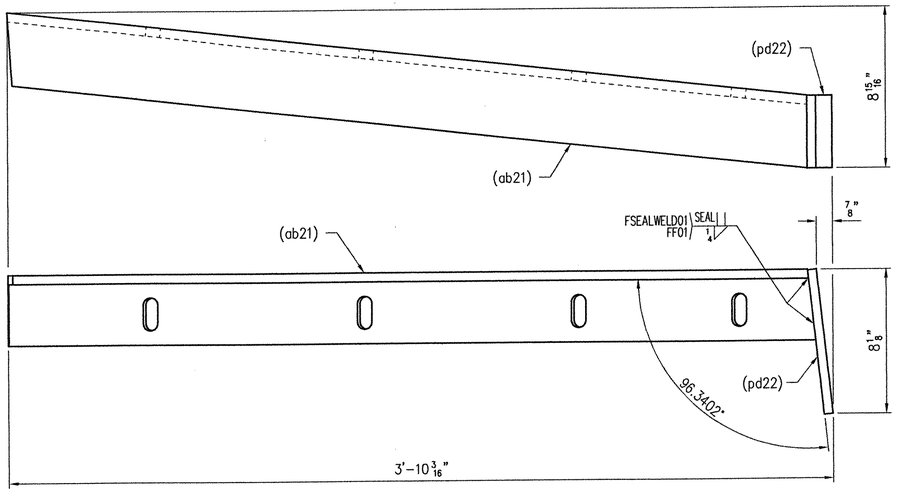

1 – SUB–ASSEMBLY – 19A

(SOME HIDDEN LINES REMOVED FOR CLARITY)

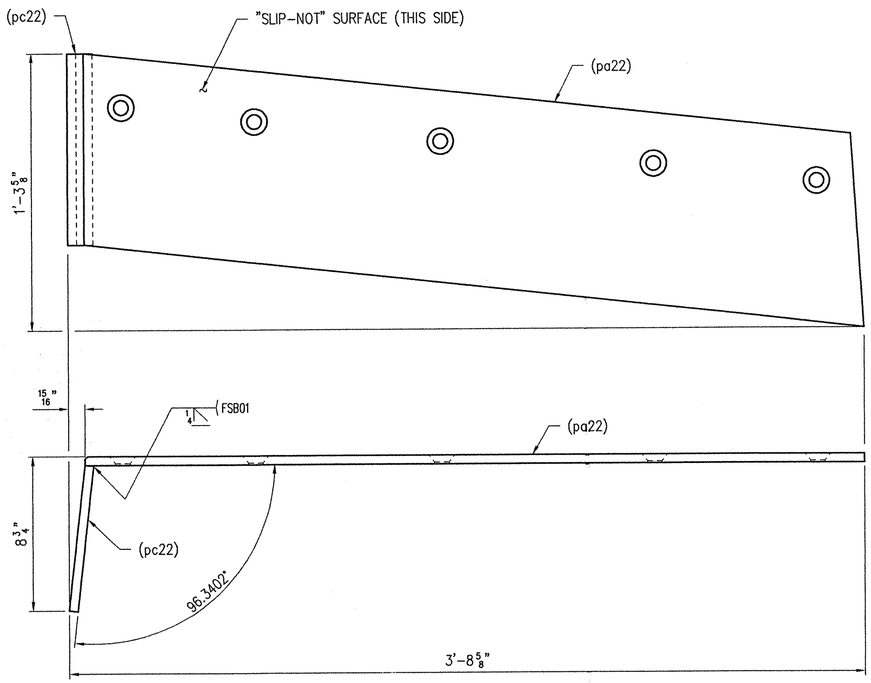

1 – SUB–ASSEMBLY – 19C

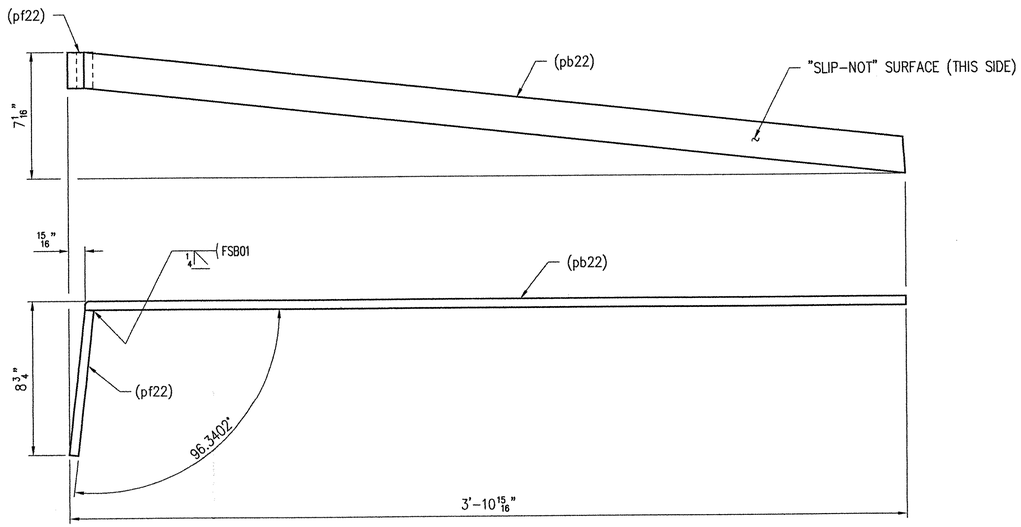

1 – SUB–ASSEMBLY – 19B

SEE SHEET NO. 30 FOR GENERAL NOTES.
WORK THIS SHEET WITH SHEET NO. 18, 20, 21 & 22.

REV.	DESCRIPTION	DATE
1	GENERAL REVISION PER APPROVAL.	1/11/02

ANY AND ALL BACKCHARGES WILL BE REJECTED UNLESS WRITTEN CONSENT IS GIVEN BY LE ENGINEERING COMPANY PRIOR TO ANY WORK PERFORMED FOR OUR ACCOUNT. SUCH REJECT MEANS THAT INVOICES WILL NOT BE HONORED OR DEDUCTIONS FROM PAYMENT WILL BE CHARGED BA

RECEIVED
CK'D BY WJH OK'D BY
JAN 2 1 2002
RESUBMIT APPROVED
BY CPW DATE 1/24/02

SHOP	
APPROVAL	
DIST.	
CUST.	
FOR PRINTS ISSUED	DATE

LEWIS ENGINEERING COMPANY
4201 NOREX DRIVE – CHASKA, MINNESOTA 55318 – (952) 368–3000

PROJECT	—	ROYALTON / RTE. NO. TH 1, CL 1 BRIDGE NO. 3
STATE PROJECT	—	AC BRZ 1444(22)
FEDERAL PROJECT	—	
CUSTOMER	—	BECK & BELLUCCI, INC.
LOCATION	—	WINDSOR COUNTY, VT
DESCRIPTION	—	EXPANSION JOINT DETAILS ABUTMENT NO. 1

W.P. chk'd	Or
Drawn By	J
Chk'd. By	T
Date:	12/20,

L.E.C. 19 OF 30 | SHEET NO. 4 OF 15 | Job. No. : 2034.10