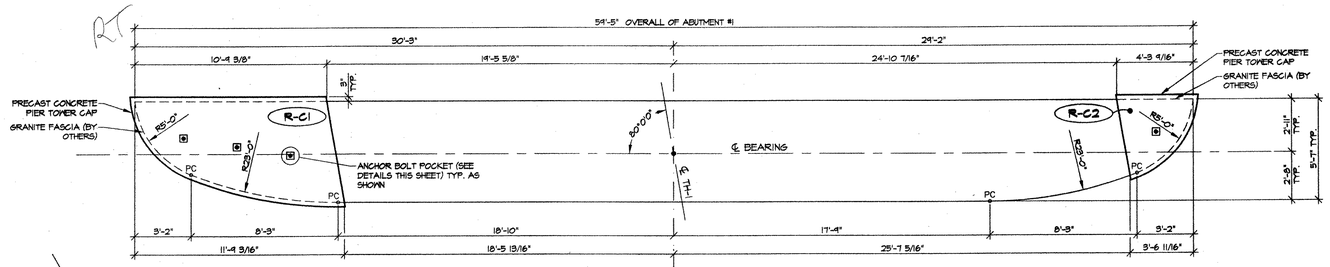

1 / F1 PIER TOWER CAP PLAN - ABUTMENT #1

1/4" = 1'-0"

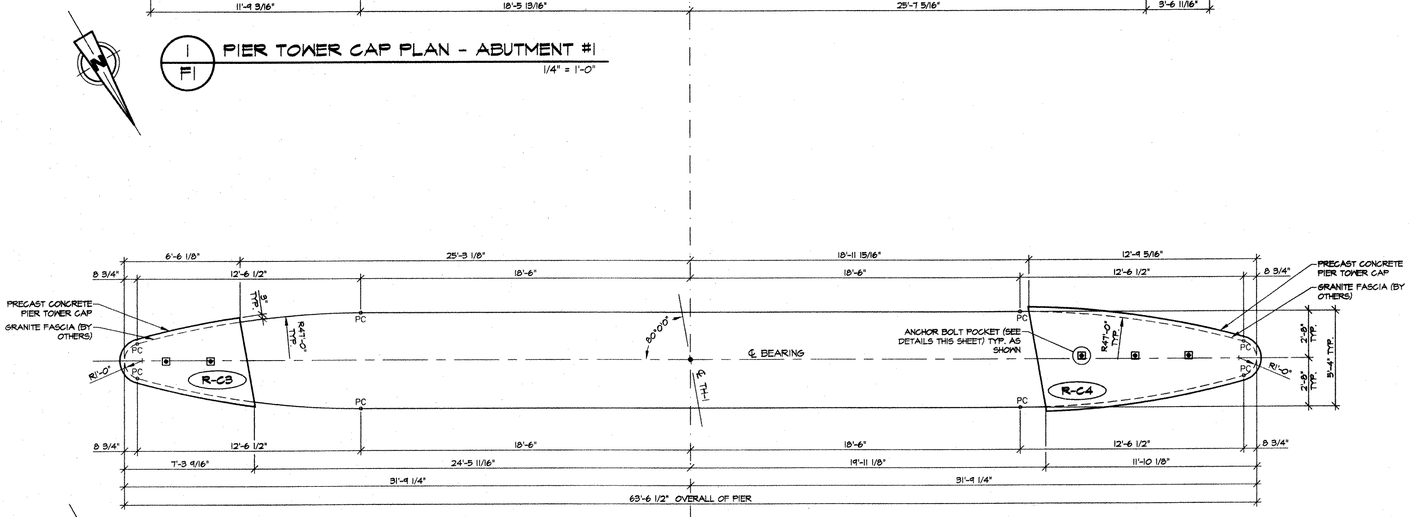

2 / F1 PIER TOWER CAP PLAN - PIER

1/4" = 1'-0"

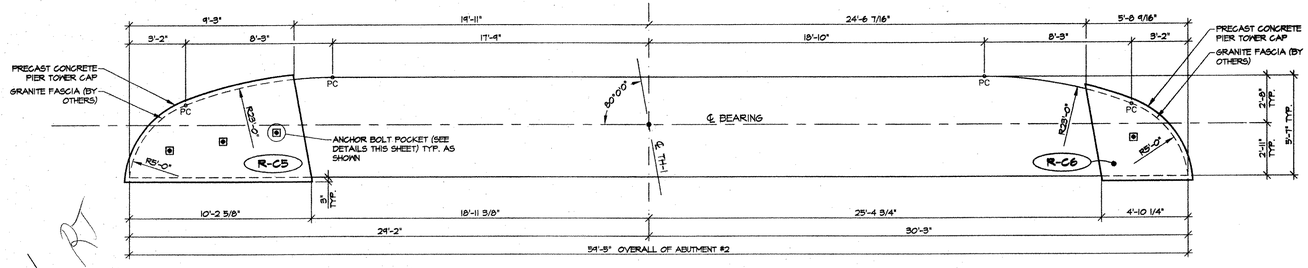

3 / F1 PIER TOWER CAP PLAN - ABUTMENT #2

1/4" = 1'-0"

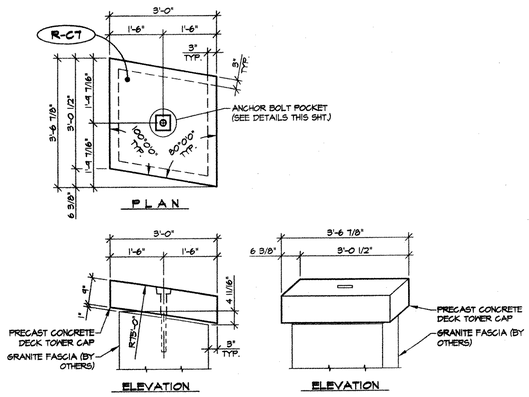

4 / F1 DECK TOWER CAP (AT (6) LOCATIONS) 1/2" = 1'-0"

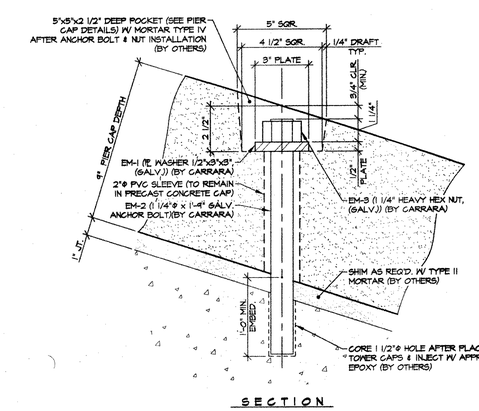

ANCHOR BOLT INSTALLATION DETAIL

3" = 1'-0"

RECEIVED
CK'D BY LWS OK'D BY
APR 26 2001
RESUBMIT APPROVED ✓
BY DPW DATE 5/29/01

NO.	DATE	REVISION	BY
1	4-5-01	RESUBMITTED FOR APPROVAL	B.L.

DRAWN: B.M. LOPEZ
DESIGNED: E.J. BROD
CHECKED:
APPROVED:

J.P. CARRARA & SONS INC.
Precast & Prestress Manufacturer
2484 CASE STR., MIDDLEBURY, VERMONT 05753
Phone:(802)388-5361
Fax:(802)388-9010
Double-Tees Hollow-Core Plank Flat Panels

BECK & BELLUCCI, INC.
10 SALISBURY ROAD, PO BOX 429
FRANKLIN, NEW HAMPSHIRE 03235

Project Name:
ROYALTON BRIDGE
BRZ 1444 (22)
ROYALTON, VERMONT

TOWER CAP LAYOUT
PLANS & DETAILS

SCALE:	JOB #:
NOTED	23111-00
DATE:	SHEET #:
2-20-01	F1