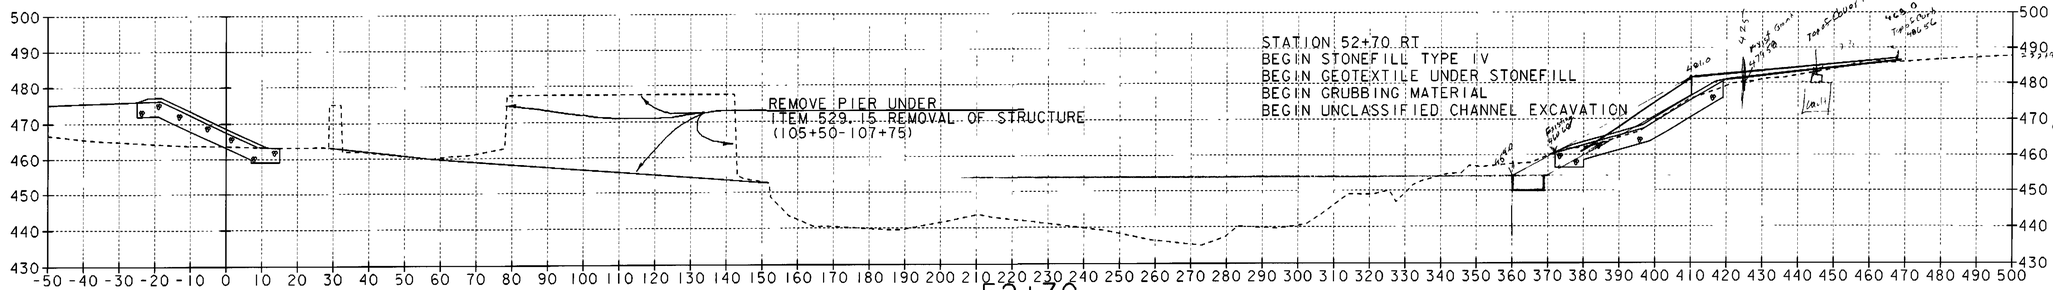

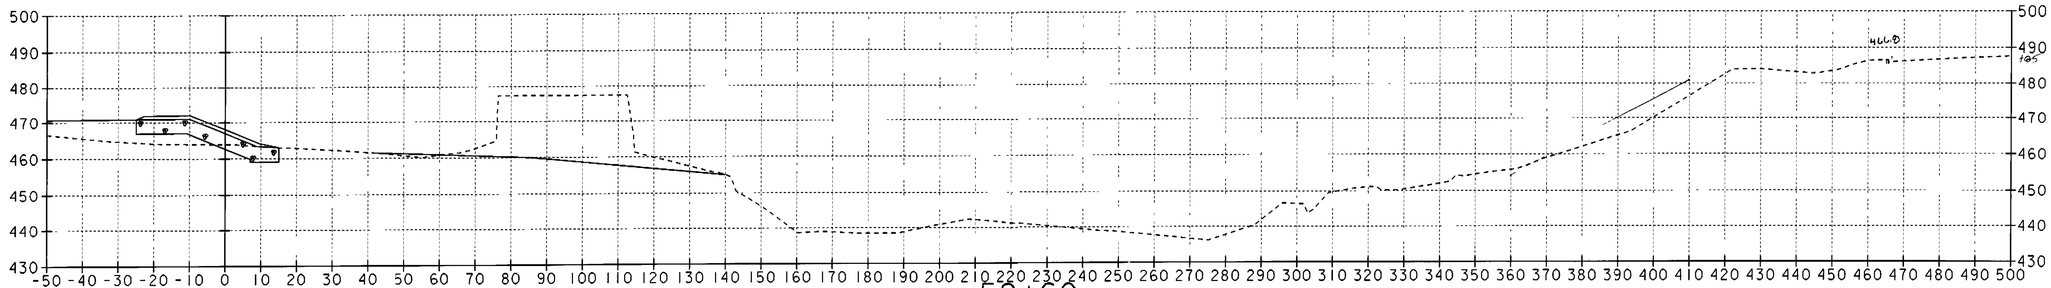

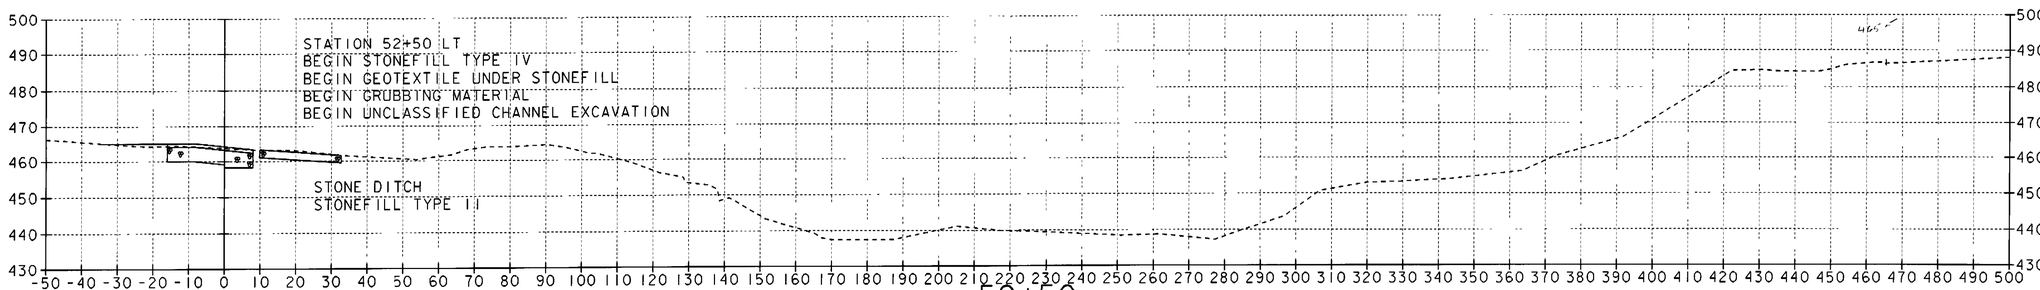

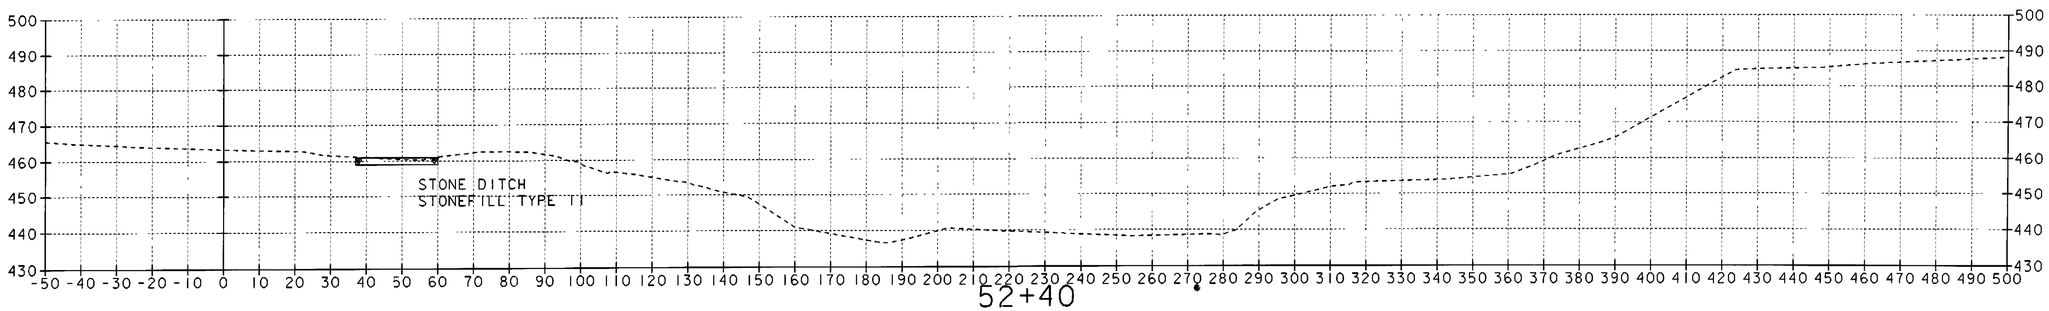

SCALE 1" = 20'-0
20 0 20

PROJECT: ROYALTON	PROJECT NO.: BRZ 1444(22)
DESIGN FILE NAME: 89J099/structures/sJ099chx.dgn IPARM FILE NAME: sJ099c04.I	PLOT DATE: 25-SEP-2000
CHANNEL CROSS SECTIONS 52+40 - 52+70	
	SHEET: 113 OF 118