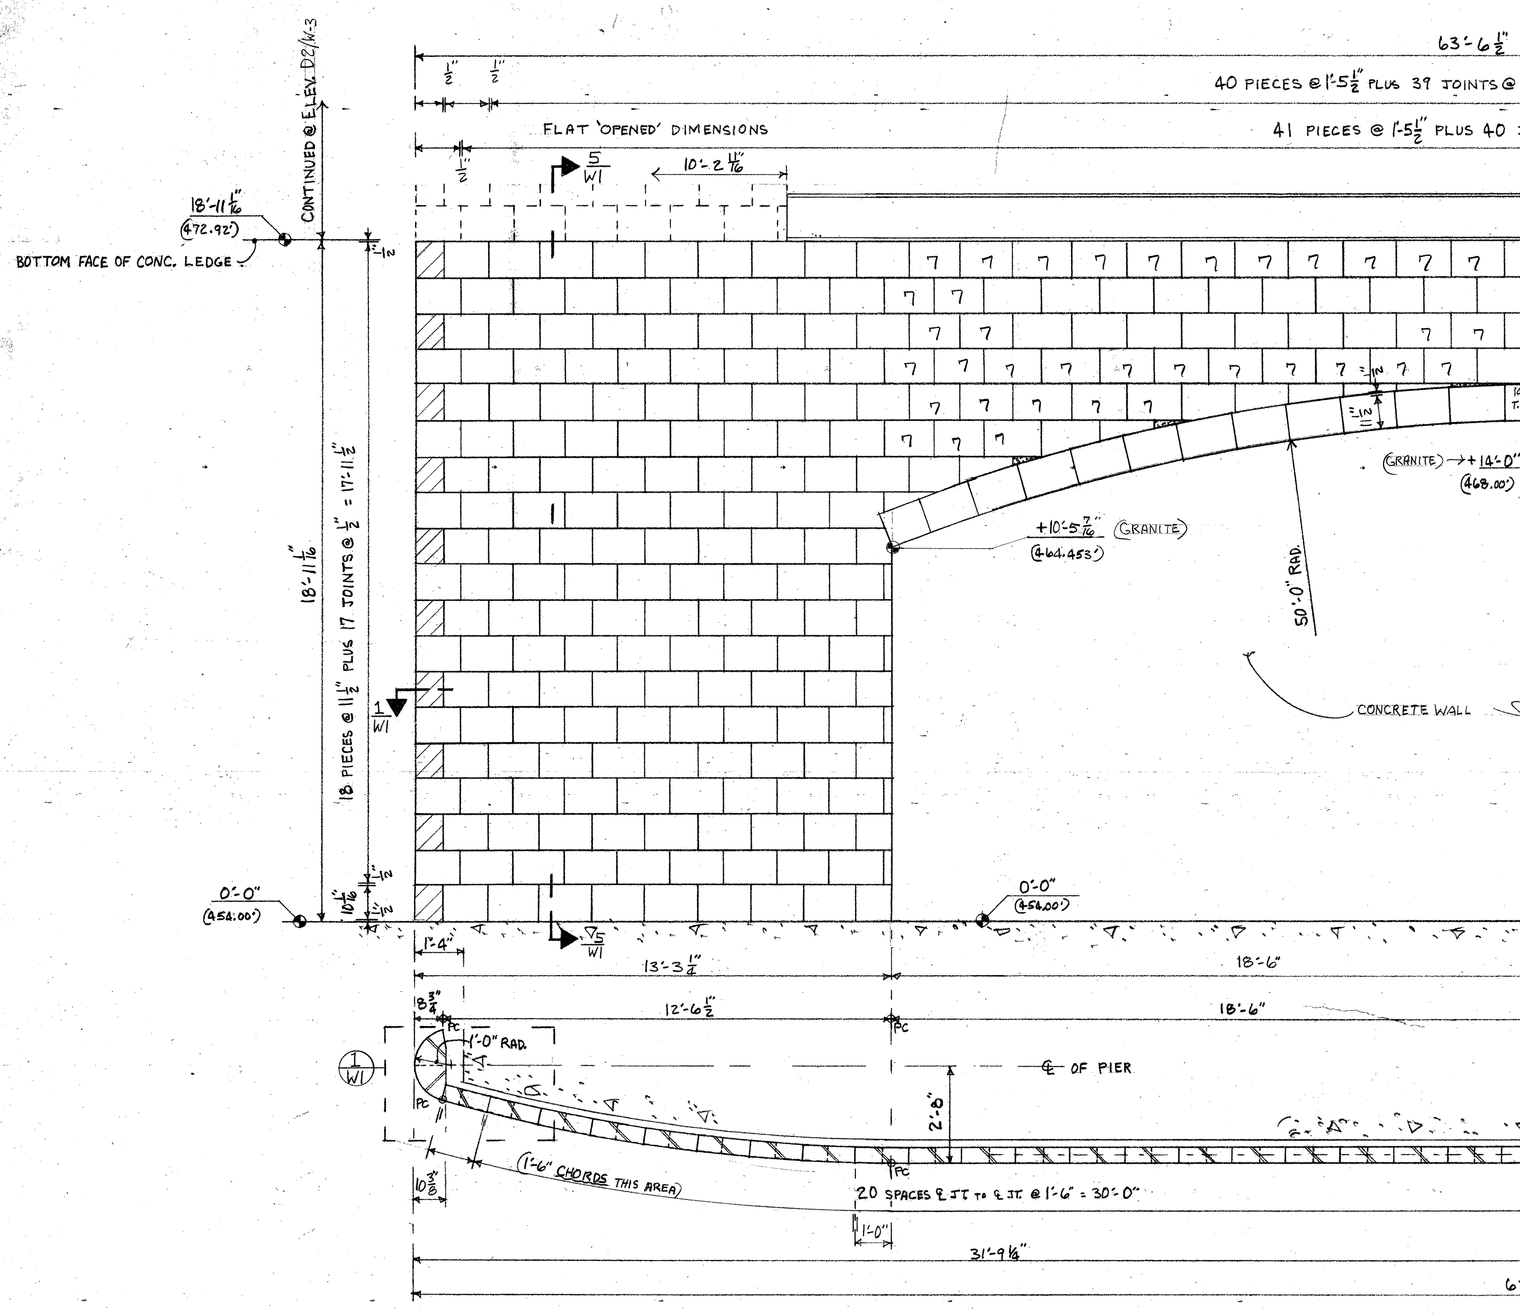

(B) PLAN & ELEVATION 1½" = 1'-0"

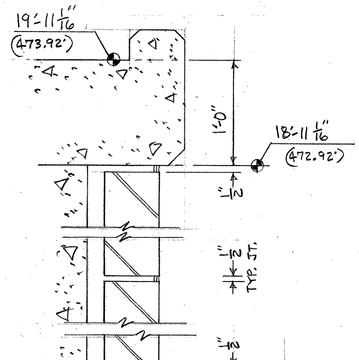

1½" = 1'-0" SECTION (1)

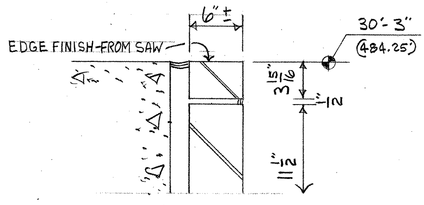

(2) SECTION 1½" = 1'-0"

REF: D2/W3

TYPICAL CONDITIONS - SEE (1/W9) (2/W9) (3/W9)

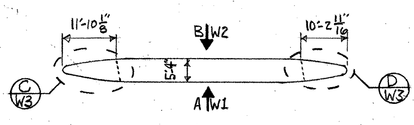

KEY PLAN

NOTE:
This shop drawing rep
specifications, and our
Prior to manufacture
construction, and existing
by our customer.
No stone will be sched
by our customer that our
Approval delay results in
Any stone fabricated i
not fit job conditions will b
expense, and only after
We assume no respon
trades unless adequate
ings at the time they ar
We assume no respons
but our own, and will no
use of this drawing by