WORK ORDER NO.	DRAWING NO.	REV.
15873	E 2	2

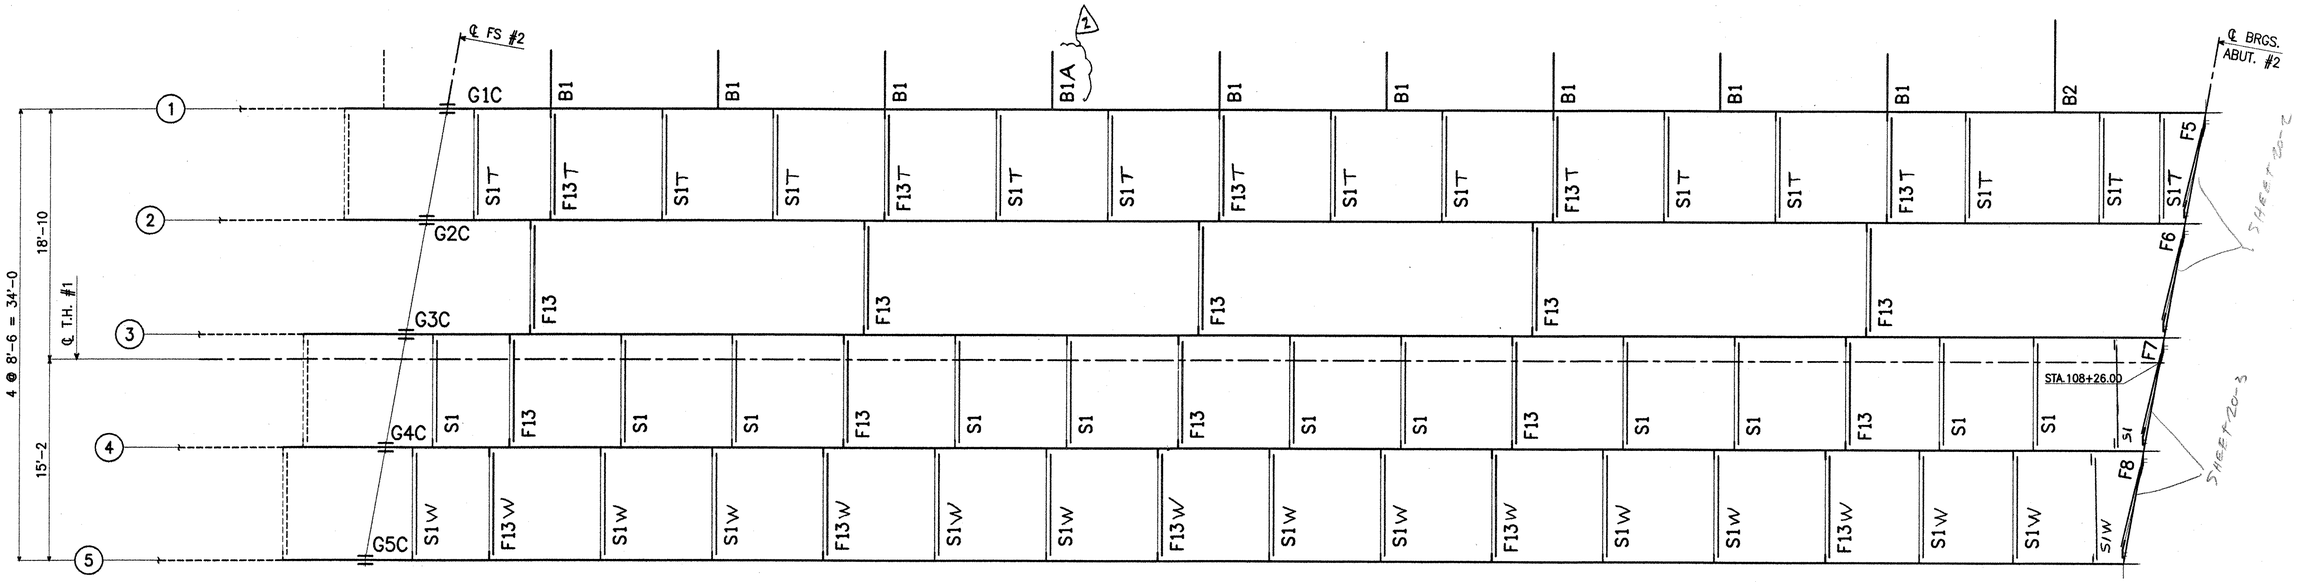

SPAN 2

ERECTION PLAN

2-14-02

ITEM NO. 506.55			BR. NO. 3	PROJ. NO. BRZ 1444(22)	
TITLE: ERECTION PLAN					
APPROVED: 9-5-01			National Eastern Corporation Plainville, Connecticut		
PRINT DIST.					
5	4-7-01	APPR.			
ORIG.	9-5-01	FAB.			
5	7-13-01	APP	JOB: T.H. 1 OVER THE WHITE RIVER ROYALTON, VERMONT		
5	8-24-01	APP			
5	11-19-01	APP			
11	11-19-01	FAB			
5	1-28-02	APP	CUSTOMER: BECK & BELLUCCI, INC.		
11	1-28-02	FAB	DESIGNER: VERMONT AGENCY OF TRANSPORTATION		
			WORK ORDER NO.	DRAWING NO.	REV.
CHECKED	TS	3/01	15873	E2	2
DRAWN	AV	3/01			

REVISED

FOR APPROVAL

RECEIVED
CK'D BY CPW OK'D BY
JAN 30 2002
RESUBMIT APPROVED
BY CPW DATE 2/11/02

2 MK B1A 1-28-02 JCM
1 PC MKS 11-12-01 JCM

Rec'd 2-14-02

WS 4, 12-21, 20-7, 99-1