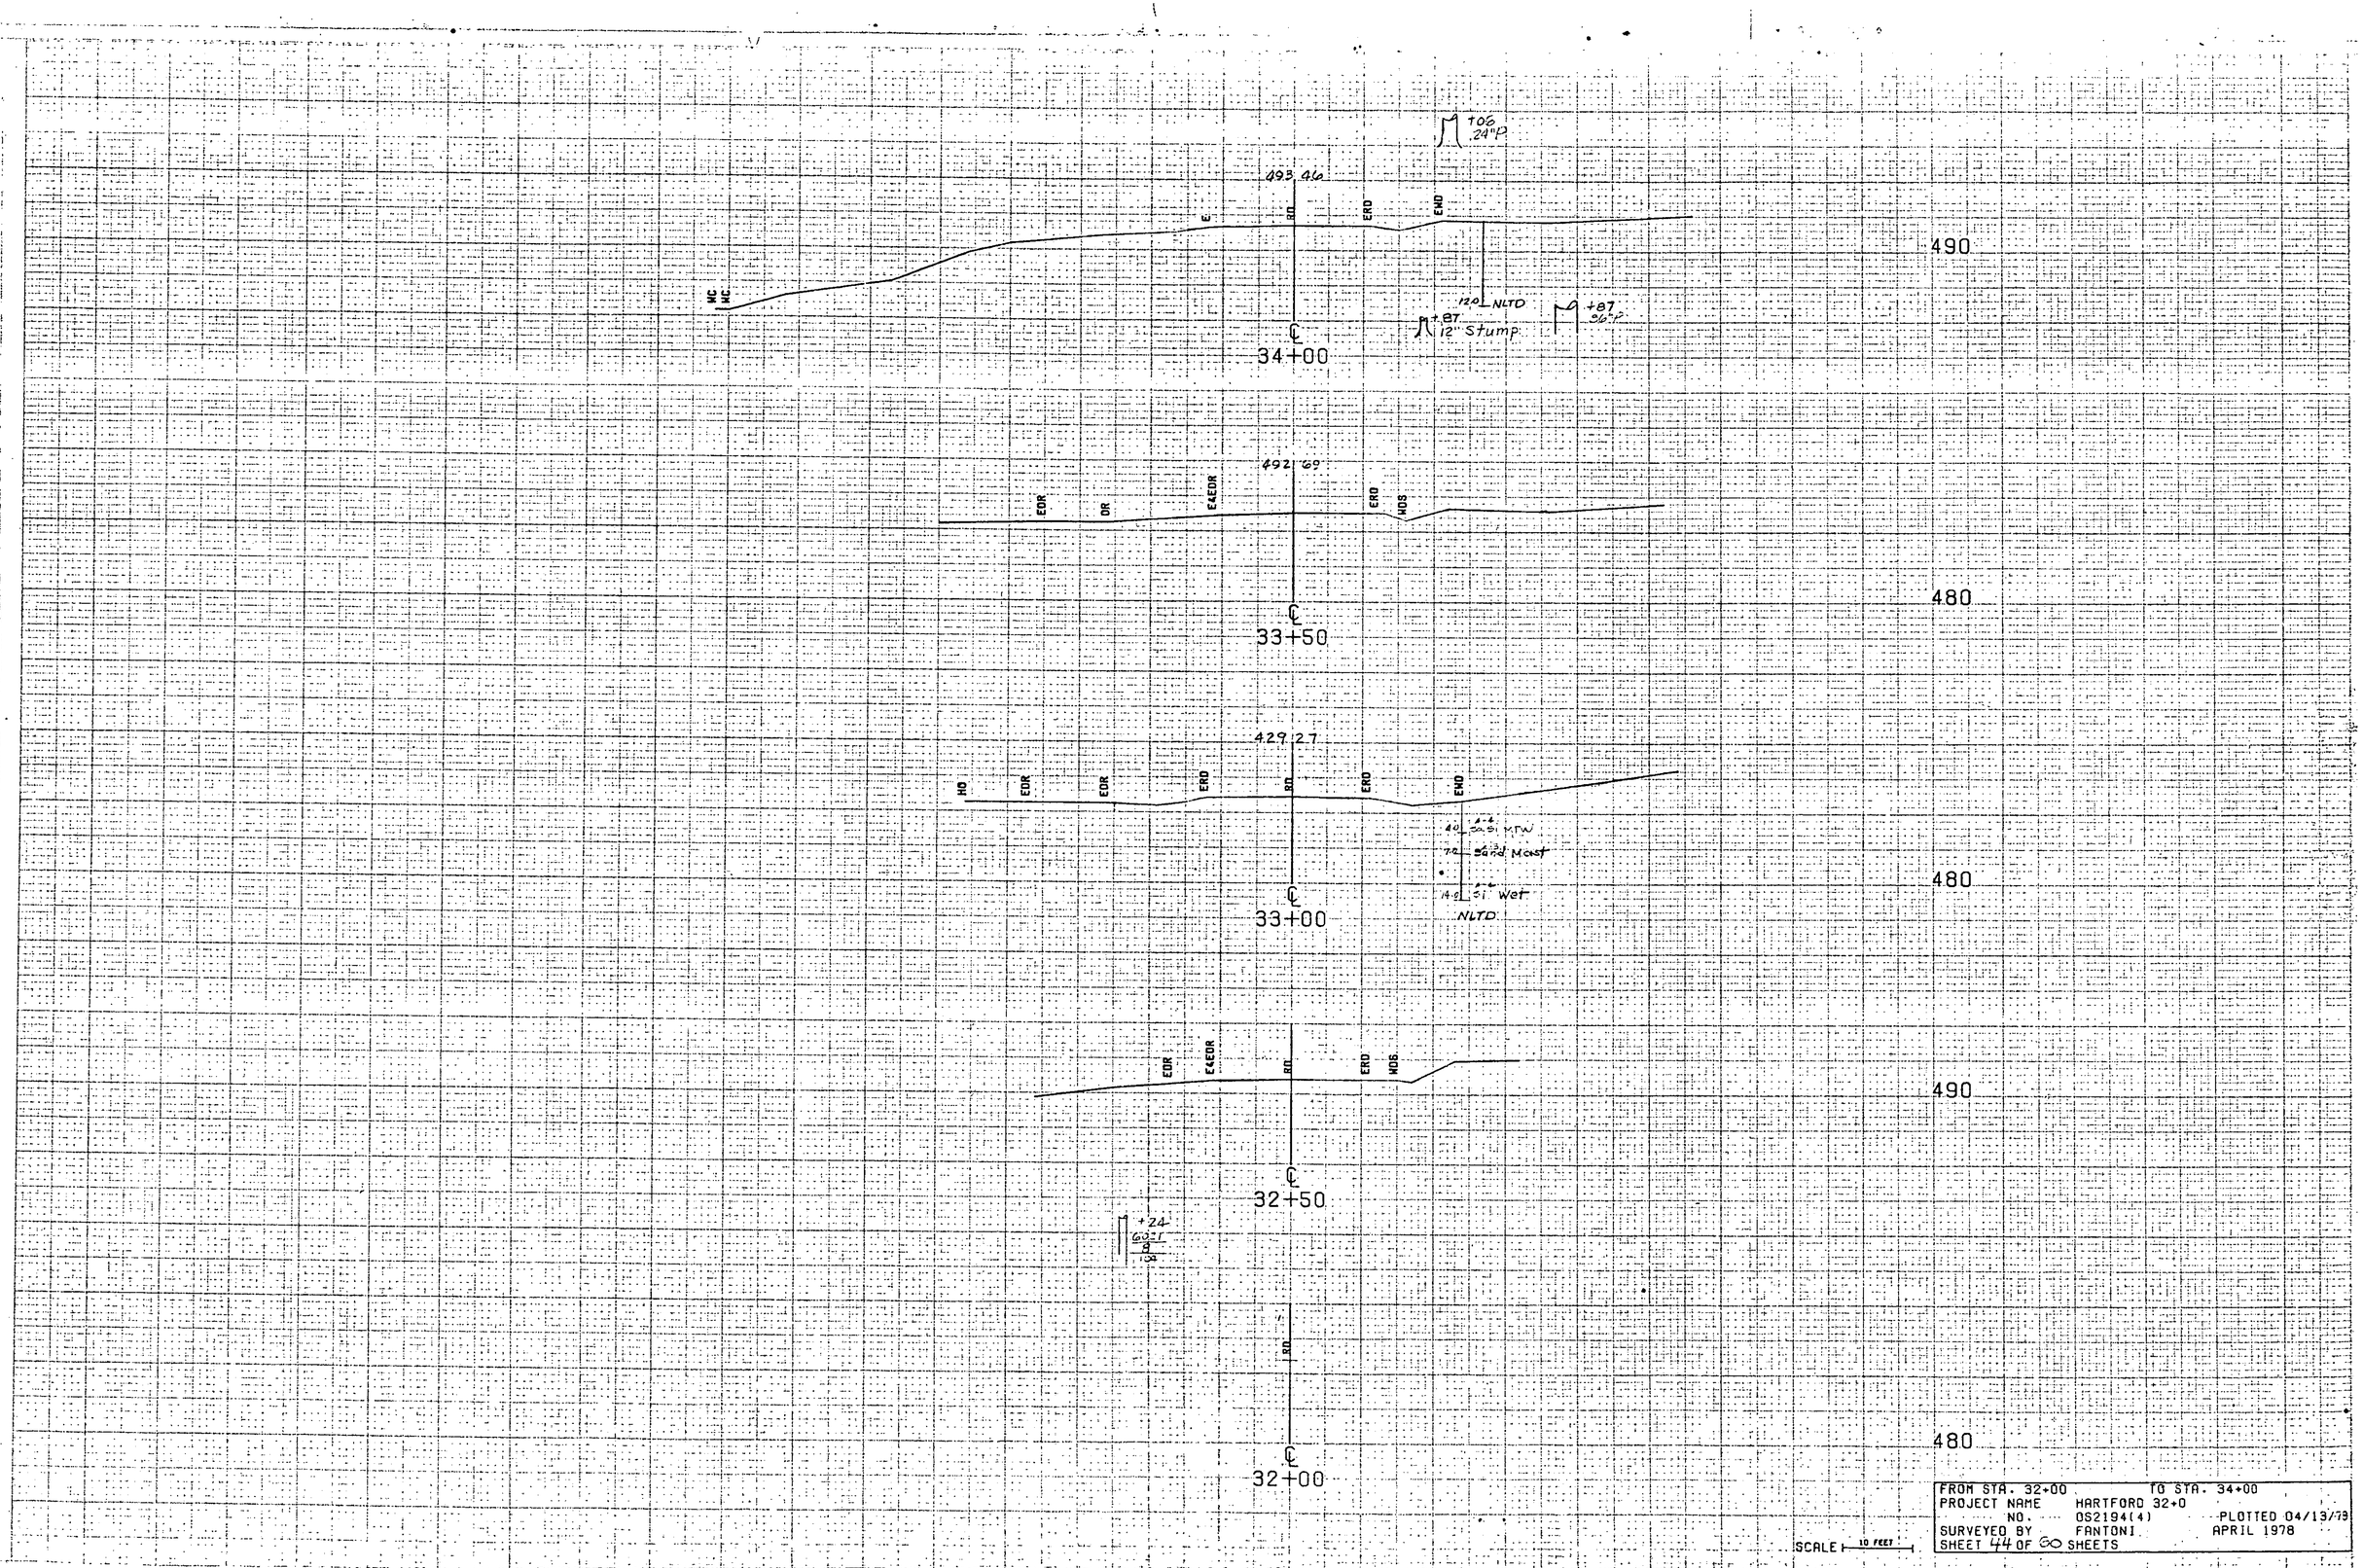

FROM STA. 32+00	TO STA. 34+00	
PROJECT NAME	HARTFORD 32+0	
NO.	052194(4)	PLOTTED 04/13/78
SURVEYED BY	FANTONI	APRIL 1978
SHEET 44 OF 60 SHEETS		