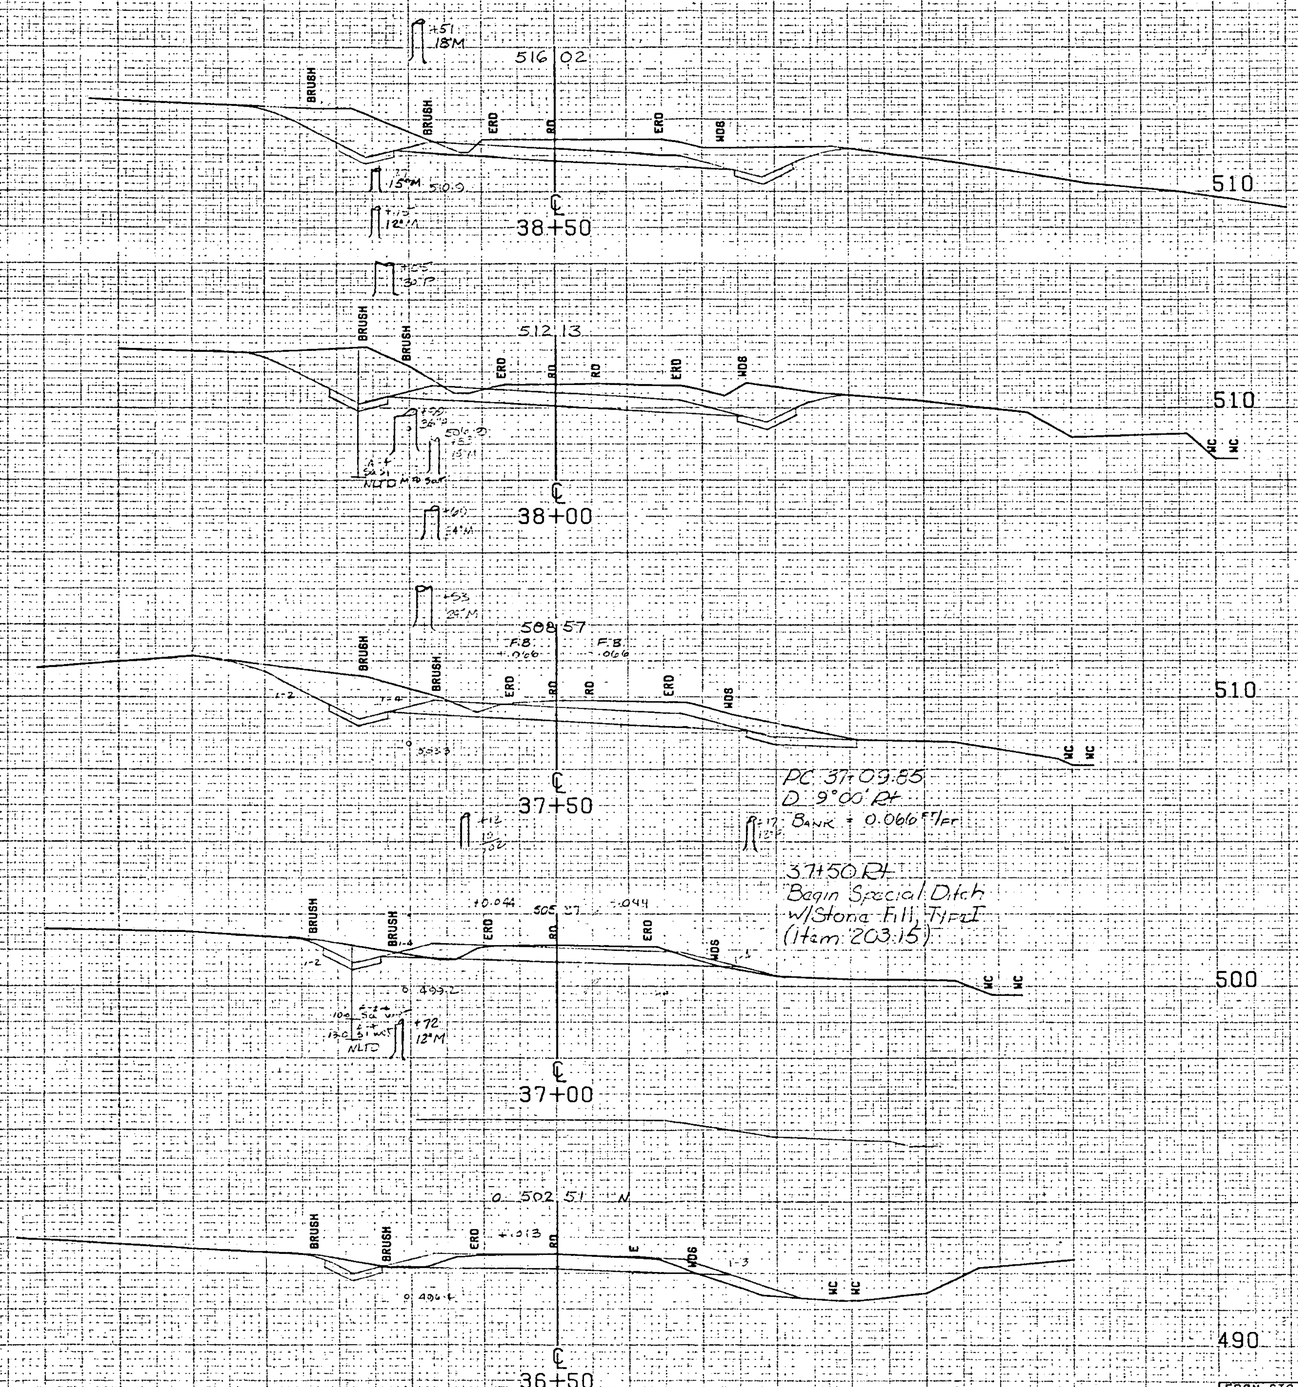

SCALE 10 FEET

FROM STA. 36+50		TO STA. 38+50
PROJECT NAME	HARTFORD 32+0	
NO.	OS2194(4)	PLOTTED 04/13/78
SURVEYED BY	FANTONI	APRIL 1978
SHEET 46 OF 60 SHEETS		