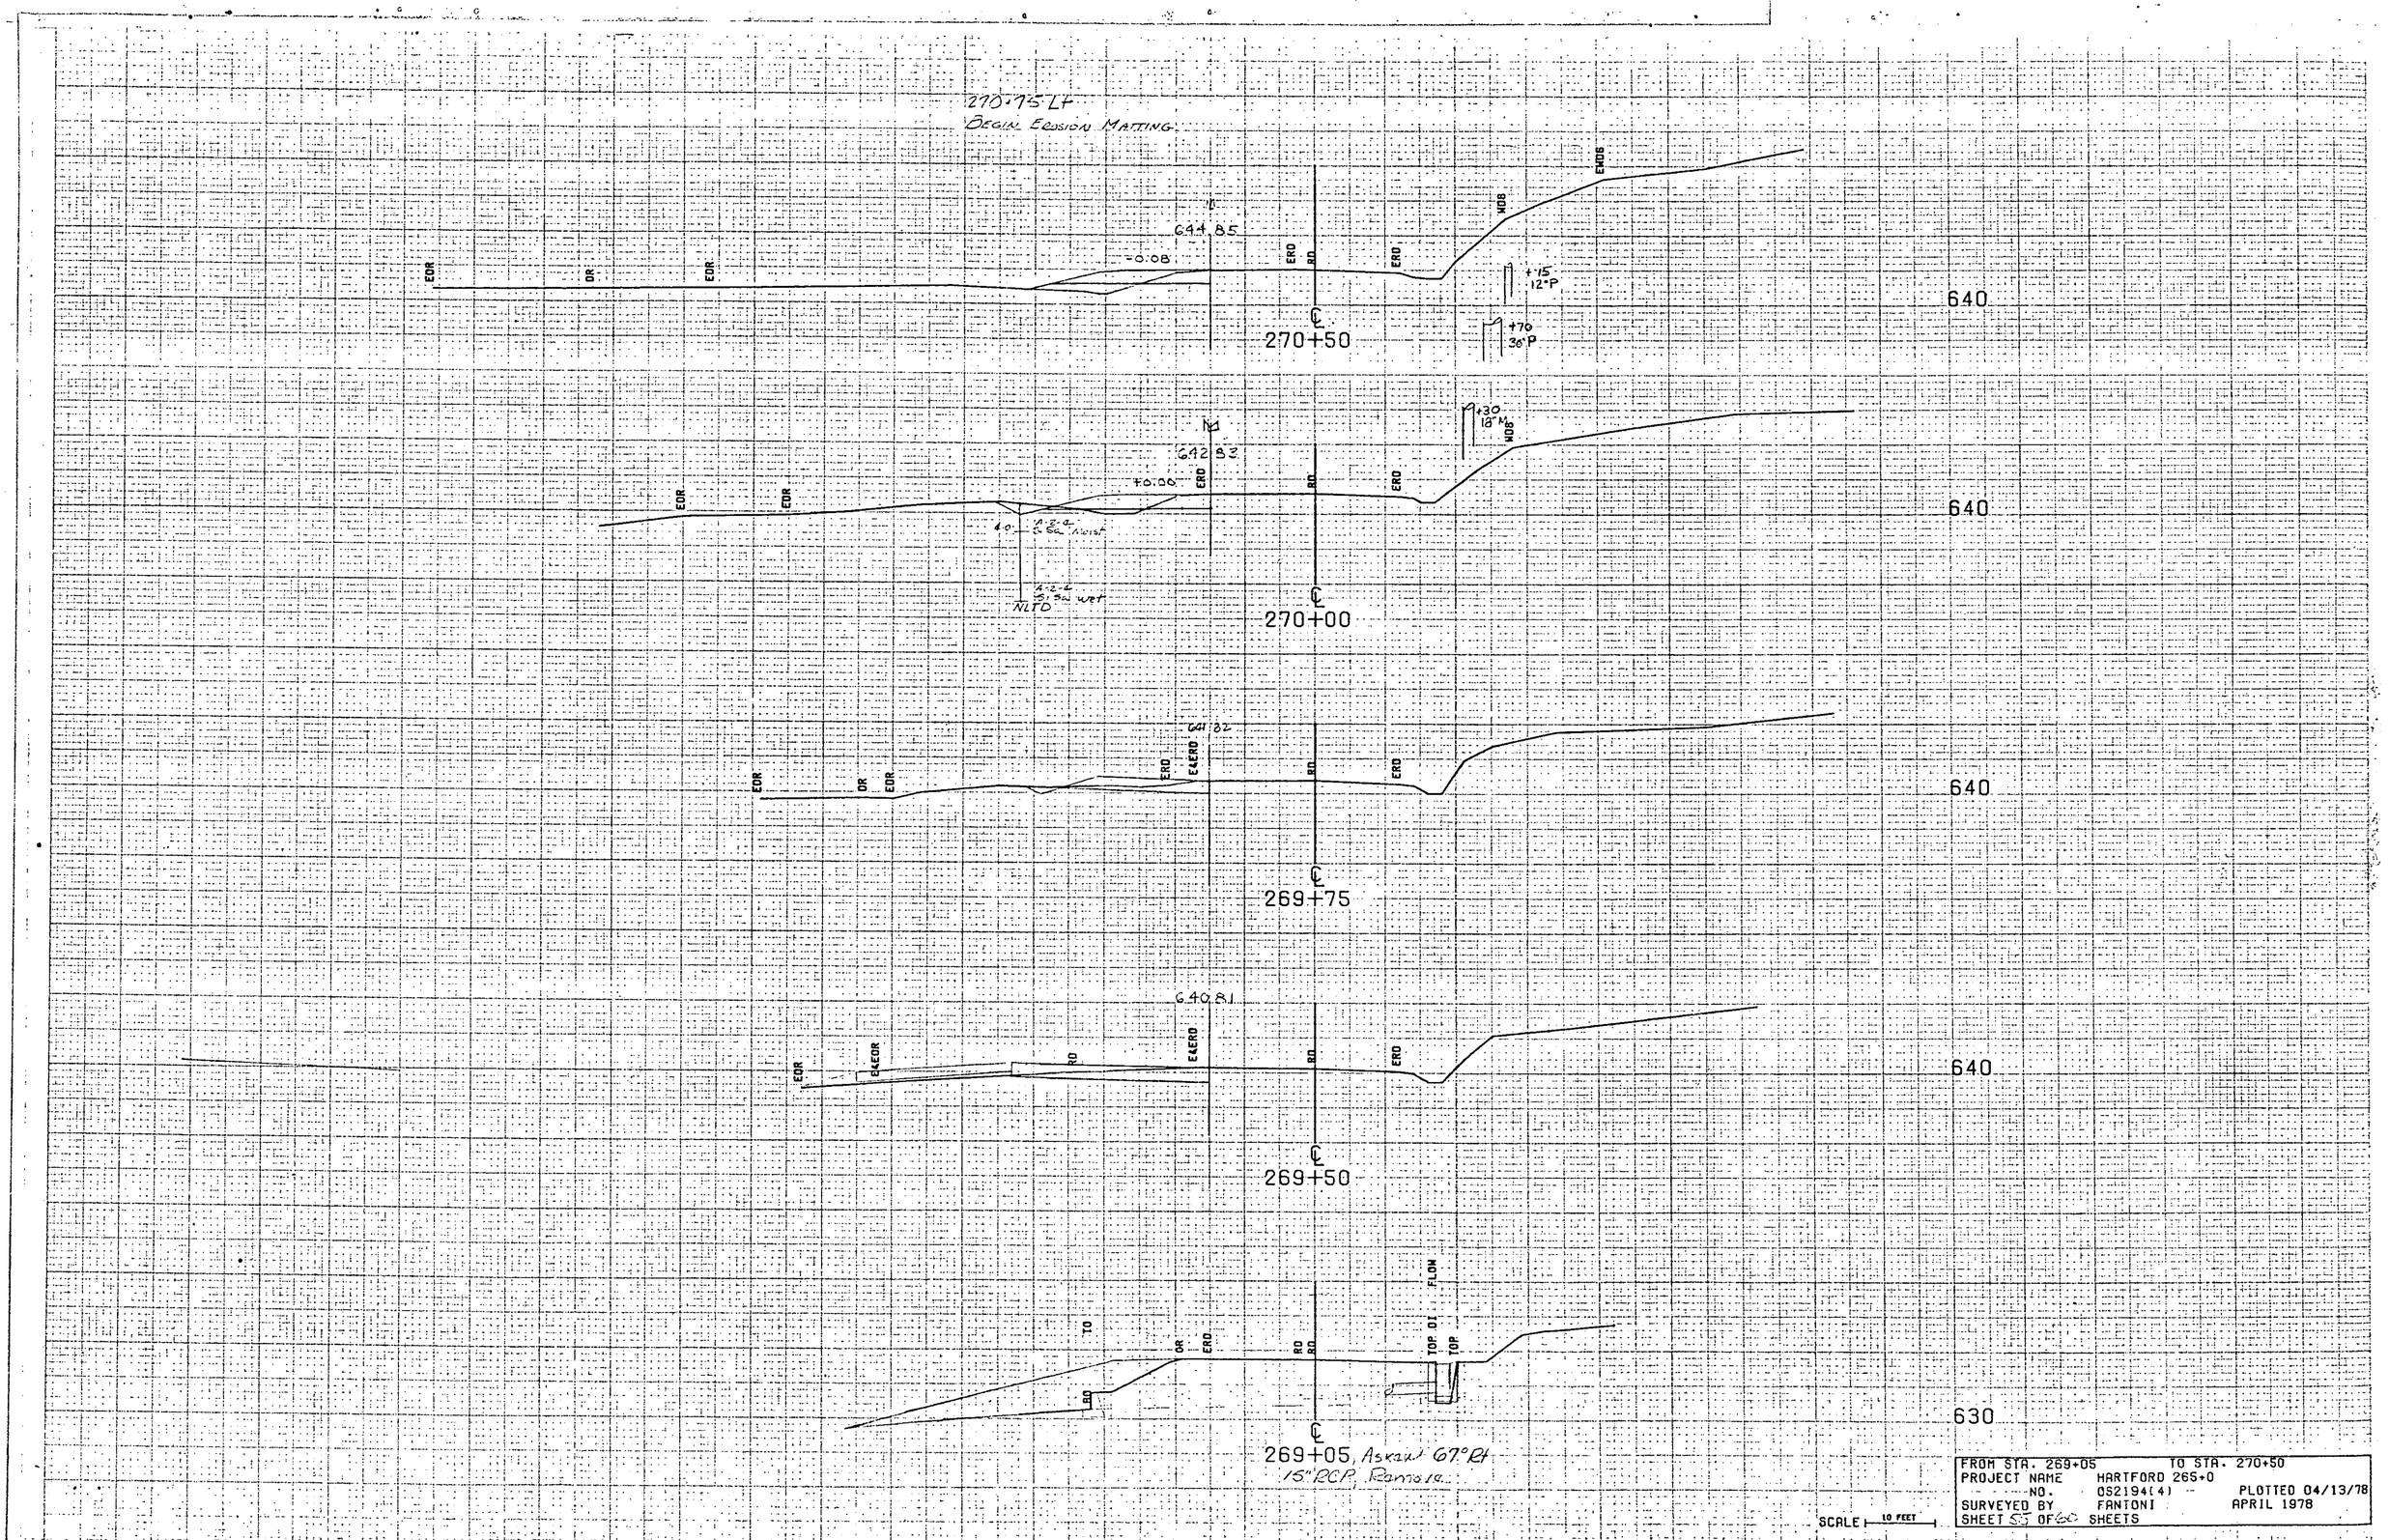

FROM STA. 269+05	TO STA. 270+50	
PROJECT NAME	HARTFORD 26S+0	
NO.	052194(4)	PLOTTED 04/13/78
SURVEYED BY	FANTONI	APRIL 1978
SHEET 55 OF 60 SHEETS		