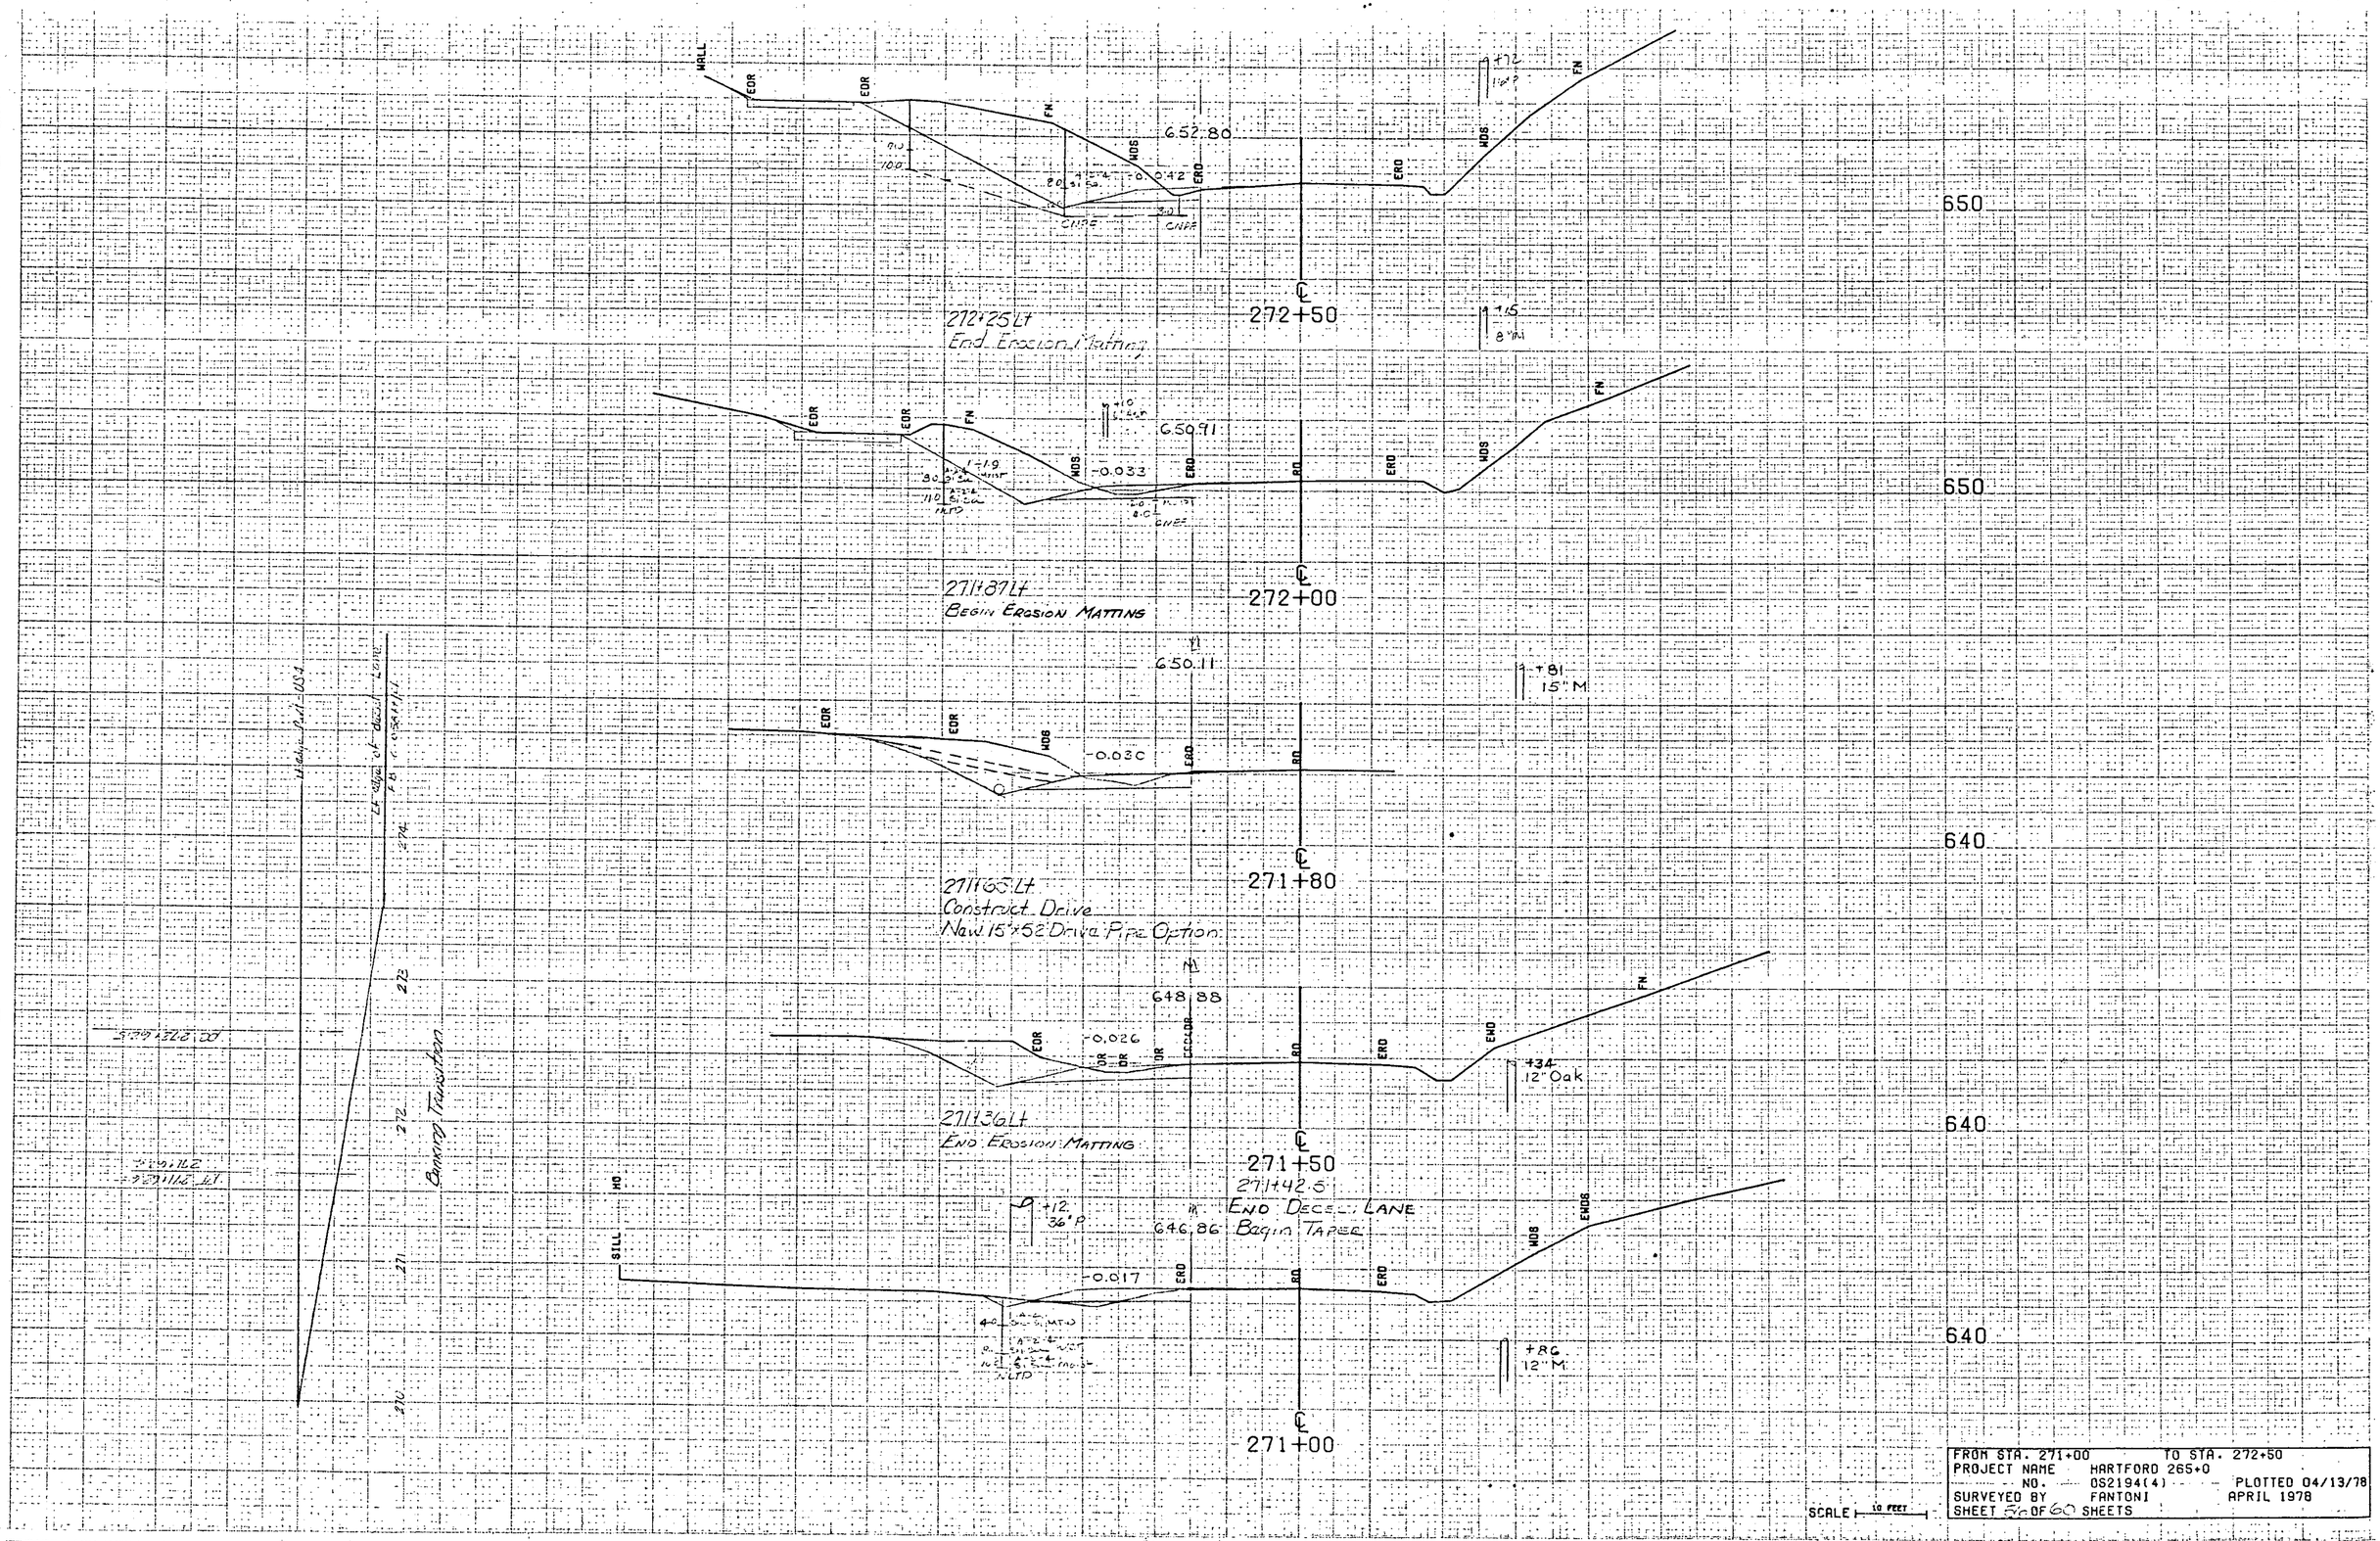

SCALE 10 FEET

FROM STA. 271+00		TO STA. 272+50
PROJECT NAME	HARTFORD 265+0	
NO.	OS2194(4)	PLOTTED 04/13/78
SURVEYED BY	FANTONI	APRIL 1978
SHEET 56 OF 60 SHEETS		