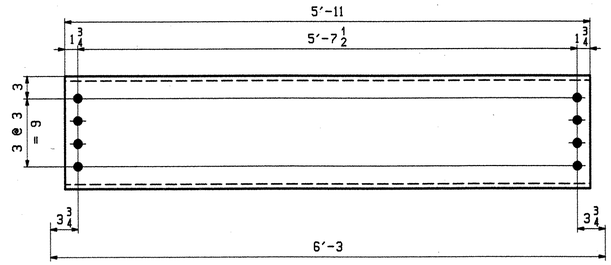

6 - INT DIAPHRAGMS - 3D1

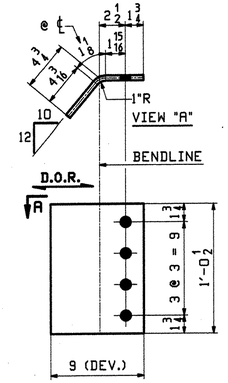

DETAIL - pa3

ABM INFO		SHIP	BILL OF MATERIAL					JOB NO.	DRAWING NO.	REV.
								366	3	
PAGE	LINE	MARK	QTY	MARK	MATERIAL	LENGTH FT	LENGTH INCHES	REMARKS	WT	PROCUREMENT NOTES
					INT DIAPHRAGMS					
1	J	3D1	6		C 15x33.9	5	11		201	
		3D2	2		END DIAPHRAGMS				301	
		3D3	1		END DIAPHRAGM				301	
		3D4	2		END DIAPHRAGMS				301	
		3D5	1		END DIAPHRAGM				301	
1	K		6	a3	C 15x33.9	7	11 1/8			
1	L		12	pa3	PL 1/2 x 12 1/2	0	9	BENT		

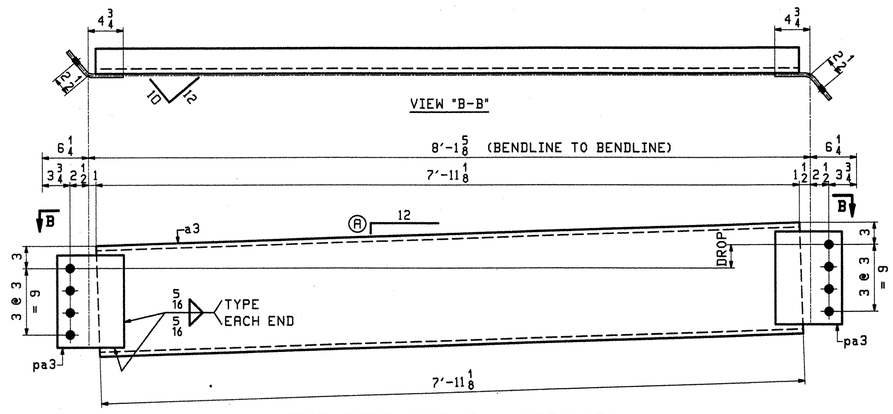


AT ABUT 2

MARK "A"	QTY	DROP	Ⓐ	
3D2	2	1 1/2	3/16	LINES 1-2 & 2-3
3D3	1	15/16	1/8	LINE 3-4

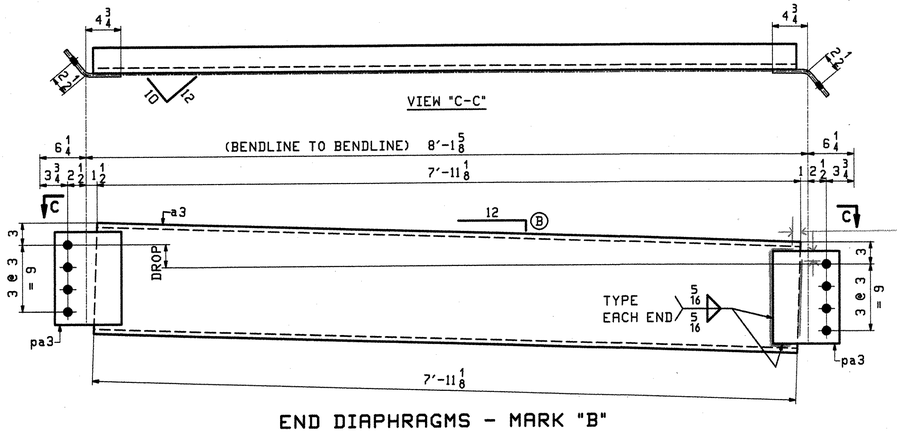

STOP WELD 1/4 (min) TO 1/2 (max) (TYP)

END DIAPHRAGMS - MARK "B"

AT ABUT 1

MARK "B"	QTY	DROP	Ⓑ	
3D4	2	3	3/8	LINES 1-2 & 2-3
3D5	1	2 3/8	5/16	LINE 3-4

RECEIVED
OK'D BY JSS OK'D BY JKS
APR 30 2008
RESUBMIT APPROVED as noted
BY CAW DATE 5/7/08

NOTES:
1. FOR GENERAL NOTES SEE DRAWING GN1.!
2. D.O.R. DENOTES DIRECTION OF MILL ROLLING

REV.	DATE	REMARKS	DWN	CHK	APVL	SHOP
0					4-22-08	

MATERIAL:	SURFACE PREP. & PAINT:	HOLES:	SHOP BOLTS:
M270-50W	AS NOTED ON GN1	15/16 ø	NONE

DESCRIPTION: DIAPHRAGMS

CASCO BAY STEEL STRUCTURES, INC.
75 SPRING HILL ROAD SACO, MAINE 04072
PHONE (207) 282-7360 FAX. (207) 282-1179
TENSOR 2775

STRUCTURE: TH 8 OVER MILL BROOK BRIDGE NO. B25 COUNTY OF WINDSOR	DRAWN: JTB	DATE: 04/10	
	CHKD: JF	DATE: 04/18	
LOCATION: TOWN OF READING	JOB NO.	DWG NO.	
PROJ NO. BRZ 1444(23)	366	3	
CUSTOMER: VERMONT A.O.T.		REV. △	

062 55

JTB Sat Apr 19 12:40:51 EDT 2008 /users/jobs/2775/3 - Rev0