LEGEND

- boundary line/r.o.w.
- road/parking (w/ surface label)
- drive (w/ surface label)
- tree line/hedge row
- 1 foot contour
- 5 foot contour
- stone wall
- uc — underground electric
- o/h — overhead utility
- ut — underground telephone
- di — ditch line/drainage
- sd — storm drain
- w — water main
- sign
- light pole
- utility pole
- guy
- gate valve
- curb stop
- hydrant
- iron pipe found
- catch basin
- sewer manhole
- trees (size and type noted)
- shrub, bush (type noted)
- stump
- traverse station
- TBM 1 — temporary bench mark
- 100 — PROPOSED GRADES (REFER TO VAOT PLANS)
- WATER MAIN (SIZE NOTED)

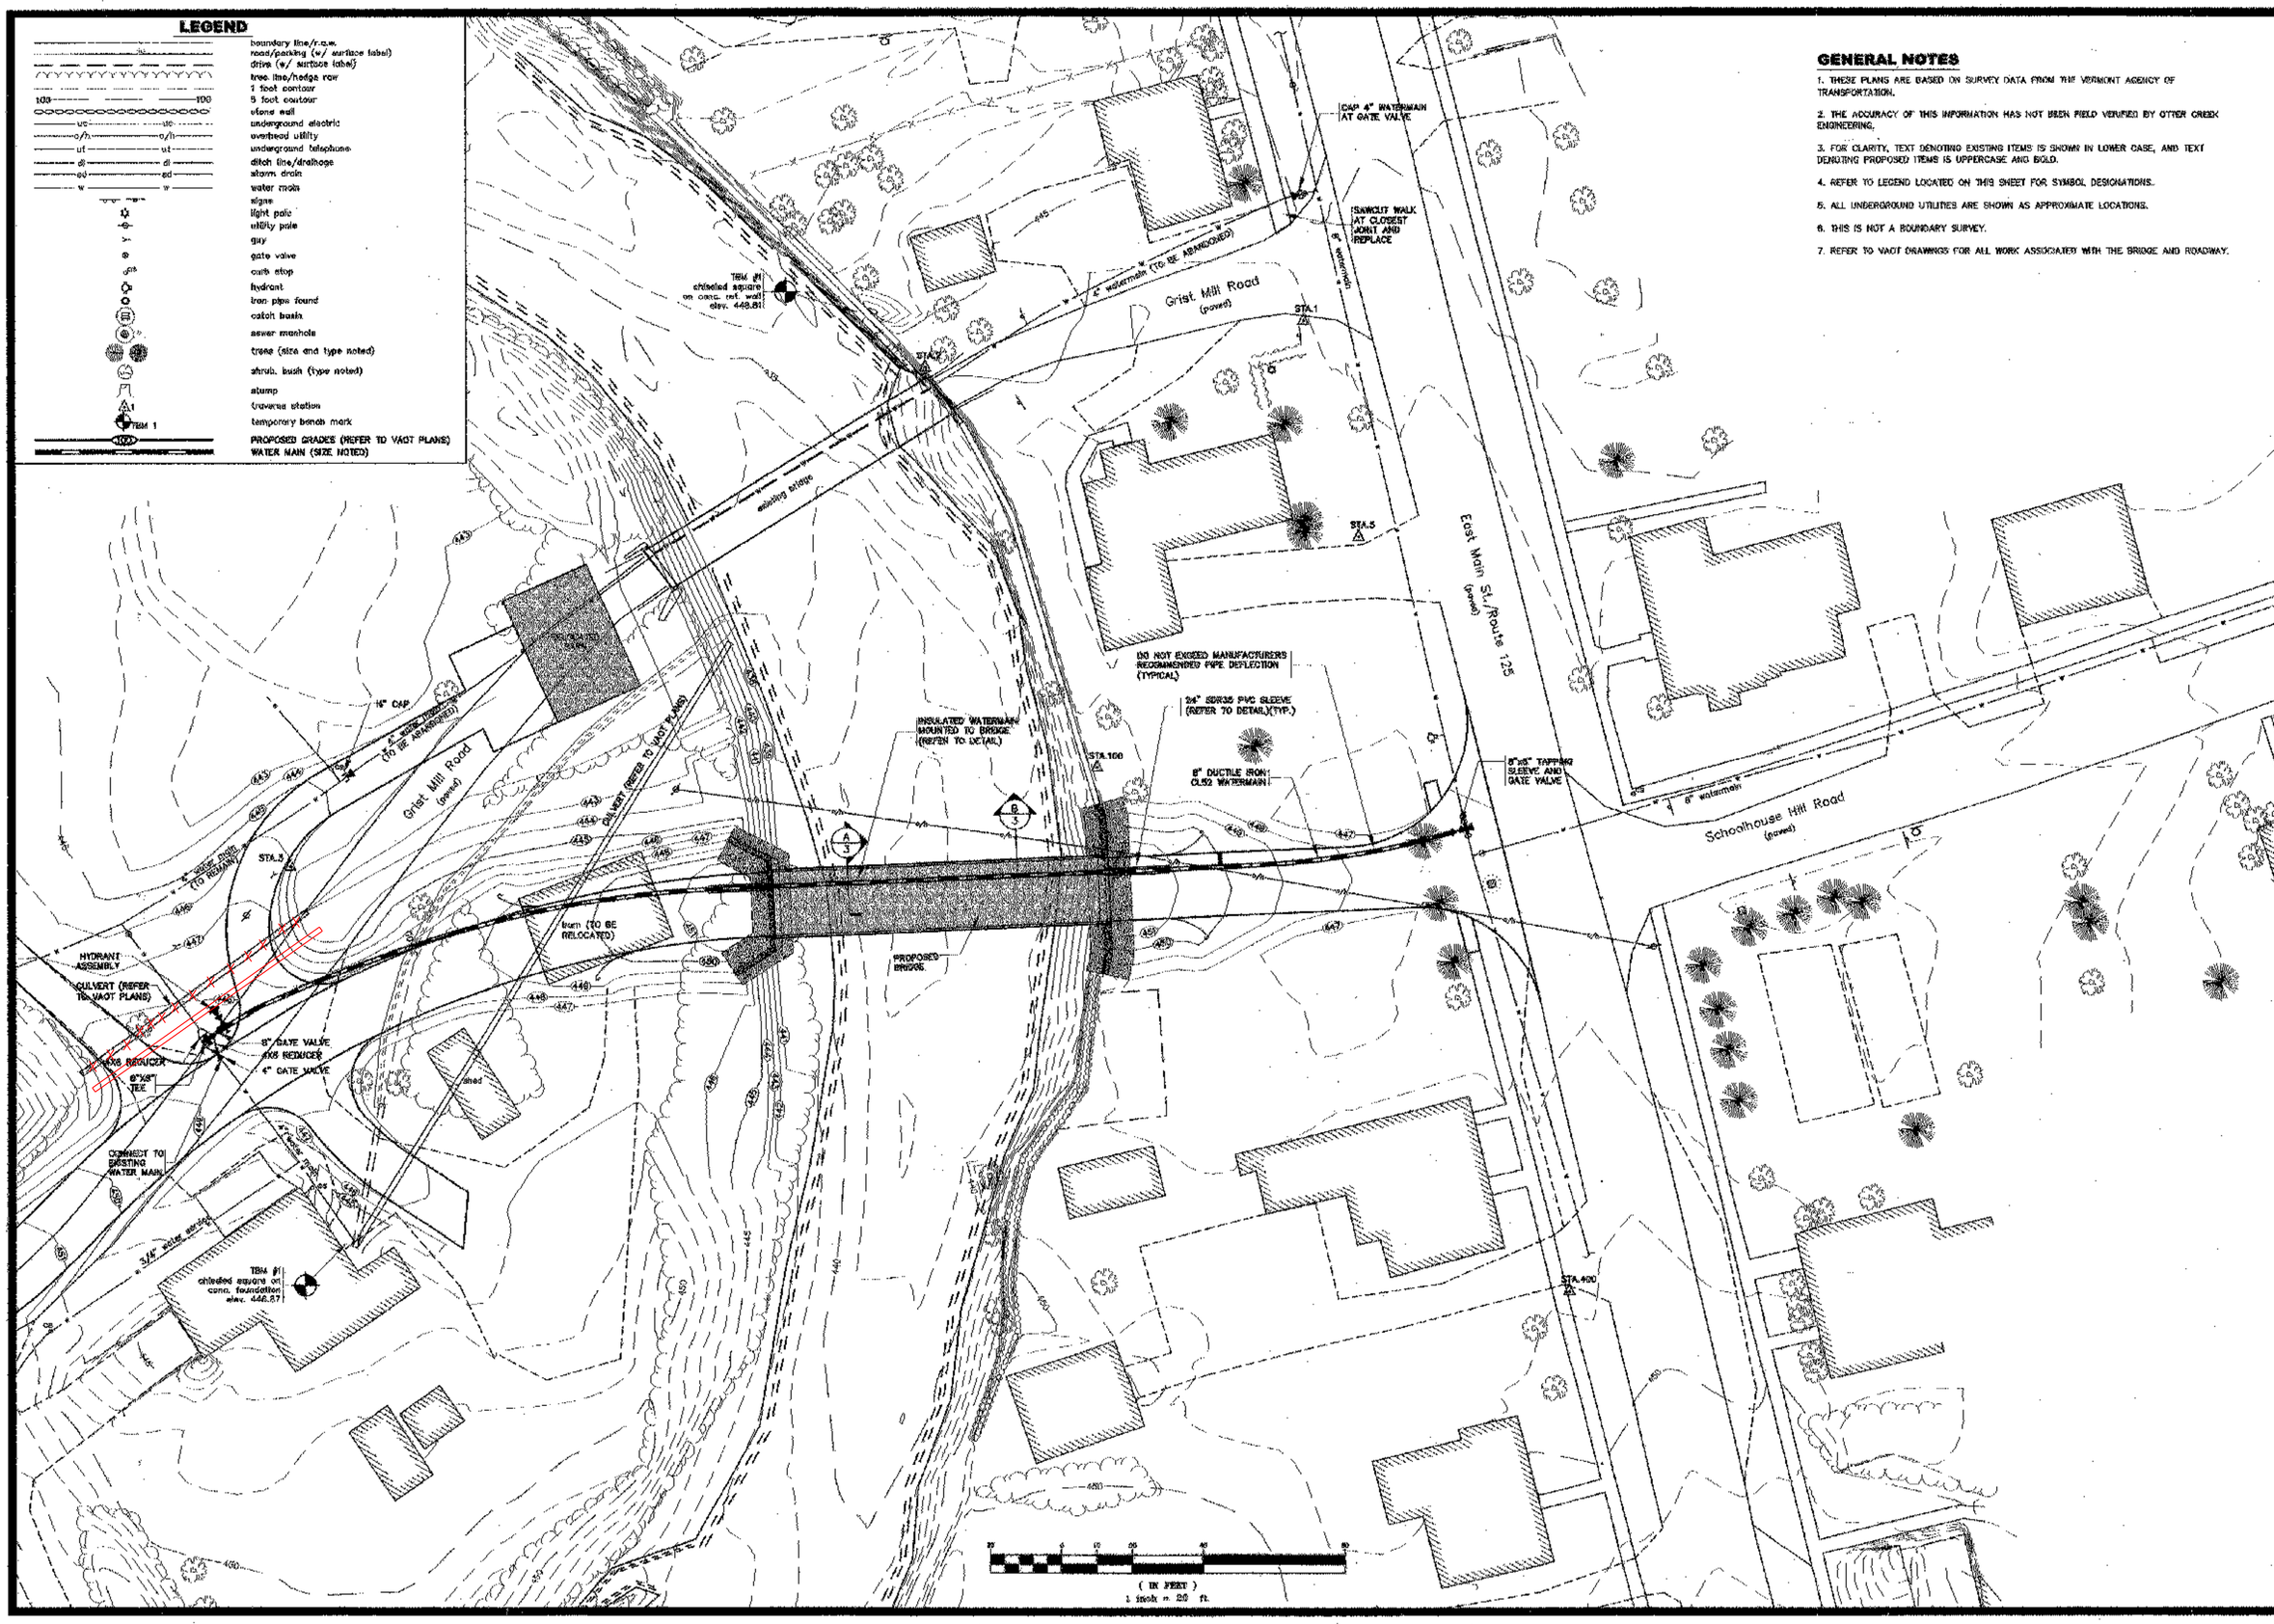

GENERAL NOTES

1. THESE PLANS ARE BASED ON SURVEY DATA FROM THE VERMONT AGENCY OF TRANSPORTATION.
2. THE ACCURACY OF THIS INFORMATION HAS NOT BEEN FIELD VERIFIED BY OTTER CREEK ENGINEERING.
3. FOR CLARITY, TEXT DENOTING EXISTING ITEMS IS SHOWN IN LOWER CASE, AND TEXT DENOTING PROPOSED ITEMS IS UPPERCASE AND BOLD.
4. REFER TO LEGEND LOCATED ON THIS SHEET FOR SYMBOL DESIGNATIONS.
5. ALL UNDERGROUND UTILITIES ARE SHOWN AS APPROXIMATE LOCATIONS.
6. THIS IS NOT A BOUNDARY SURVEY.
7. REFER TO VAOT DRAWINGS FOR ALL WORK ASSOCIATED WITH THE BRIDGE AND ROADWAY.

OTTER CREEK ENGINEERING, INC.
102 Court Street
P.O. Box 605
Middlebury, VT 05753
Telephone: 802-382-0522
Fax: 802-382-0540
E-mail: ottercre@ottercreek.com

THESE DRAWINGS SHALL NOT BE ALTERED IN ANY WAY WITHOUT THE WRITTEN APPROVAL OF THE ENGINEER. ANY REVISIONS SHALL BE MADE BY THE ENGINEER AND NOTED IN THE REVISION BLOCK.
© 1999
OTTER CREEK ENGINEERING, INC.

STAMP AND SIGNATURE:

STATE OF VERMONT — WILLIAM E. DEAN — REGISTERED PROFESSIONAL ENGINEER

MAGNETIC NORTH

EAST MIDDLEBURY FIRE DISTRICT NO. 1
GRIST MILL BRIDGE
MIDDLEBURY BRZ 1445(19)
WATER MAIN REPLACEMENT
MIDDLEBURY, VERMONT

BID

DATE ISSUED: 11/30/99

REVISIONS:
1. REVISED PER AOT LETTER 03-29-01 JL

DRAWN BY: JL
CHECKED BY: PD
SCALE: 1"=20'
PROJECT NO.: 072-001
CADD FILE: 072-001

TITLE:
SITE PLAN

DRAWING NO.
1

SHEET: 18 OF 55

Z:\Projects\Drawings\Client 07-08\072-East Middlebury\072-001 GRIST MILL BRIDGE WATER LINE\072-001.dwg Thu Mar 06 12:35:14 2003