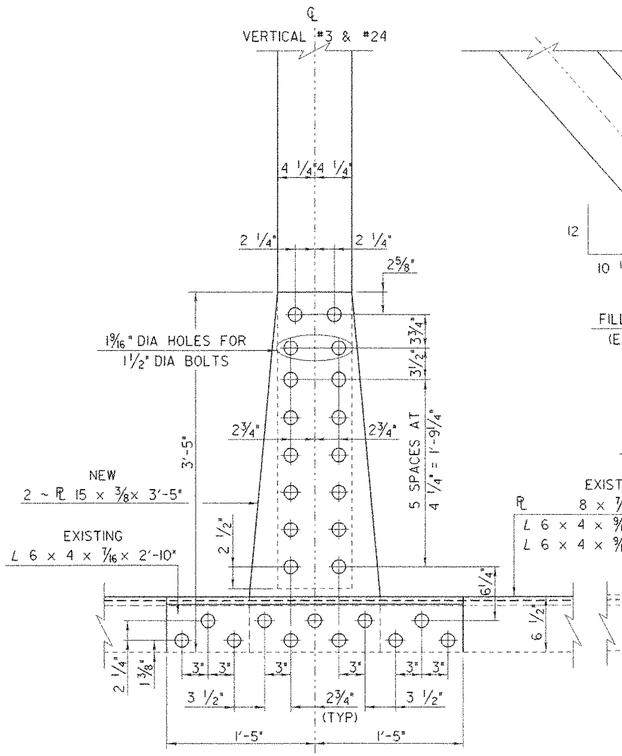

VERTICAL (3 & 24) CONNECTION DETAIL

SCALE: 1 1/2" = 1'-0"

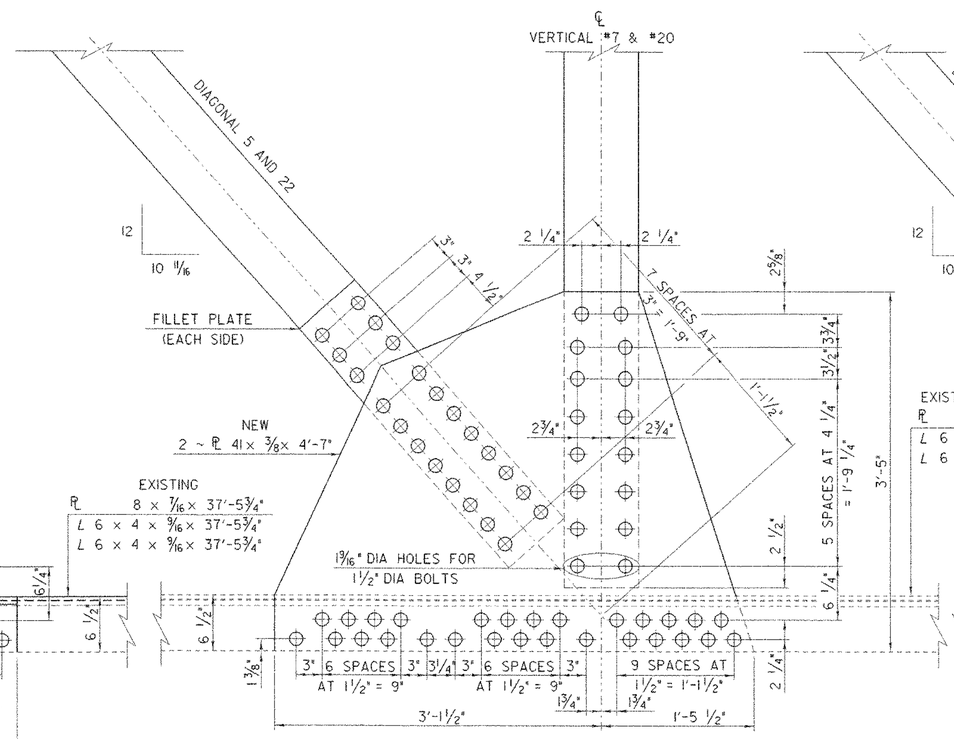

VERTICAL (7 & 20) CONNECTION DETAIL

SCALE: 1 1/2" = 1'-0"

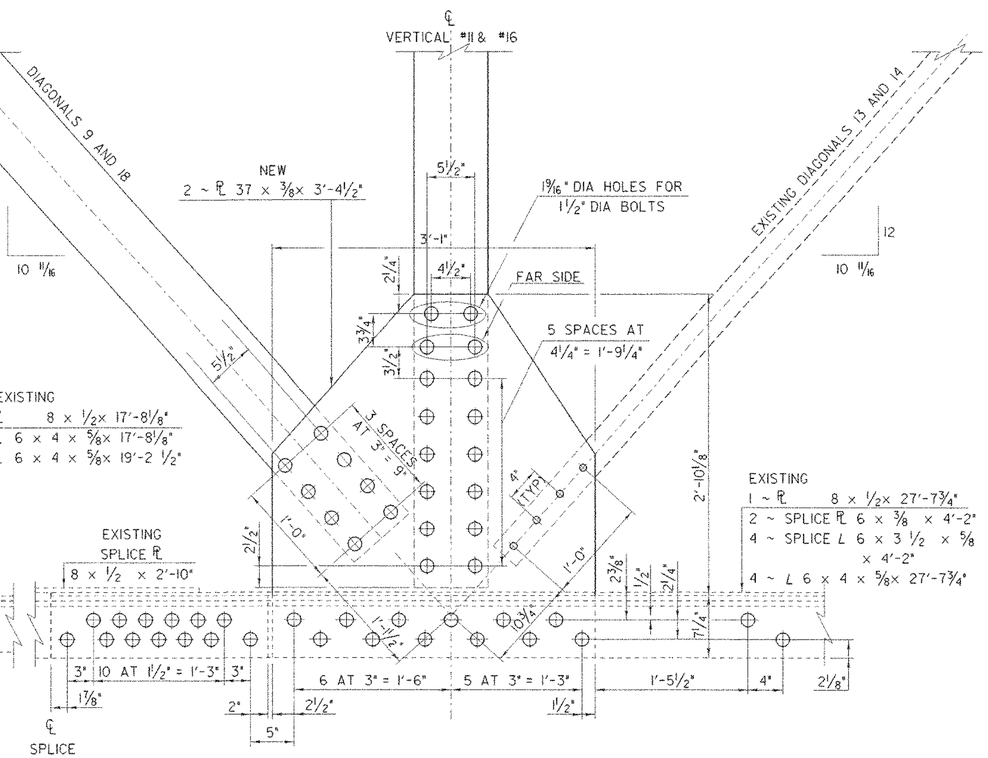

VERTICAL (11 & 16) CONNECTION DETAIL

SCALE: 1 1/2" = 1'-0"

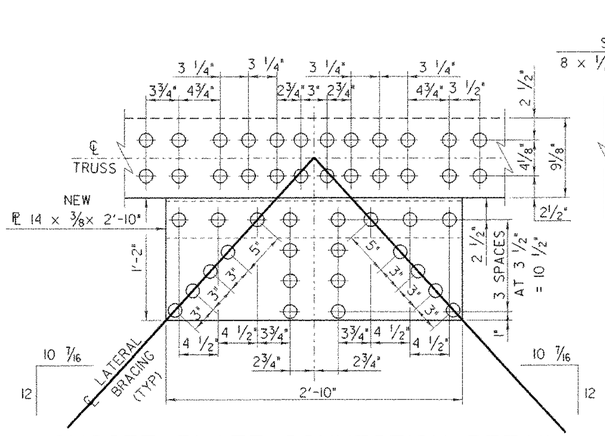

GUSSET PLATE CONNECTION DETAIL

SCALE: 1 1/2" = 1'-0"

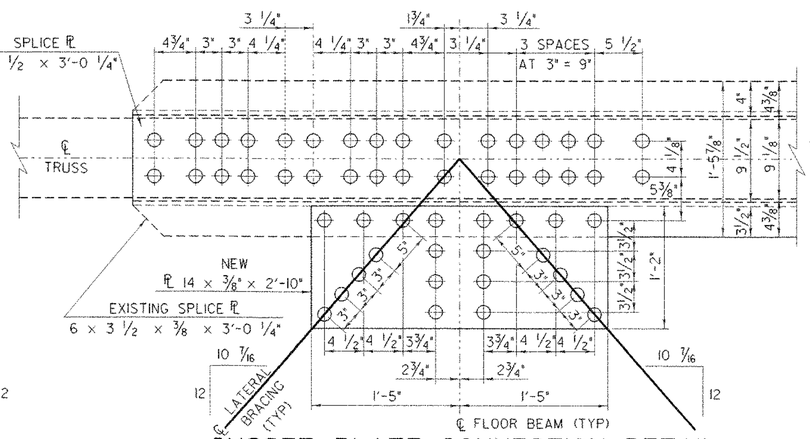

GUSSET PLATE CONNECTION DETAIL

SCALE: 1 1/2" = 1'-0"

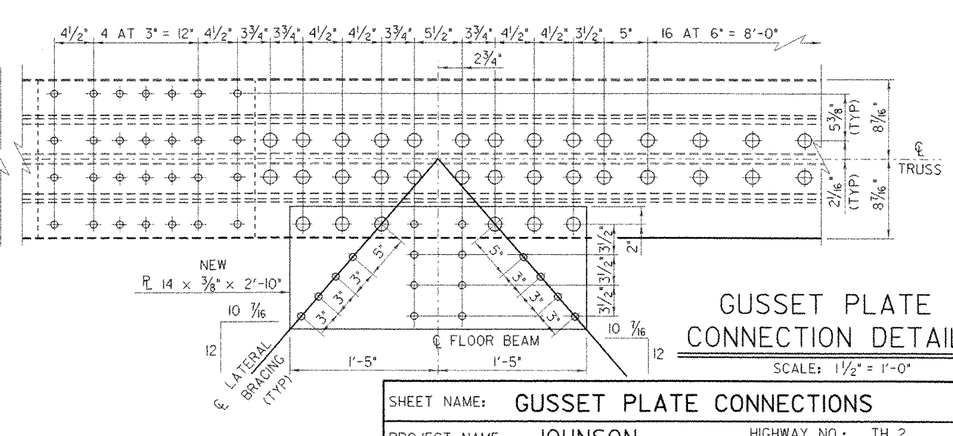

GUSSET PLATE CONNECTION DETAIL

SCALE: 1 1/2" = 1'-0"

NOTES:

1. SEE SHEETS 26, 27 OR 42 FOR TRUSS MEMBER REFERENCES.
2. ALL GUSSET PLATES USED TO ATTACH FLOOR BEAMS TO THE TRUSS (UPSTREAM AND DOWNSTREAM) SHALL BE REPLACED.

SHEET NAME: GUSSET PLATE CONNECTIONS	
PROJECT NAME: JOHNSON	HIGHWAY NO.: TH 2
PROJECT NUMBER: BHO 1448(18)	BRIDGE NO.: 6
	OVER: THE LAMOILLE RIVER
FILE NAME: /strl/90j067/sj067trs.dgn	PLOT DATE: 02-SEP-2005
PROJECT MANAGER: R. WHITCOMB	DRAWN BY: J.GILMORE
DESIGNED BY: C. MEUNIER	IPARM NAME: sc067gpc.i
BRIDGE SHEET NUMBER:	SHEET 28 OF 73