552 = 72175

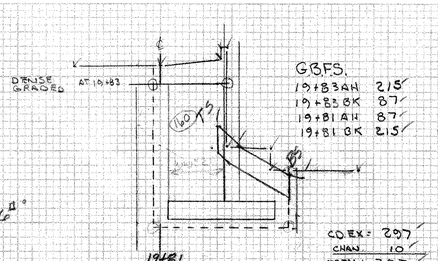

19+83 END DENSE GRADED

WW# 2 - 19+81.10 '83

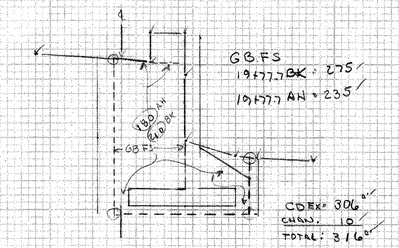

19+78.5 ℄

19+77.7 BEGIN FOOTING

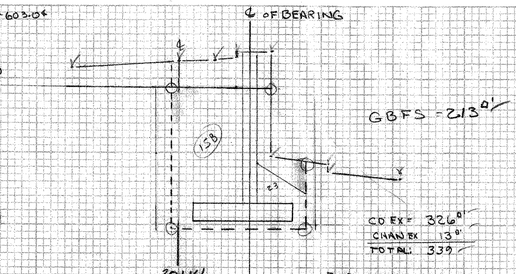

END DENSE GRADED

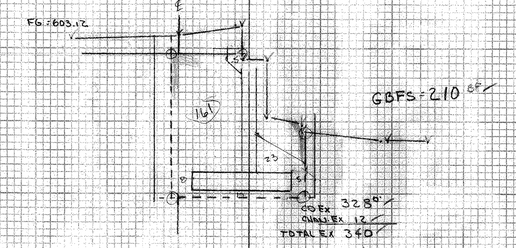

Stone Fill, Type III

STA	AREA	DIST	VOL (cy)
19+65	33		
		10	12.22
19+75	33		
		6	7.67
19+81	36		
		19	23.22
20+00	30		
		19	19.00
20+19	24		
		2	1.78
20+21	24		
		10	10.00
20+31	30		

TOTAL 73.89 cy 12/6/05 DAT

CHK 12-20-05

TO BOOK #3 PAGE 92

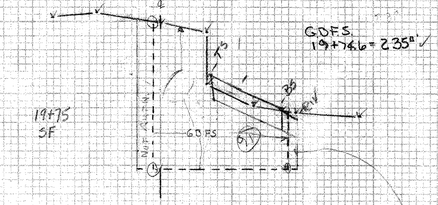

NOTE: NO CHAN. EX. ITEM IN CONTRACT.

PAY AS C.D. EXCAV.

12-20-05

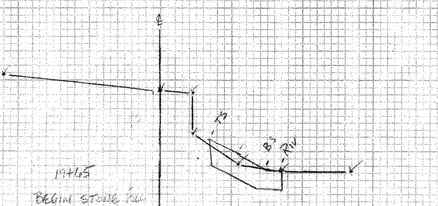

S.F. 12-20-05

Correction 1/23/06 DAT

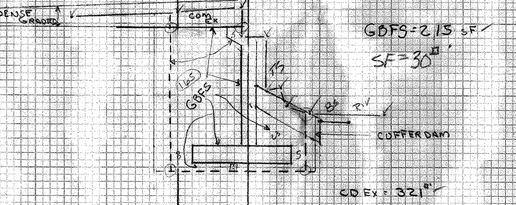

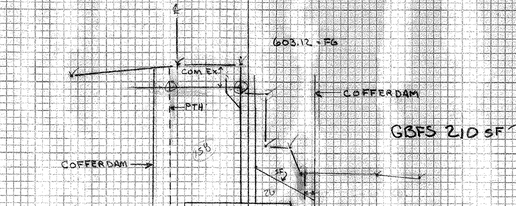

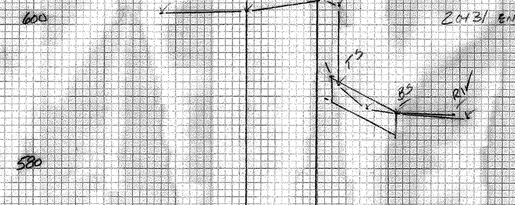

Excavation for SF outside Cofferdam

STA	AREA	DIST	VOL (cy)
19+65	26		
		9.6	9.24
19+74.6	26		
		10	8.15
20+21	24		
20+31	20		

TOTAL 17.39 cy 12/6/05 DAT

CHK 12-20-05

TO BOOK #1 PAGE 27

PAY AS TRENCH EXCAV.

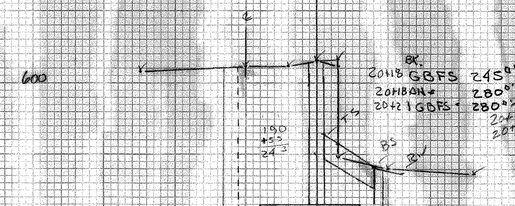

GBFS 12/6/05 DAT

BARRE CITY HDP 9281(1)

ABUTMENT "1"

COFFER DAM EXCAVATION

SHEET #1

060

HIGHWAY FEDERAL AID SHEET
PLATE 2-FULL CROSS SECTION-FULL LINE
VERMONT PRINTING
PRINTED IN U.S.A.

1" = 10'