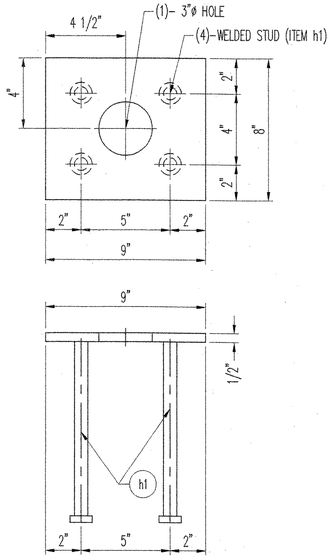

EMBEDDED PLATE ASSEMBLY '3P1'

(5) REQ'D

(NO GALVANIZING REQ'D)

MK	QTY.	DESCRIPTION	MATERIAL	LENGTH	REMARKS	PART NO.
		LOOSE ITEMS:				
3P1	5	EMBEDDED PLATE ASSEMBLY			B	
p1	5	PL 1/2 x 8	A36	0'-9		19-16
h1	20	WS 3/4"ø x 10	A108			29-19

NOTE: ALL MATERIALS SPECIFICATION DESCRIPTIONS ARE ASTM, UNLESS OTHERWISE NOTED.

RECEIVED
OK'D BY JWC OK'D BY TAS
NOV 16 2004
RESUBMIT _____ APPROVED
BY DATE 12/13/2004

REV.	DESCRIPTION	DATE	DET.	CKD.

D.S. BROWN
300 E. CHERRY STREET
NORTH BALTIMORE, OHIO 45872
419.257.3561
FAX: 419.257.0332

4201 NOREX DRIVE
CHASKA, MINNESOTA 55318
952.368.3000
FAX: 952.448.7000

DSBROWN.COM

LOCATION — GRANITE STREET OVER STEVENS BRANCH OF THE WINOOSKI RIVER
BRIDGE — 11
PROJECT — HDP 9281 (1)
CITY — BARRE
P.O. NO. — C-1455
DESIGNER — VERMONT D.O.T.
CUSTOMER — WINTERSET INC.

ITEM	QUANTITY

DESCRIPTION:
EMBEDDED PLATE ASSEMBLY
COUNTY OF WASHINGTON, VERMONT

SCALE:	DRAWN BY:	CHECKED BY:	DATE:	SHEET
N.T.S.	T.BOWERS	T.ELLER	10-25-04	3 OF 3
PROJECT NUMBER	PRODUCT CODE	RELEASE	SHEET	
12550	1042		3	

083 RJ