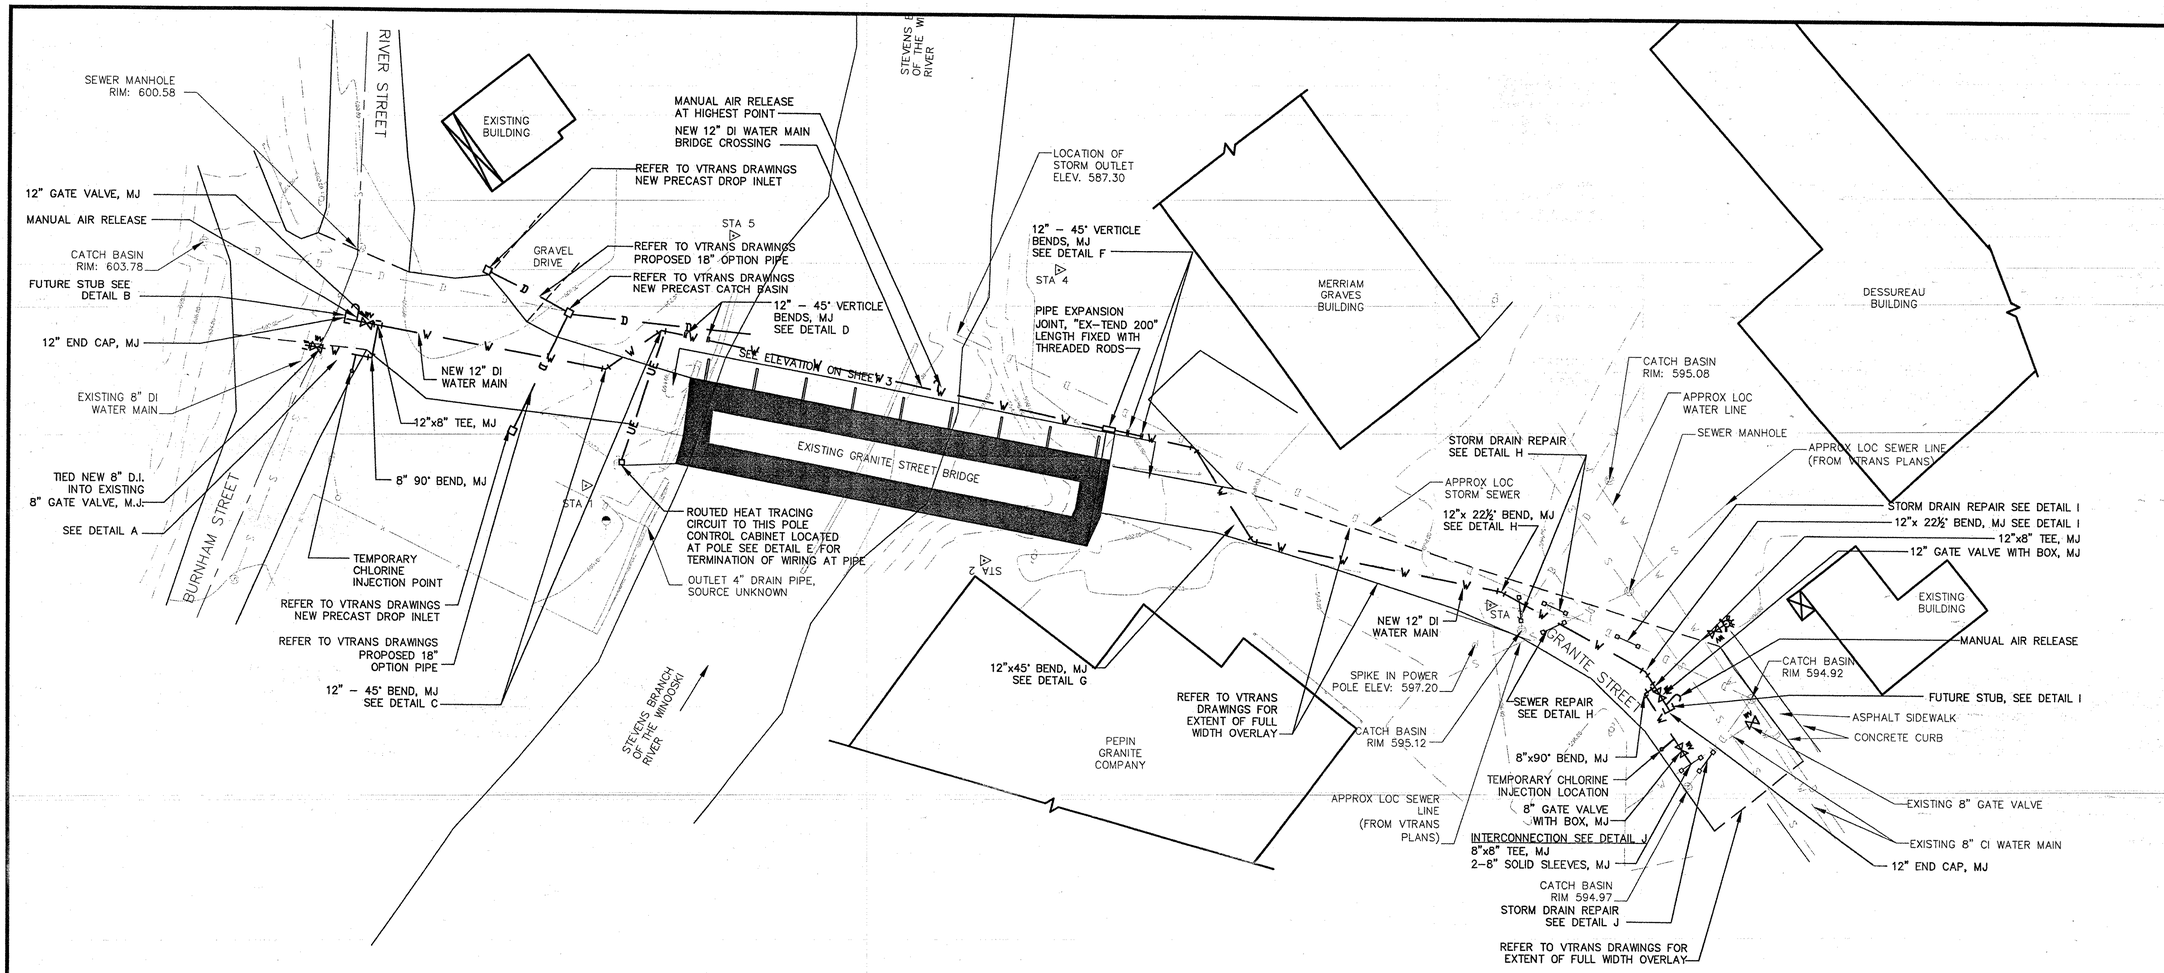

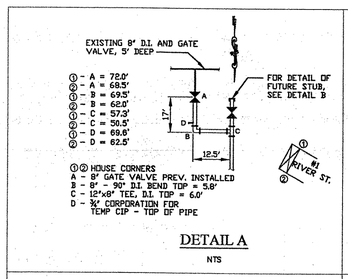

DETAIL A

NTS

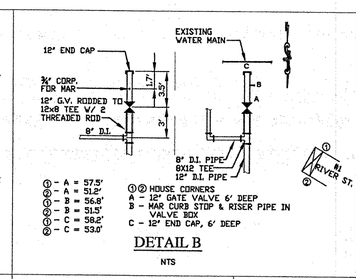

DETAIL B

NTS

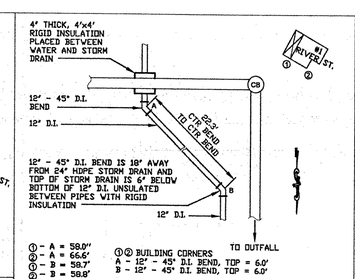

DETAIL C

NTS

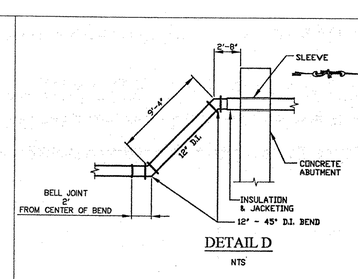

DETAIL D

NTS

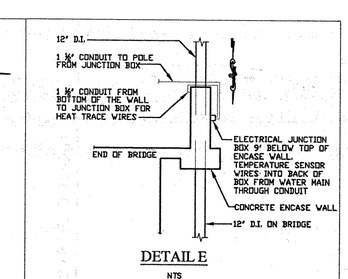

DETAIL E

NTS

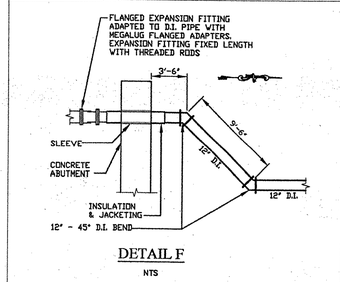

DETAIL F

NTS

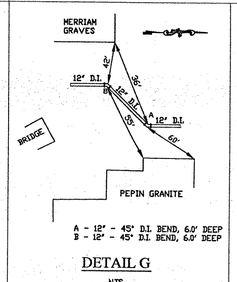

DETAIL G

NTS

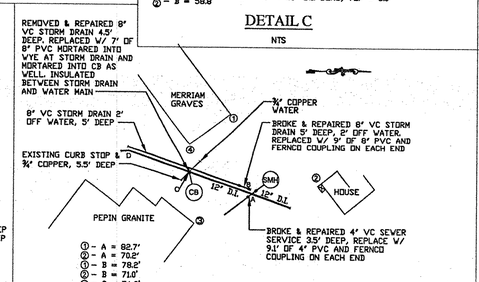

DETAIL H

NTS

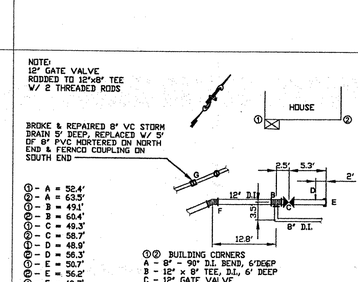

DETAIL I

NTS

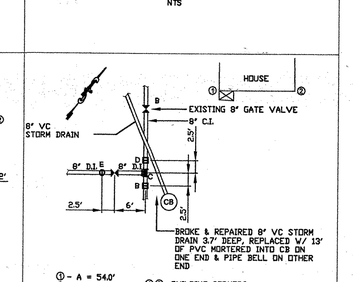

DETAIL J

NTS

RECORD DRAWINGS

Dufresne & Associates, P.C.
54 Main Street, P.O. Box B
Windsor, Vermont 05089
Tel: (802) 674-2904 Fax: (802) 674-2913
E-mail: dufresnepc@vermontel.net
Home page: http://www.dufresneassociates.com

Project #	413025
Project Mgr.	JRP
Design	JRP
Drawn	GJW
Checked by	RNG
Date	OCTOBER 5, 2004
Scale	AS SHOWN
Approved by	JRP

Revisions:

THE DRAWINGS FOR THIS PROJECT SHALL NOT BE REUSED OR ALTERED IN ANY WAY WITHOUT THE WRITTEN APPROVAL AND AUTHORITY OF DUFRESNE & ASSOCIATES, P.C. ANY REVISIONS SHALL BE MADE BY THE ENGINEER.

Dufresne & Associates, PC ©

STATE OF VERMONT
JOHN R. PERRY
No. 6806
10-04-04
PROFESSIONAL ENGINEER

GRANITE STREET BRIDGE IMPROVEMENTS

RECORD DRAWINGS SITE PLAN

BARRE, VERMONT

R2

DWG. NO. --- 0286 W2

SHEET 2 OF 5