STATE OF VERMONT
AGENCY OF TRANSPORTATION

TRAFFIC SIGN SUMMARY SHEET

MILEMARKER, STATION, OR SIGN NUMBER	SIGN LEGEND	SIGN DIMENSIONS EA	SIGN DIMENSIONS WIDTH (in)	SIGN DIMENSIONS HEIGHT (in)	NEW & SALVAGED SIGNS "A"	NEW & SALVAGED SIGNS "B"	NEW & SALVAGED SIGNS SALV SIGN	NEW & SALVAGED SIGNS SALV TIS	EXIST POST RETAIN	EXIST POST SALVAGE	NEW SIGN POSTS NO. OF POSTS	FLANGED CHANNEL lb/ft 1.12	FLANGED CHANNEL lb/ft 2.0	FLANGED CHANNEL lb/ft 3.0	~~SQUARE STEEL~~ (in) lb/ft 1.75 1.88	~~SQUARE STEEL~~ (in) lb/ft 2.0 2.16	~~SQUARE STEEL~~ (in) lb/ft 2.5 3.35	ANCHOR	SLEEVE	TUBULAR ALUMINUM Ø (in) lb/ft 3.0 1.3	TUBULAR ALUMINUM Ø (in) lb/ft 4.0 1.7	TUBULAR ALUMINUM Ø (in) lb/ft 4.0 MOD 1.7	FOUND-ATION	TUBULAR STEEL Ø (in) lb/ft 3.0 7.6	TUBULAR STEEL Ø (in) lb/ft 3.5 9.0	TUBULAR STEEL Ø (in) lb/ft 4.0 10.8	TUBULAR STEEL Ø (in) lb/ft 5.0 14.6	W-SHAPE STEEL FTG. SIZE 24"	W-SHAPE STEEL FTG. SIZE 30"	W-SHAPE STEEL WEIGHT	W-SHAPE STEEL POST SIZE	SIGN FRAME REQUIRED	REMARKS	SIGN DETAIL DETAIL ON SHEET NUMBER	SIGN DETAIL STD. SHEET NUMBER
												OPTION ITEMS																							
T.H. 85 8+04.0, RT		1	36	36	7.10						1			X 14 LF			X	X																	SIGN ID CODE W10-1	-	E-190
12+70.0, LT		1	30	30	6.25						1			X 12 LF			X	X																	SIGN ID CODE W10-4L	20	-
13+25.0, RT		1	30	30	6.25						1			X 16 LF			X	X																	SIGN ID CODE W10-4L	20	-
~~45~~ 13+~~40~~.0, RT	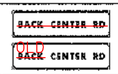	~~2~~ 1	36	9	2.25		~~2~~				1			X 12 LF			X	X																	SALVAGED SIGNS TO BE MOUNTED ON NEW POST. TOP MOUNTING BRACKET REQUIRED TO INSTALL SALVAGED SIGN ON NEW POST. COSTS ASSOCIATED WITH THIS BRACKET ARE INCIDENTAL TO THE SIGN POST. BACK-TO-BACK.		
		1	30	30	6.25						1																								SIGN ID CODE R1-1	-	E-143
14+52.0, LT		1	36	36	7.10						1			X 12 LF			X	X																	SIGN ID CODE W10-1	-	E-190
14+62.0, LT		1	24	30	5.00						1			X 12 LF			X	X																	SIGN ID CODE VR-017	-	E-141
14+62.0, RT		1	30	9	1.88						1			X 14 LF			X	X																	NEW SIGN SHALL BE MOUNTED ON NEW POST. TOP MOUNTING BRACKET REQUIRED TO INSTALL NEW SIGN ON POST. COSTS ASSOCIATED WITH THIS BRACKET ARE INCIDENTAL TO THE SIGN POST.	-	E-123
		1 1	30 6	30 10	6.25 0.42																														SIGN ID CODE R1-1 SIGN ID CODE VD-700 BACK-TO-BACK	- -	E-143 E-138
U.S. ROUTE 5 103+45.0, RT		1	30	30	6.25						1			X 12 LF			X	X																	SIGN ID CODE W11-2 FLUORESCENT YELLOW GREEN BACKGROUND	-	E-152
												FT	FT	FT ~~112.0~~ 104.0	FT	FT	FT 112.0		EA	LB	LB	LB		LB	LB	LB	LB								
TOTALS			SF ~~52.75~~ 55.00	SF	EA. 2	SF						FT ~~112.0~~ 104.0			FT 112.0					LB			EA.	LB				EA.	EA.	LB				

FINAL POST LENGTHS ARE TO BE DETERMINED IN THE FIELD. POST SIZES ARE COMPUTED BASED ON INFORMATION FURNISHED ON THE STANDARD SHEETS AND THE TRAFFIC OPERATIONS SECTION "SIGN POST DESIGN GUIDELINE."

PROJECT NAME: ST. JOHNSBURY, BRIDGE NO. 29
PROJECT NUMBER: BRO 1447(19)

FILE NAME: TSS.DGN
PROJECT LEADER: J.P.H.

PLOT DATE: 12/20/2006
DRAWN BY: C.A.K.
CHECKED BY: D.W.E.
SHEET 19 OF 72 SHEETS

FILE NAME =u:\379\msgn\03\final\TSS.DGN
USER =2467