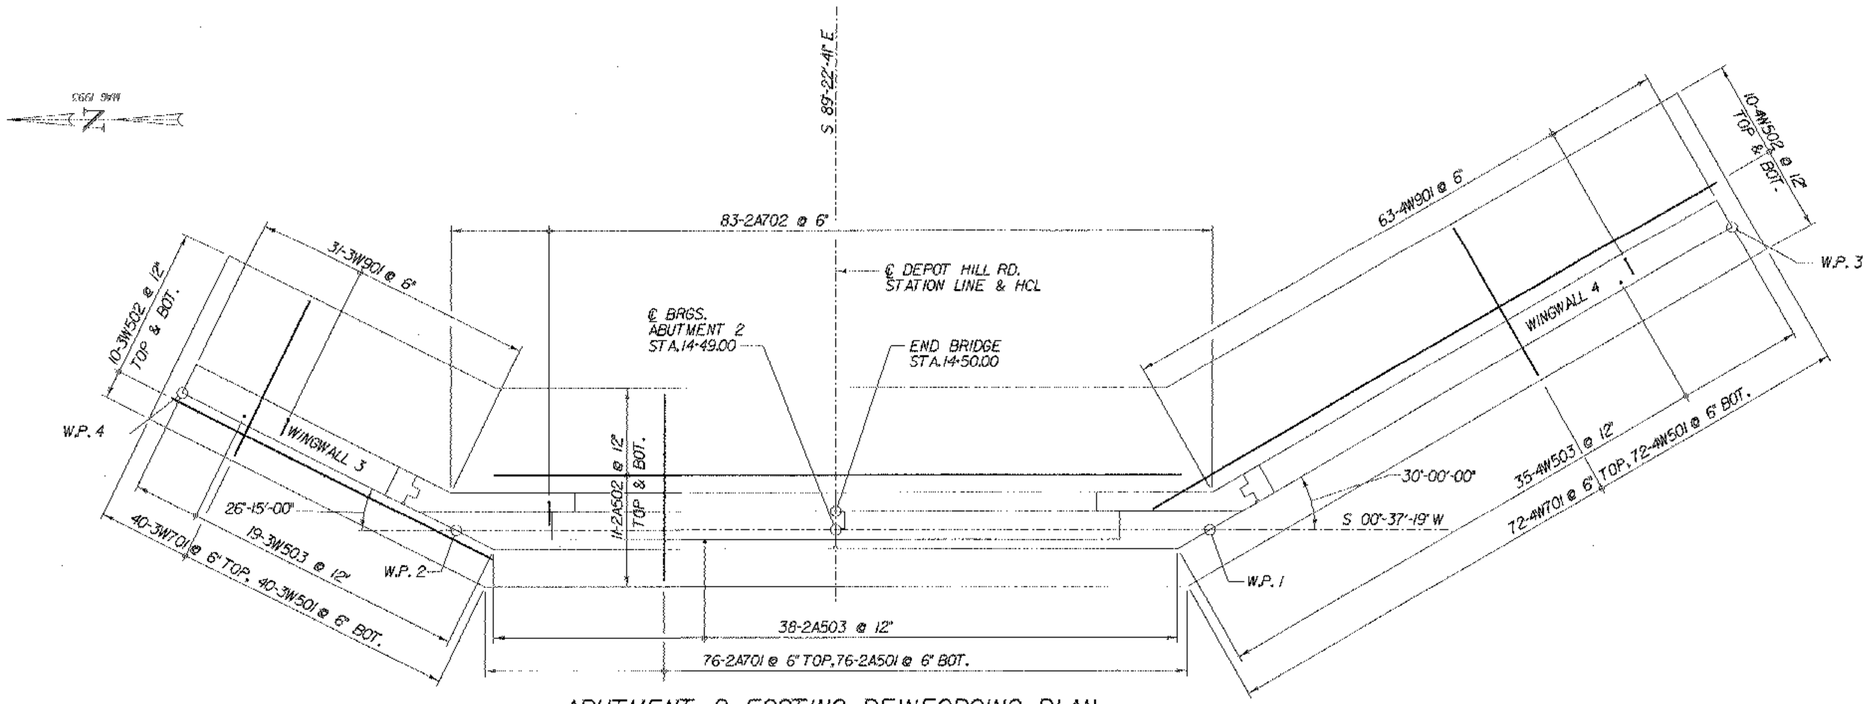

ABUTMENT 2 FOOTING REINFORCING PLAN

SCALE 1/4" = 1'-0

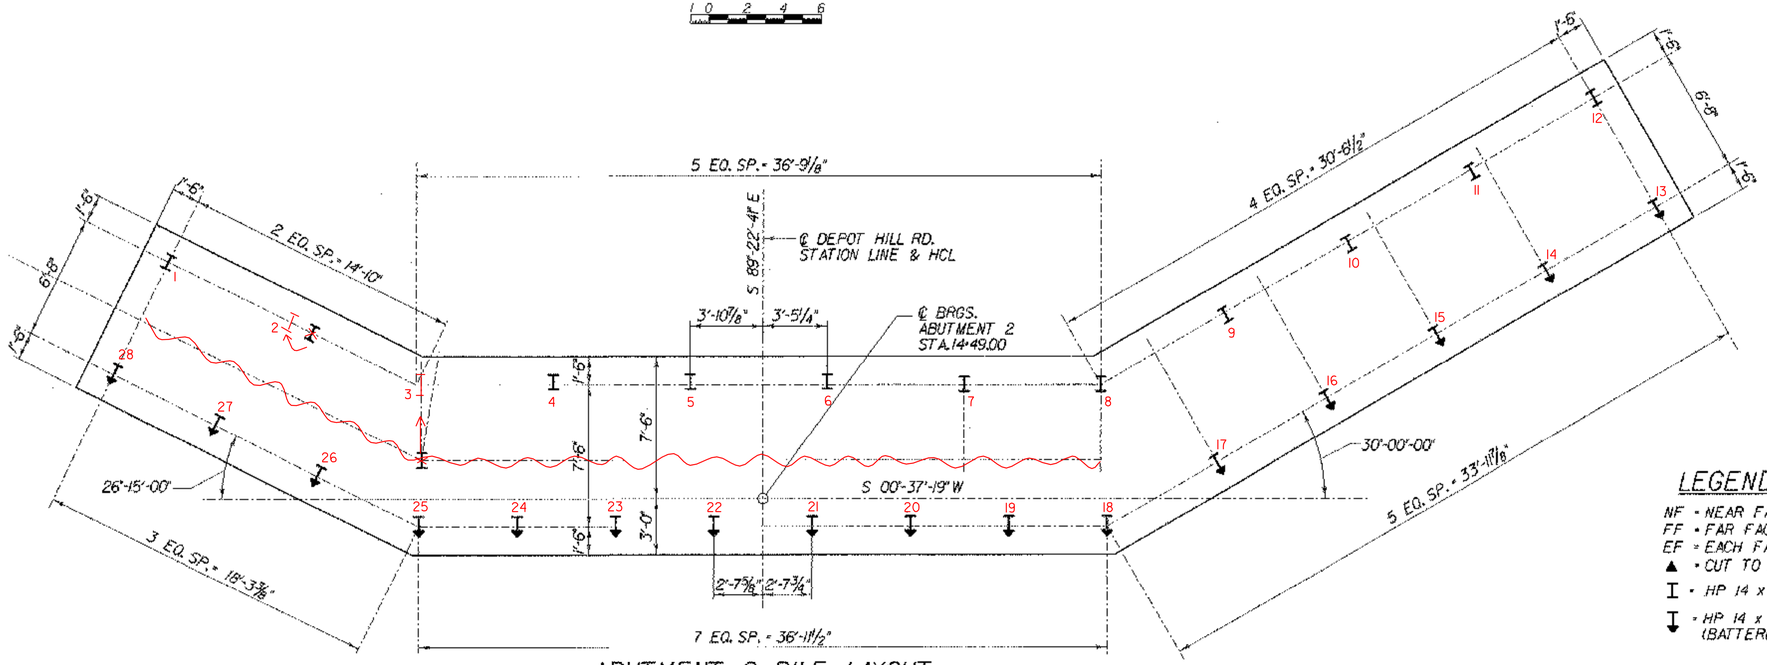

ABUTMENT 2 PILE LAYOUT

SCALE 1/4" = 1'-0

NOTES:

1. 3" CLR. UNLESS OTHERWISE SPECIFIED ON THE PLANS.
2. SEE SHT. BR119 FOR PILE DETAILS.

LEGEND:

NF = NEAR FACE
FF = FAR FACE
EF = EACH FACE
▲ = CUT TO FIT IN FIELD
I = HP 14 x 73
I = HP 14 x 73 PILE (BATTERED 1:6)

CLOUGH HARBOUR & ASSOCIATES LLP
www.cloughharbour.com

STATE OF VERMONT
AGENCY OF TRANSPORTATION

Town Of ST. JOHNSBURY	Bridge No. 29
	Log Sta.
Highway No. T.H. 85	Surv. Sta.
DEPOT HILL ROAD OVER THE PASSUMPSIC RIVER	
ABUTMENT 2 FOOTING REINFORCEMENT & PILE LAYOUT	
Designed By M. SMULLEN	Drawn by Wm WEATHERBY
Checked By M. OLSTAD Date 7/2003	Bridge Design Supervisor P. HALSTEAD Date 9/2006
PROJECT ST. JOHNSBURY	PROJECT NO. BRO 1447(19)
I.C.C. Info.	
Bridge Sheet No. BR116	Sheet 49 OF 72

FILE NAME = 53A29A02A01S02-29A1447_2PBP.dgn
DATE/TIME = 12/29/2006
USER = 2467