STATE OF VERMONT
AGENCY OF TRANSPORTATION

TRAFFIC SIGN SUMMARY SHEET

Metric

KILOMETER MARKER, STATION, OR SIGN NUMBER	SIGN LEGEND	SIGN DIMENSIONS EA	WIDTH (mm)	HEIGHT (mm)	NEW & SALVAGED SIGNS "A"	"B"	SALV SIGN	SALV TIS	EXIST POST RETAIN	SALVAGE	NEW SIGN POSTS NO. OF POSTS	FLANGED CHANNEL kg/m 4.7	3.0	4.5	SQUARE STEEL (mm) kg/m 44 3.4	50 3.9	63 5.0	ANCHOR	SLEEVE	TUBULAR ALUMINUM Ø (mm) kg/m 75 1.9	100 2.5	100 MOD 2.5	TUBULAR STEEL Ø (mm) FOUND-ATION	75 11.3	89 13.4	100 16.1	125 21.7	W-SHAPE STEEL FTG. SIZE 600 mm	750 mm	WEIGHT	POST SIZE	SIGN FRAME REQUIRED	REMARKS	SIGN DETAIL DETAIL ON SHEET NUMBER	STD. SHEET NUMBER
											OPTION ITEMS																									
4+006.8 LT ~~4+009.300 LT~~	STOP	1	750	750	0.563						1		X			X		X															R1-1		E-143
4+009.300 LT	0114 0215 0103	1	150	200	0.030																														E-138
4+022 RT ~~4+020.000 RT~~	SPEED LIMIT 35	1	600	750	0.450						1		X			X		X															R2-1		E-142
4+030 RT ~~4+020.00 RT~~	ROAD CLOSED OVER MOUNTAIN DURING WINTER MONTHS	1	750	750	0.563						~~2~~ 1		X			X		X																	SEE DETAIL THIS SHEET
4+049.00 RT	LOG TRUCKS	1	750	750	0.563																														SEE DETAIL THIS SHEET
	ROUTE US 7 ←	2	180	700	.126 .126																														
	KELLY STAND RD	2	180	800	.144 .144																														
	NORTH RD	2	180	700	.126 .126																														
					2.961																														

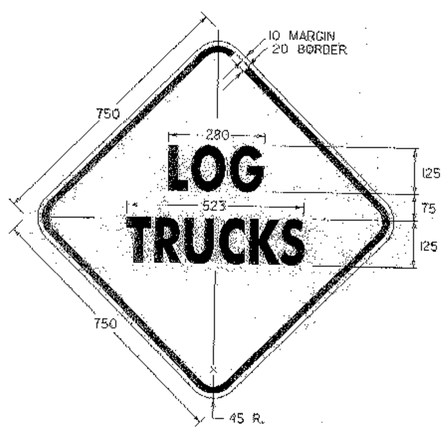

COLORS
BORDER AND TEXT - BLACK
BACKGROUND - REFLECTORIZED YELLOW

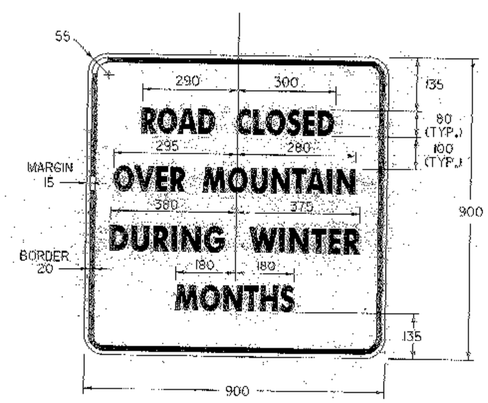

COLORS
BORDER AND TEXT - BLACK
BACKGROUND - REFLECTORIZED WHITE

FINAL POST LENGTHS ARE TO BE DETERMINED IN THE FIELD. POST SIZES ARE COMPUTED BASED ON INFORMATION FURNISHED ON THE STANDARD SHEETS AND THE TRAFFIC & SAFETY DIVISION'S "SIGN POST DESIGN GUIDELINE."

							m	m	m	m	m	m		EA	kg	kg	kg		kg	kg	kg	kg			
TOTALS	m^2 2.2	m^2	EA.	m^2			m 12										kg	EA.			kg		EA.	EA.	kg

SHEET NAME:	SIGN SUMMARY SHEET
PROJECT NAME:	SUNDERLAND
PROJECT NUMBER:	BRF 0114(2)
HIGHWAY NO.:	TH 3
BRIDGE NO.:	14
OVER:	ROARING BRANCH
FILE NAME:	/PW/93J009/sj009sgn.dgn
PROJECT MANAGER:	R. R. WHITCOMB
DESIGNED BY:	K. UPMAL
PLOT DATE:	14-DEC-2005
DRAWN BY:	K. UPMAL
IPARM NAME:	sJ009sll.i
SHEET	50 OF 67