REVISIONS				
ZONE	REV	DESCRIPTION	DATE	APPROVED
- -	A	FOR ENGINEER'S MARK	11/17/06	C.A.M.
- -	B	FOR ENGINEER'S MARK	2/15/07	C.A.M.

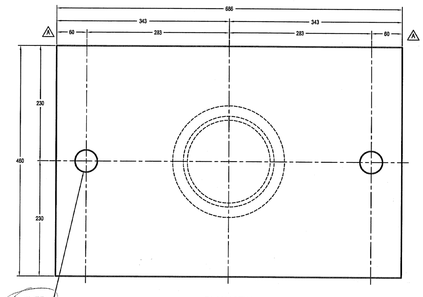

PLAN VIEW

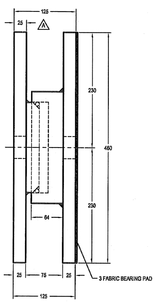

SIDE VIEW

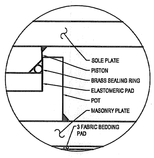

DETAIL Z

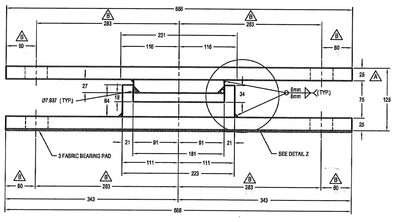

ELEVATION VIEW
ABUTMENT 1, GIRDERS 2 & 3
VERTICAL LOAD CAPACITY = 6148kN
QTY. REQ'D = 2

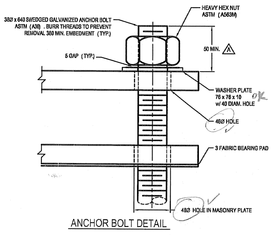

ANCHOR BOLT DETAIL

RECEIVED
OK'D BY ___ OK'D BY ___
FEB 2 3 2007
RESUBMIT ___ APPROVED ___
BY DATE

NOTES
1. REFERENCE SHEET 7 OF 7 FOR BEARING NOTES.

Structures

SUNDERLAND
PROJECT NO. BRF 0114(2)
HIGHWAY NO. TH 3, BRIGDE NO. 13
OVER ROARING BRANCH

FIXED POT BEARING DETAIL

AMSCOT
STRUCTURAL PRODUCTS CORP.
DOVER, NJ

JOB# 2291

SCALE: N.T.S.	APPRV'D: B.F.	DRAWN BY: C.A.M.
DATE: 6/27/06		REVISION: B

FOR: PETRICCA CONSTRUCTION COMPANY

DWG NO: PC06A1RB | SHEET NO. 1 OF 7