REVISIONS				
ZONE	REV	DESCRIPTION	DATE	APPROVED
- -	A	PER ENGINEER'S MARK	9/29/06	C.A.M.
- -	B	PER ENGINEER'S MARK	11/17/06	C.A.M.
- -	C	PER ENGINEER'S MARK	2/13/07	C.A.M.

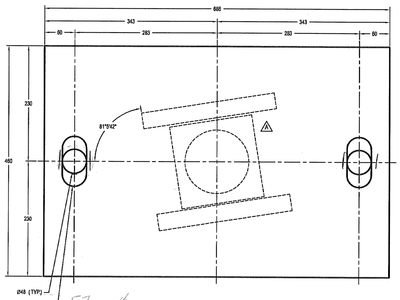

PLAN VIEW

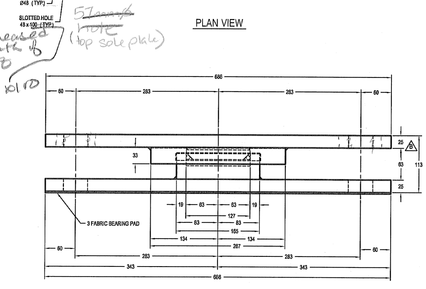

ELEVATION VIEW
ABUTMENT 1, GIRDER 1
VERTICAL LOAD CAPACITY = 300kN
QTY. REQ'D = 1

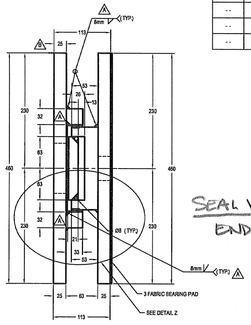

SIDE VIEW

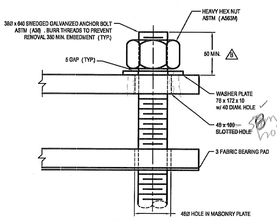

ANCHOR BOLT DETAIL

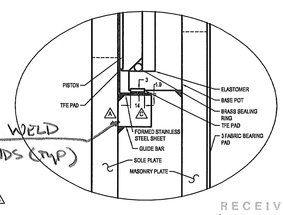

DETAIL Z

NOTES
1. REFERENCE SHEET 7 OF 7 FOR BEARING NOTES.

RECEIVED
CK'D BY CWC OK'D BY
FEB 2 3 2007
RESUBMIT APPROVED AS NOTED
BY DATE

SUNDERLAND
PROJECT NO. BRF 0114(2)
HIGHWAY NO. TH 3, BRIGDE NO. 13
OVER ROARING BRANCH

GUIDED POT BEARING DETAIL

AMSCOT
STRUCTURAL PRODUCTS CORP.
DOVER, NJ

SCALE: N.T.S.	APPRV'D: B.F.	DRAWN BY: C.A.M.
DATE: 6/27/06		REVISION: C
FOR: PETRICCA CONSTRUCTION COMPANY		
DWG NO: PC06A2RC		SHEET NO. 2 OF 7

JOB# 2291