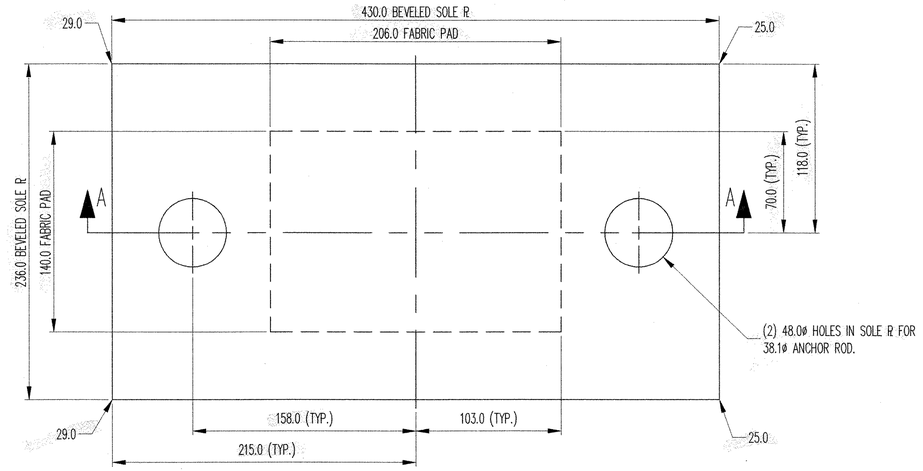

PLAN VIEW

FIXED PREFORMED FABRIC BEARING
(4) REQ'D @ ABUT. 1, STRINGER

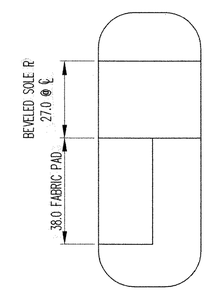

DETAIL 'A'

UP STATION

SECTION 'A–A'

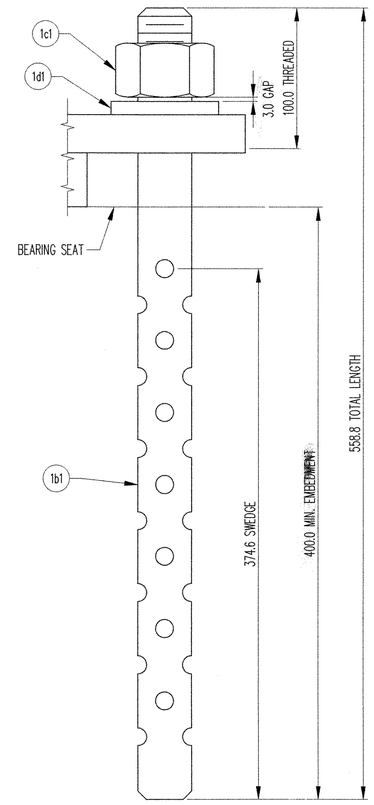

ANCHOR ROD DETAIL

MK	QTY.	DESCRIPTION	MATERIAL	LENGTH	REMARKS	PART NO.
1A	4	PREFORMED FABRIC BEARING				
1a1	4	38.0 X 206.0	VT 707.07	140.0	~~(AASHTO 18.4.10.1)~~	
1sp1	4	29.0 X 430.0	A709 GR 345	236.0	(AASHTO M270 GR 345); A123-HDG	
1B	8	SWEDGE ANCHOR ROD				
1b1	8	38.1ø X 558.8	A36		(AASHTO M183) 374.6 SWEDGE, 100.0 THREADED; A153-HDG	
1C	8	HEAVY HEX NUT				
1c1	8	38.1ø	A563-DH/A194-2H		(AASHTO M291-DH/M292-2H), SEE NOTE 7; A153-HDG	
1D	8	WASHER PLATE				
1d1	8	9.5 X 76.2	A36	76.2	41.3 DIA. HOLE; A153-HDG	

NOTE: ALL DIMENSIONS IN MILLIMETERS, UNLESS OTHERWISE NOTED.
NOTE: ALL MATERIAL SPECIFICATION DESCRIPTIONS ARE ASTM, UNLESS OTHERWISE NOTED.

13.01

AASHTO M270 Grade 345 O.K.

RECEIVED
CK'D BY_____ CK'D BY_____
APR 29 2004
RESUBMIT_____ APPROVED As Noted
BY RRW DATE 5-12-04

FOR GENERAL NOTES SEE SHEET GN1.

REV.	DESCRIPTION	DATE	DET.	CKD.

D.S. BROWN
300 E. CHERRY STREET
NORTH BALTIMORE, OHIO 45872
419.257.3561
FAX: 419.257.0332

4201 NOREX DRIVE
CHASKA, MINNESOTA 55318
952.368.3000
FAX: 952.448.7000

DSBROWN.COM

LOCATION — T.H. 4 OVER BLACK RIVER CAVENDISH
BRIDGE — 12
PROJECT — BHO 1442 (22)
F.A.P. NO. — –
P.O. NO. — 4013
DESIGNER — VANASSE HANGEN BRUSTLIN, INC.
CUSTOMER — MILLER CONSTRUCTION

ITEM	QUANTITY
11091–1106–1	4 OF 4
–	–
–	–
–	–
–	–
–	–
–	–
–	–
–	–

DESCRIPTION:
PREFORMED FABRIC BEARING
WINDSOR COUNTY, VERMONT

SCALE:	DRAWN BY:	CHECKED BY:	DATE:	
N.T.S.	B.COPPUS	E.KELLEY	4/22/04	–
PROJECT NUMBER	PRODUCT CODE	RELEASE	SHEET	
11091	1106	1	01	

1141 RR