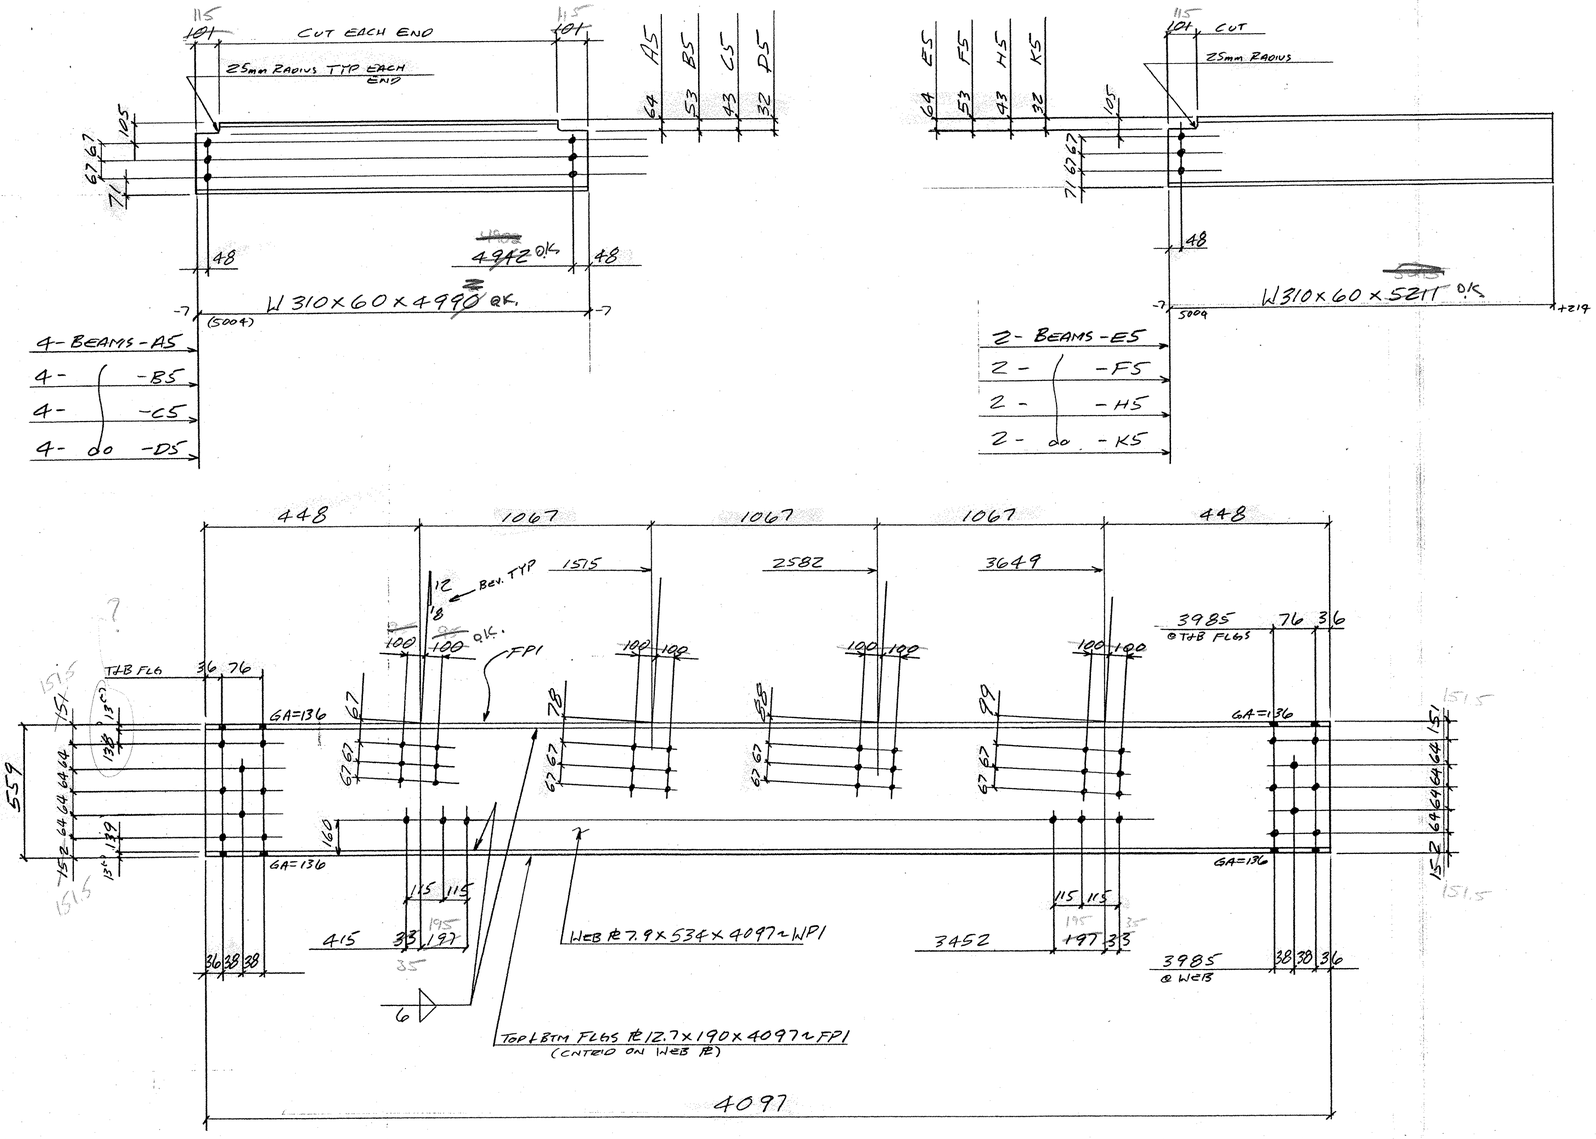

ABM INFO		SHOP BILL					JOB NO. 236	DRG. NO. 5
PAGE	LINE	NO.	DESCRIPTION		LNGTH IN MM	ASSEM. MARK	SHIPPING MARK	REMARKS	WEIGHT
			PAY ITEMS 506.50						
		4	W310x60		4990		A5	GR345	
		4			4990		B5		
		4			4990		C5		
		4			4990		D5		
		2			5211		E5		
		2			5211		F5		
		2			5211		H5		
		2	do		5211		K5	do	
			PAY ITEMS 506.55						
		5	FLOOR BEAMS				M5		
		10	PL12.7x190		4097	FP1			
		5	PL7.9x534		4097	WP1			

OUT FOR APPROVAL	4-23-04									
OUT FOR APPROVAL										
ISSUED TO SHOP										
FIELD & OFFICE										
REV.	REMARKS	DATE	DWN	CHK	APP	Q.A.	NO.	DIA.	LGT	TYPE	WASHER

PROJECT NO. BHO 1442 (22) STATE PROJECT NO. (BHO 1442 (22)

MATERIAL: AASHTO M270 GR250 ¼" | ELECTRODES: E70 PROCESS | HOLES: 24 φ ¼" | SHOP BOLTS:

SURFACE PREP. & PAINT:
GALVANIZE
AASHTO M111

DESCRIPTION: STRINGERS + FLOOR BEAMS

JOB: TH4 OVER BLACK RIVER BRIDGE PROJECT CAVENDISH, VT

CUSTOMER: MILLER CONSTRUCTION

	DRAWN BY	DATE
	RLB	4-04
	CHKD BY	
	APPROV BY	
	Q.A.	

CASCO BAY STEEL STRUCTURES, INC.
75 SPRING HILL ROAD SACO, MAINE 04072
PHONE (207) 282-7360 FAX. (207) 282-1179

JOB NO. 236 DRG. NO. 5 REV. △

PLANS DRAWN USING **METRIC** DIMENSIONS

RECEIVED
CK'D BY VMP OK'D BY
APR 27 2004
RESUBMIT APPROVED
BY DATE

053 SS