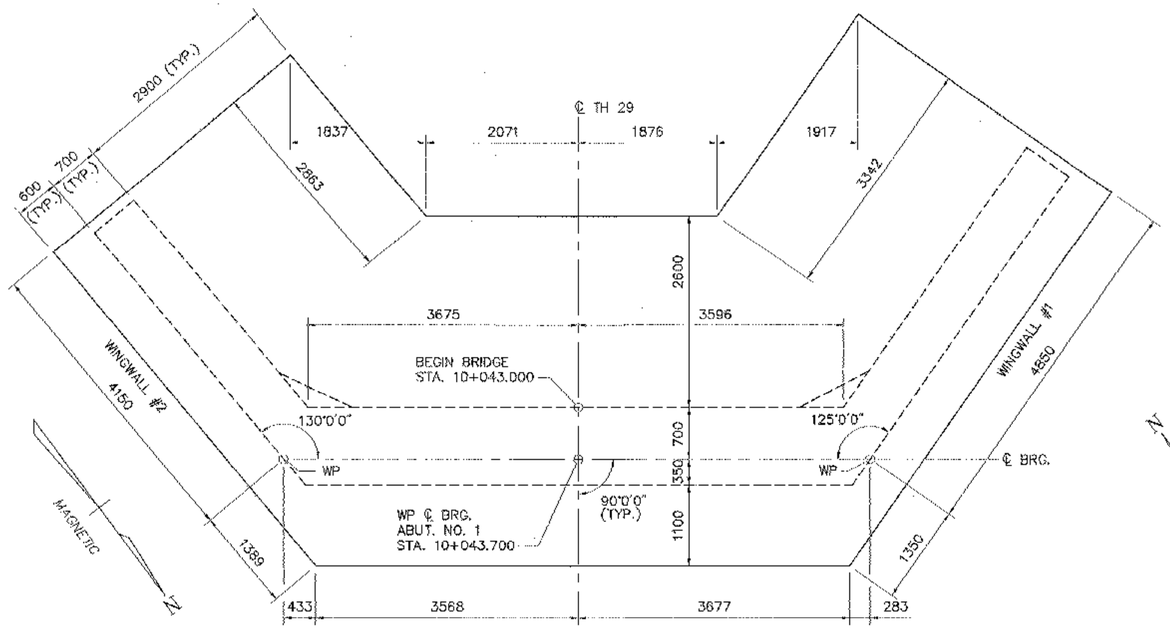

ABUTMENT 1 FOOTING PLAN
SCALE: 1:40

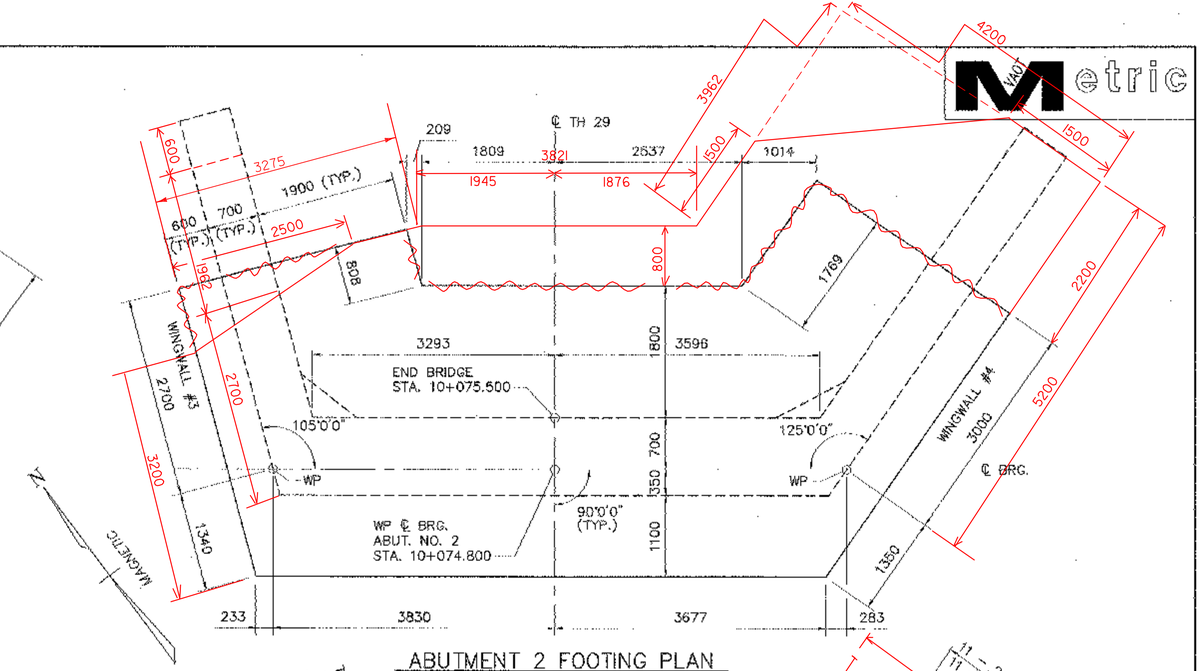

ABUTMENT 2 FOOTING PLAN
SCALE: 1:40

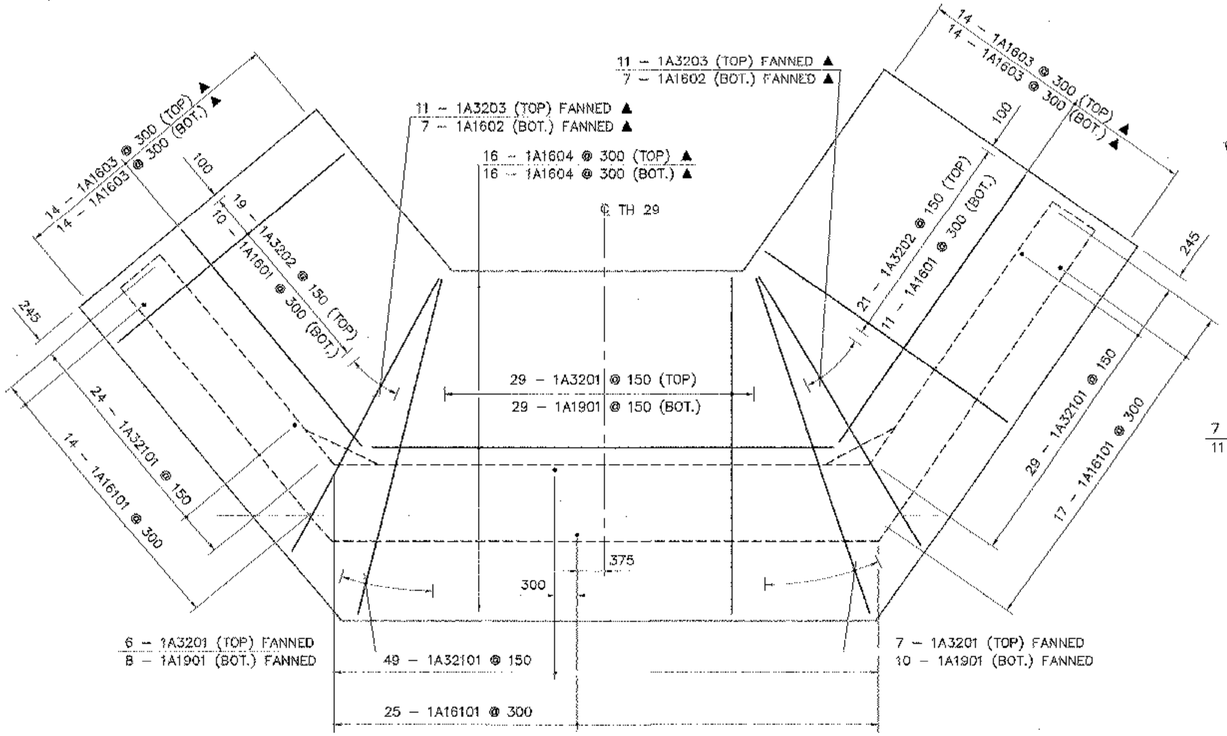

ABUTMENT 1 FOOTING REINFORCEMENT
SCALE: 1:40

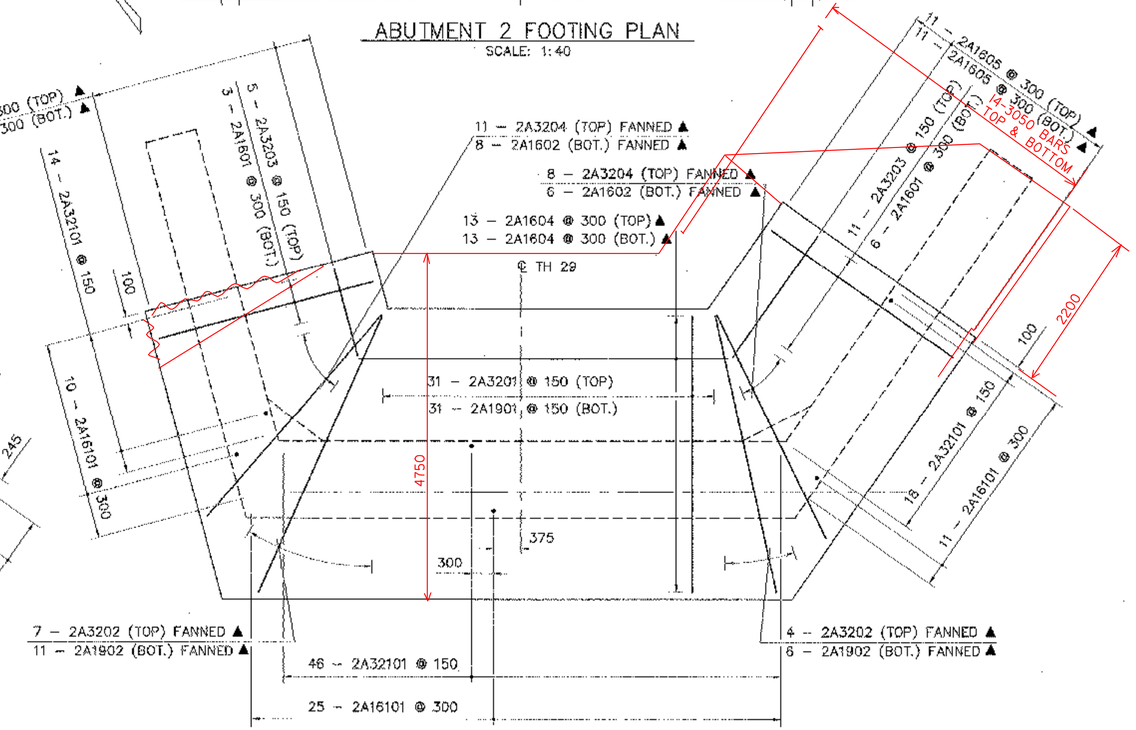

ABUTMENT 2 FOOTING REINFORCEMENT
SCALE: 1:40

KEY
E.F. = EACH FACE
N.F. = NEAR FACE
F.F. = FAR FACE
▲ CUT TO FIT IN THE FIELD

STATE OF VERMONT
AGENCY OF TRANSPORTATION

Town Of CAVENDISH	Bridge No. 45
	Log Sta.
Highway No. TH 29	Surv. Sta.
TH 29 OVER BLACK RIVER	
FOOTING LAYOUT & REINFORCEMENT	
Designed By S.M. HODGDON	Drawn By C.L. CILLEY
Checked By W.M. MOSHER Date 5/06	Bridge Design Supervisor C.D. BAKER Date 5/06
PROJECT CAVENDISH	PROJECT NO. BRO 1442(23)
I.G.C. Info.	
VANASSE HANGEN BRUSTLIN, INC.	Bridge Sheet No. 50499FTG Sheet 25 of 47