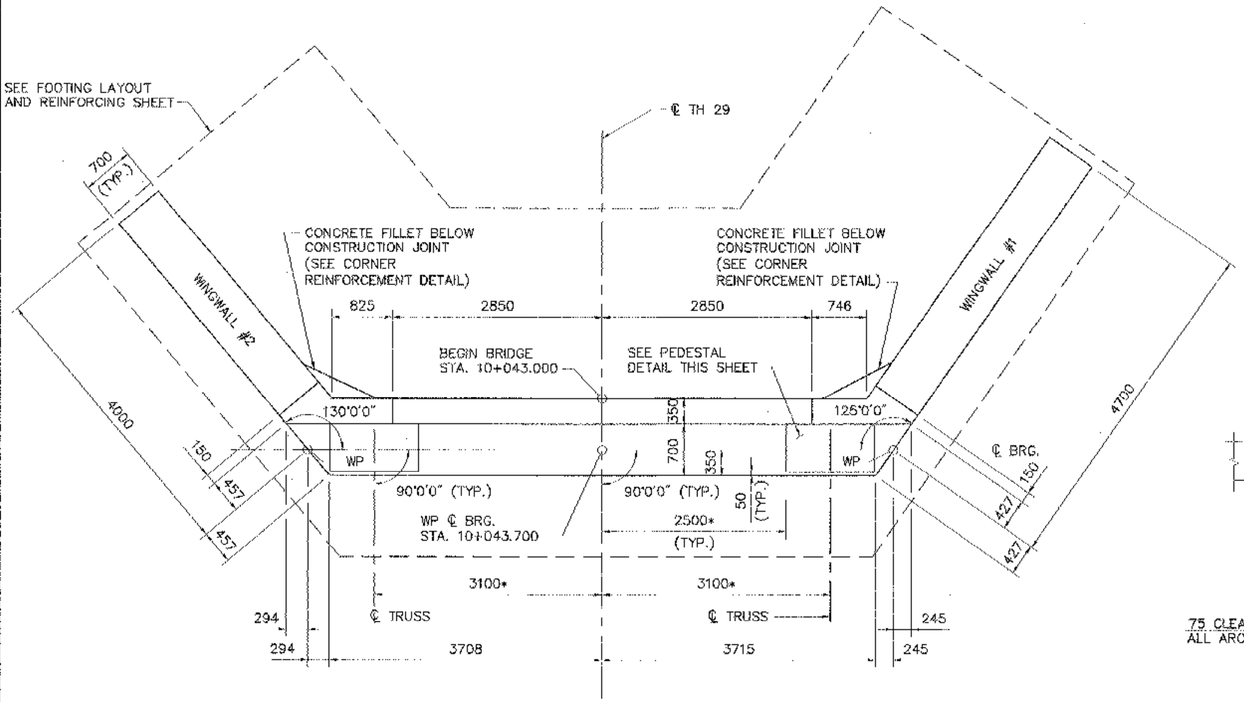

PLAN
SCALE: 1:40

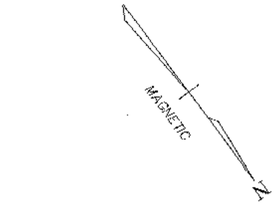

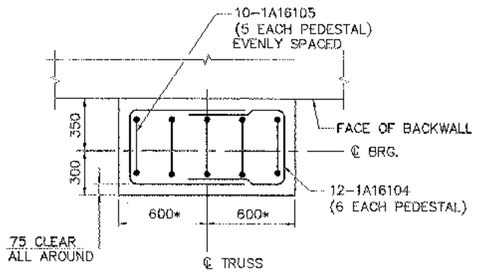

TYPICAL PEDESTAL PLAN DETAIL
(PLACE PEDESTAL REINFORCING TO AVOID ANCHOR RODS)
SCALE: 1:20

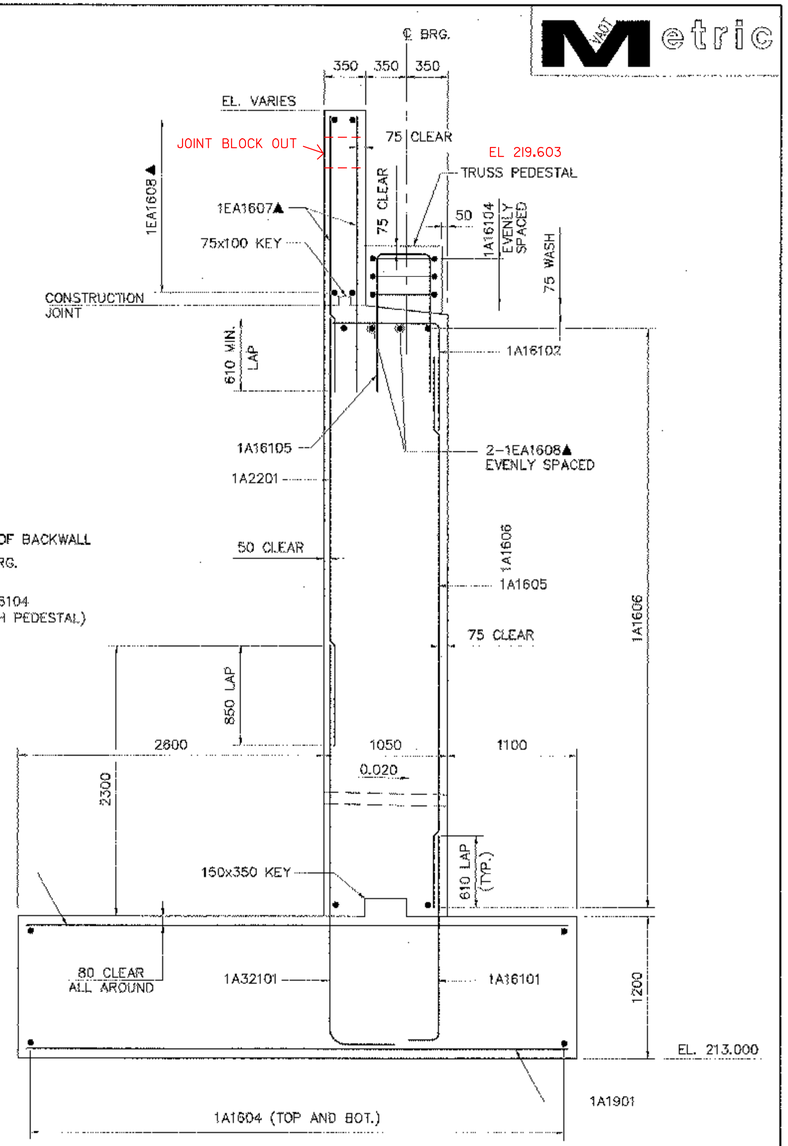

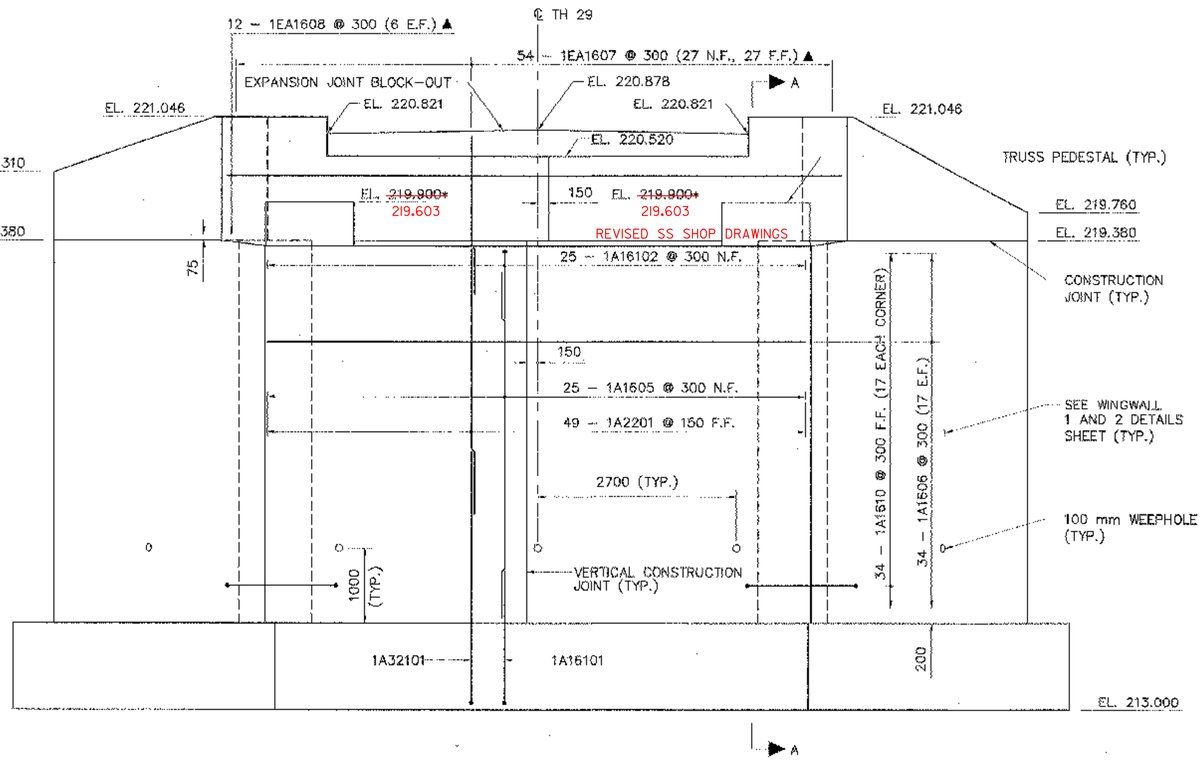

* DIMENSION OR ELEVATION TO BE CONFIRMED BY THE TRUSS MANUFACTURER

ELEVATION
SCALE: 1:40

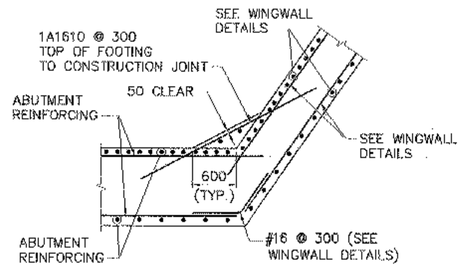

CORNER REINFORCEMENT DETAIL
SCALE: 1:40

SECTION A–A
SCALE: 1:25

NOTE:
1. SEE SHEET 28 FOR TYPICAL WEEPHOLE DETAIL.

KEY
E.F. = EACH FACE
N.F. = NEAR FACE
F.F. = FAR FACE
▲ CUT TO FIT IN THE FIELD

STATE OF VERMONT
AGENCY OF TRANSPORTATION

Town Of CAVENDISH	Bridge No. 45
Highway No. TH 29	Log Sta. / Surv. Sta.
TH 29 OVER BLACK RIVER	
ABUTMENT 1 DETAILS	
Designed By S.M. HODGDON	Drawn By M.M. LANDREY
Checked By W.M. MOSHER Date 5/06	Bridge Design Supervisor C.D. BAKER Date 5/06
PROJECT CAVENDISH	PROJECT NO. BRO 1442(23)
I.G.C. Info.	
VANASSE HANGEN BRUSTLIN, INC.	Bridge Sheet No. 50499AB1 Sheet 26 of 47

PLOTTED 5/15/2006