VAOT Metric

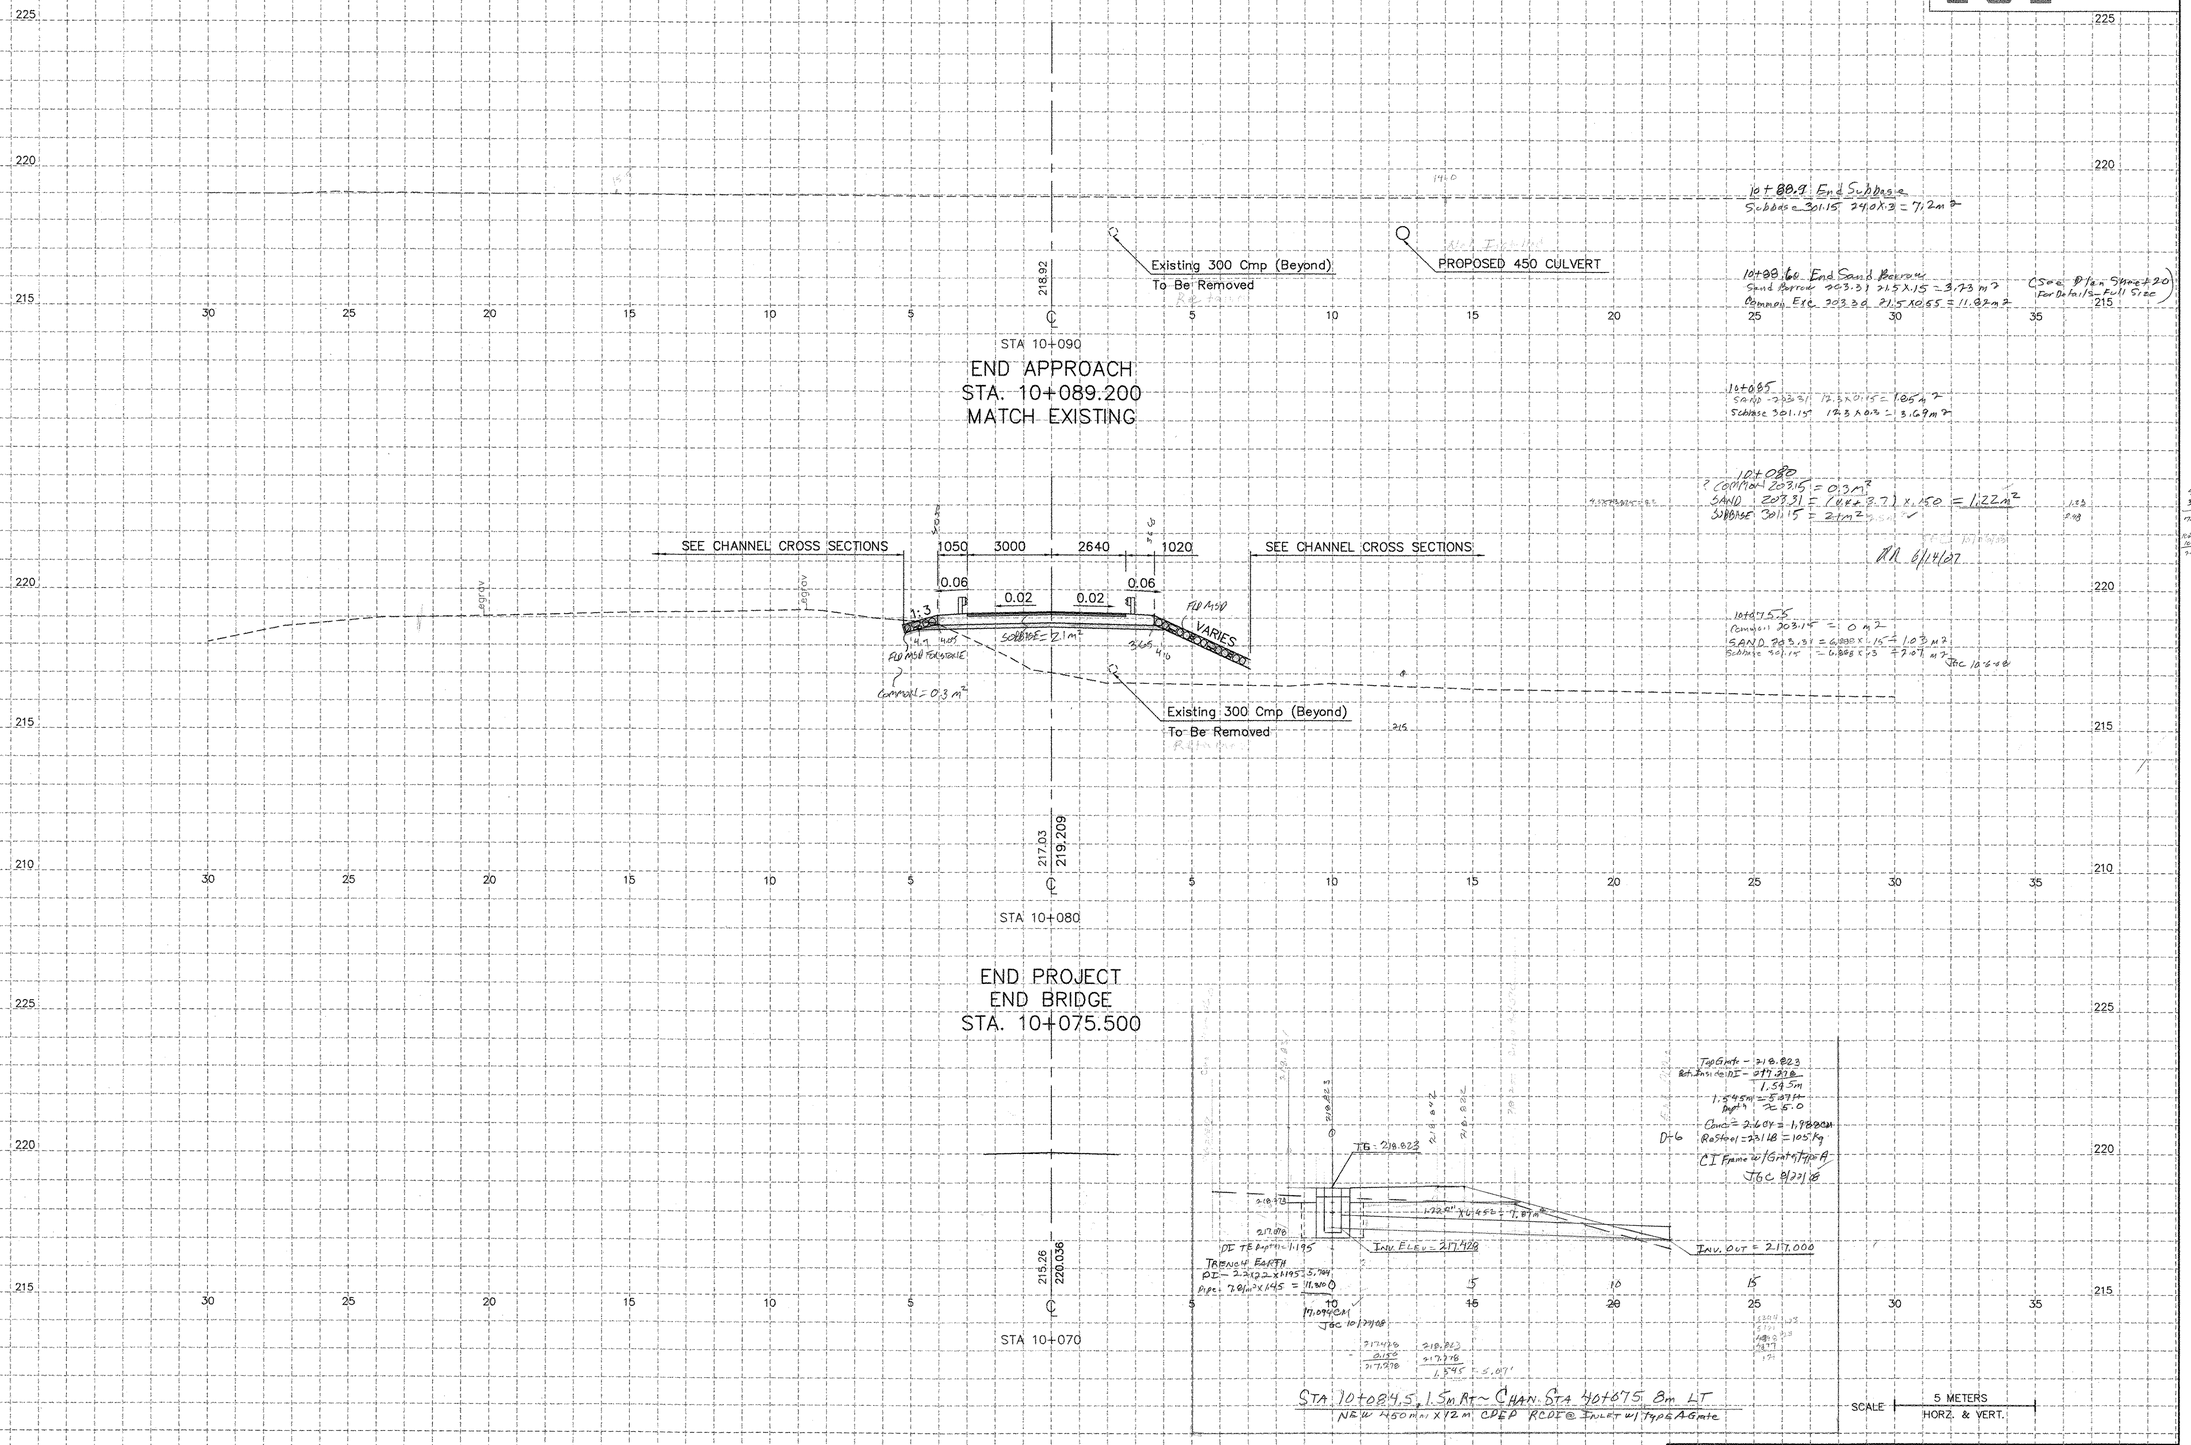

FROM STA. 10+070	TO 10+090	TH 29
PROJECT NAME	CAVENDISH BR. #45	
NO.	BRO 1442(23)	
SURVEYED BY	BRUNO ASSOCIATES INC. PC.	9/95
SHEET 35 OF 47 SHEETS		

VANASSE HANGEN BRUSTLIN, INC.

50499-XS PLOTTED 5/15/2006