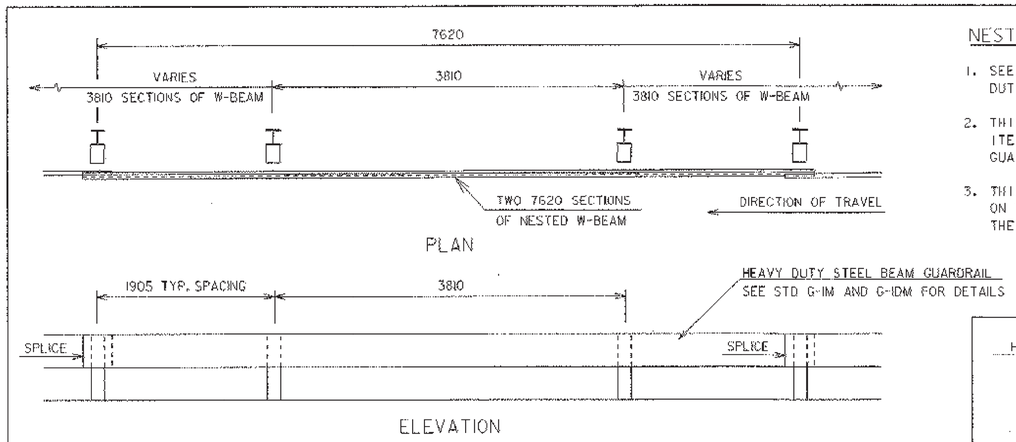

NESTED W-BEAM DETAIL

NTS

NESTED W-BEAM NOTES

1. SEE STANDARD G-1M FOR HEAVY DUTY STEEL BEAM GUARDRAIL DETAILS.
2. THIS WORK SHALL BE PAID UNDER ITEM 621.21 HEAVY DUTY STEEL BEAM GUARDRAIL AT A PAY FACTOR OF 1.0.
3. THIS DETAIL TO BE USED AS INDICATED ON THIS SHEET OR AS DIRECTED BY THE RESIDENT ENGINEER.

HEAVY DUTY STEEL BEAM GUARD RAIL (NESTED)

STA 1+008.2 RT - STA 1+015.8 RT
STA 1+012.0 LT - STA 1+019.6 LT

CONSTRUCT STONE FILL, TYPE I DITCH

STA 1~~+040.0~~ 030.7 LT - STA 1+050 LT

STA 0+989.2 - 1+012 LT

REMOVAL OF EXISTING GUIDE POSTS

STA 1+010.6 RT
STA 1+013.9 LT
STA 1+020.7 LT
STA 1+027.9 LT

HEAVY DUTY STEEL BEAM GUARD RAIL

STA 0+986.0 RT - STA 1+008.2 RT
STA 1+015.8 RT - STA 1+048.8 RT
STA 1+000.9 LT - STA 1+012.0 LT
STA 1+019.6 LT - STA 1+035.3 LT

ANCHORS FOR STEEL BEAM GUARD RAIL

STA 0+987.5 RT
STA 1+002.4 LT
STA 1+046.9 RT
STA 1+033.5 LT

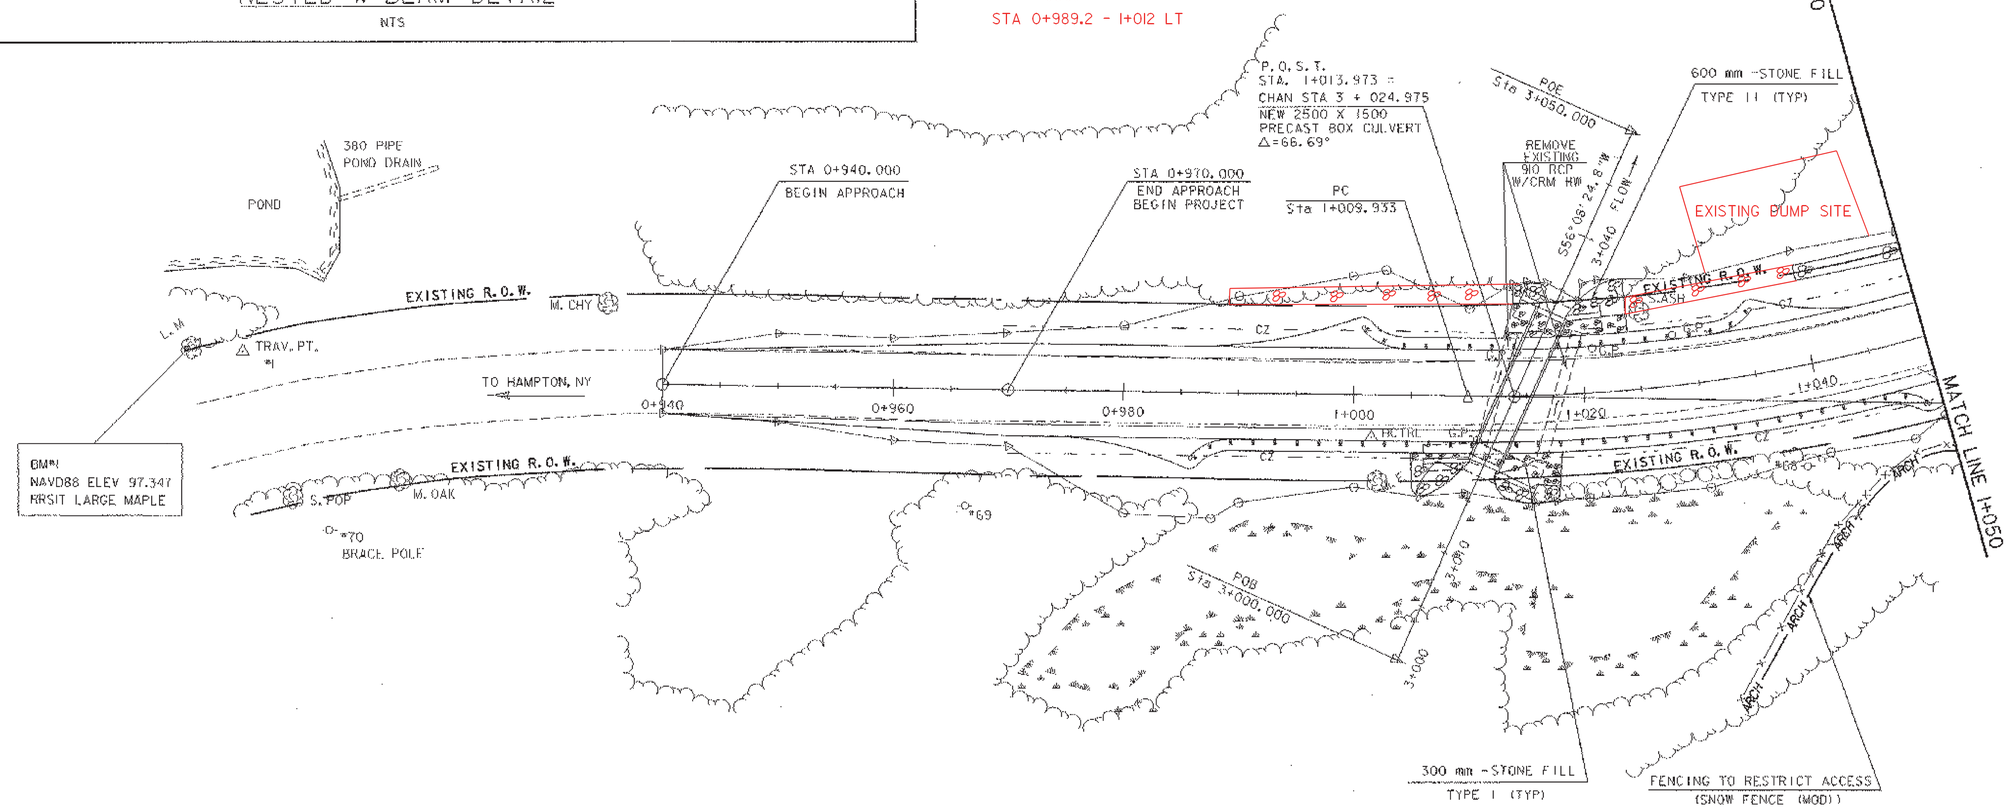

TOWN OF HAMPTON, N.Y.

0 10 20
SCALE 1:250

SHEET NAME: LAYOUT SHEET 1	
PROJECT NAME: FAIR HAVEN-HAMPTON PROJECT NUMBER: BRO 1443(32)	HIGHWAY NO.: TH 6 BRIDGE NO.: 6 OVER: POULTNEY RIVER
FILE NAME: /strl/93j021/sj021bdr.dgn PROJECT MANAGER: G.S. ROGERS DESIGNED BY: C. MEUNIER BRIDGE SHEET NUMBER:	PLOT DATE: 28-JAN-2003 DRAWN BY: STRI IPARM NAME: sj021al.i SHEET 9 OF 93