Metric

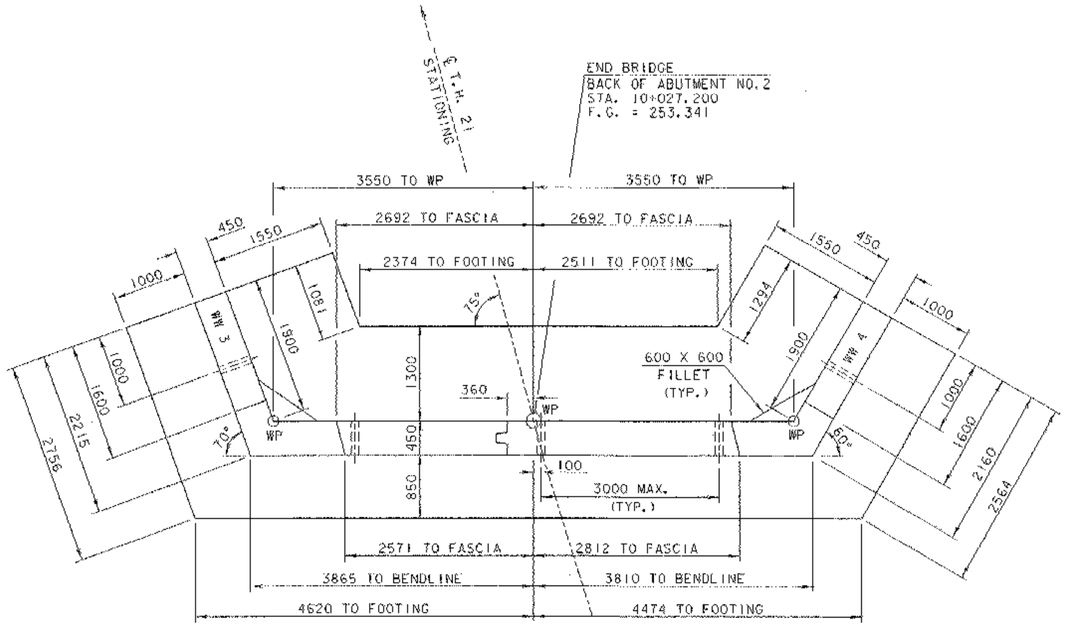

ABUTMENT NO. 2 PLAN

0 1 2 3 4

SCALE = 1:40

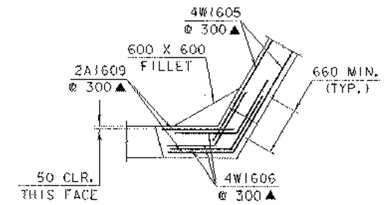

WINGWALL NO. 4
CORNER REINFORCING DETAIL
ABOVE BRIDGE SEAT

(WINGWALL NOS. 1, 2 & 3 SIMILAR)

0 1 2 3 4

SCALE = 1:40

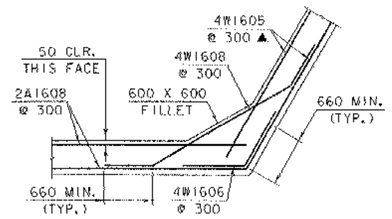

WINGWALL NO. 4
CORNER REINFORCING DETAIL
BELOW BRIDGE SEAT

(WINGWALL NOS. 1, 2 & 3 SIMILAR)

0 1 2 3 4

SCALE = 1:40

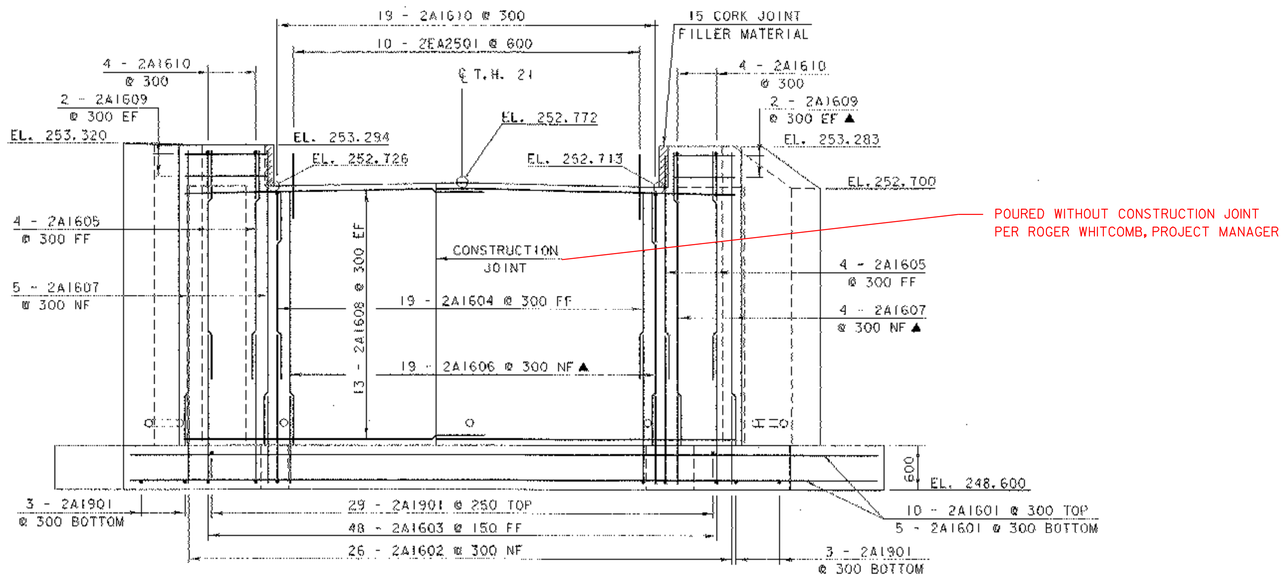

POURED WITHOUT CONSTRUCTION JOINT
PER ROGER WHITCOMB, PROJECT MANAGER

ABUTMENT NO. 2 ELEVATION

0 1 2 3 4

SCALE = 1:40

NOTE:

NF = NEAR FACE
FF = FAR FACE
EF = EACH FACE
▲ = CUT TO FIT IN FIELD
80 CLR. UNLESS OTHERWISE SPECIFIED ON THE PLANS.

STATE OF VERMONT
AGENCY OF TRANSPORTATION

Town Of HUNTINGTON	Bridge No. 34
Highway No. T.H. 21	Log Sta. / Surv. Sta.
T.H. 21 OVER BRUSH BROOK	
ABUTMENT NO. 2 DETAILS	
Designed By J. LACROIX	Drawn By M. LOZIER
Checked By M. LOZIER Date 5/03	Project Manager R.R. WHITCOMB Date 6/03
PROJECT HUNTINGTON	PROJECT NO. BR01445 (21)
M.G.C. Info. str3/93j029/sj029abdgn	sj029ab21
Bridge Sheet No.	Sheet 18 of 34