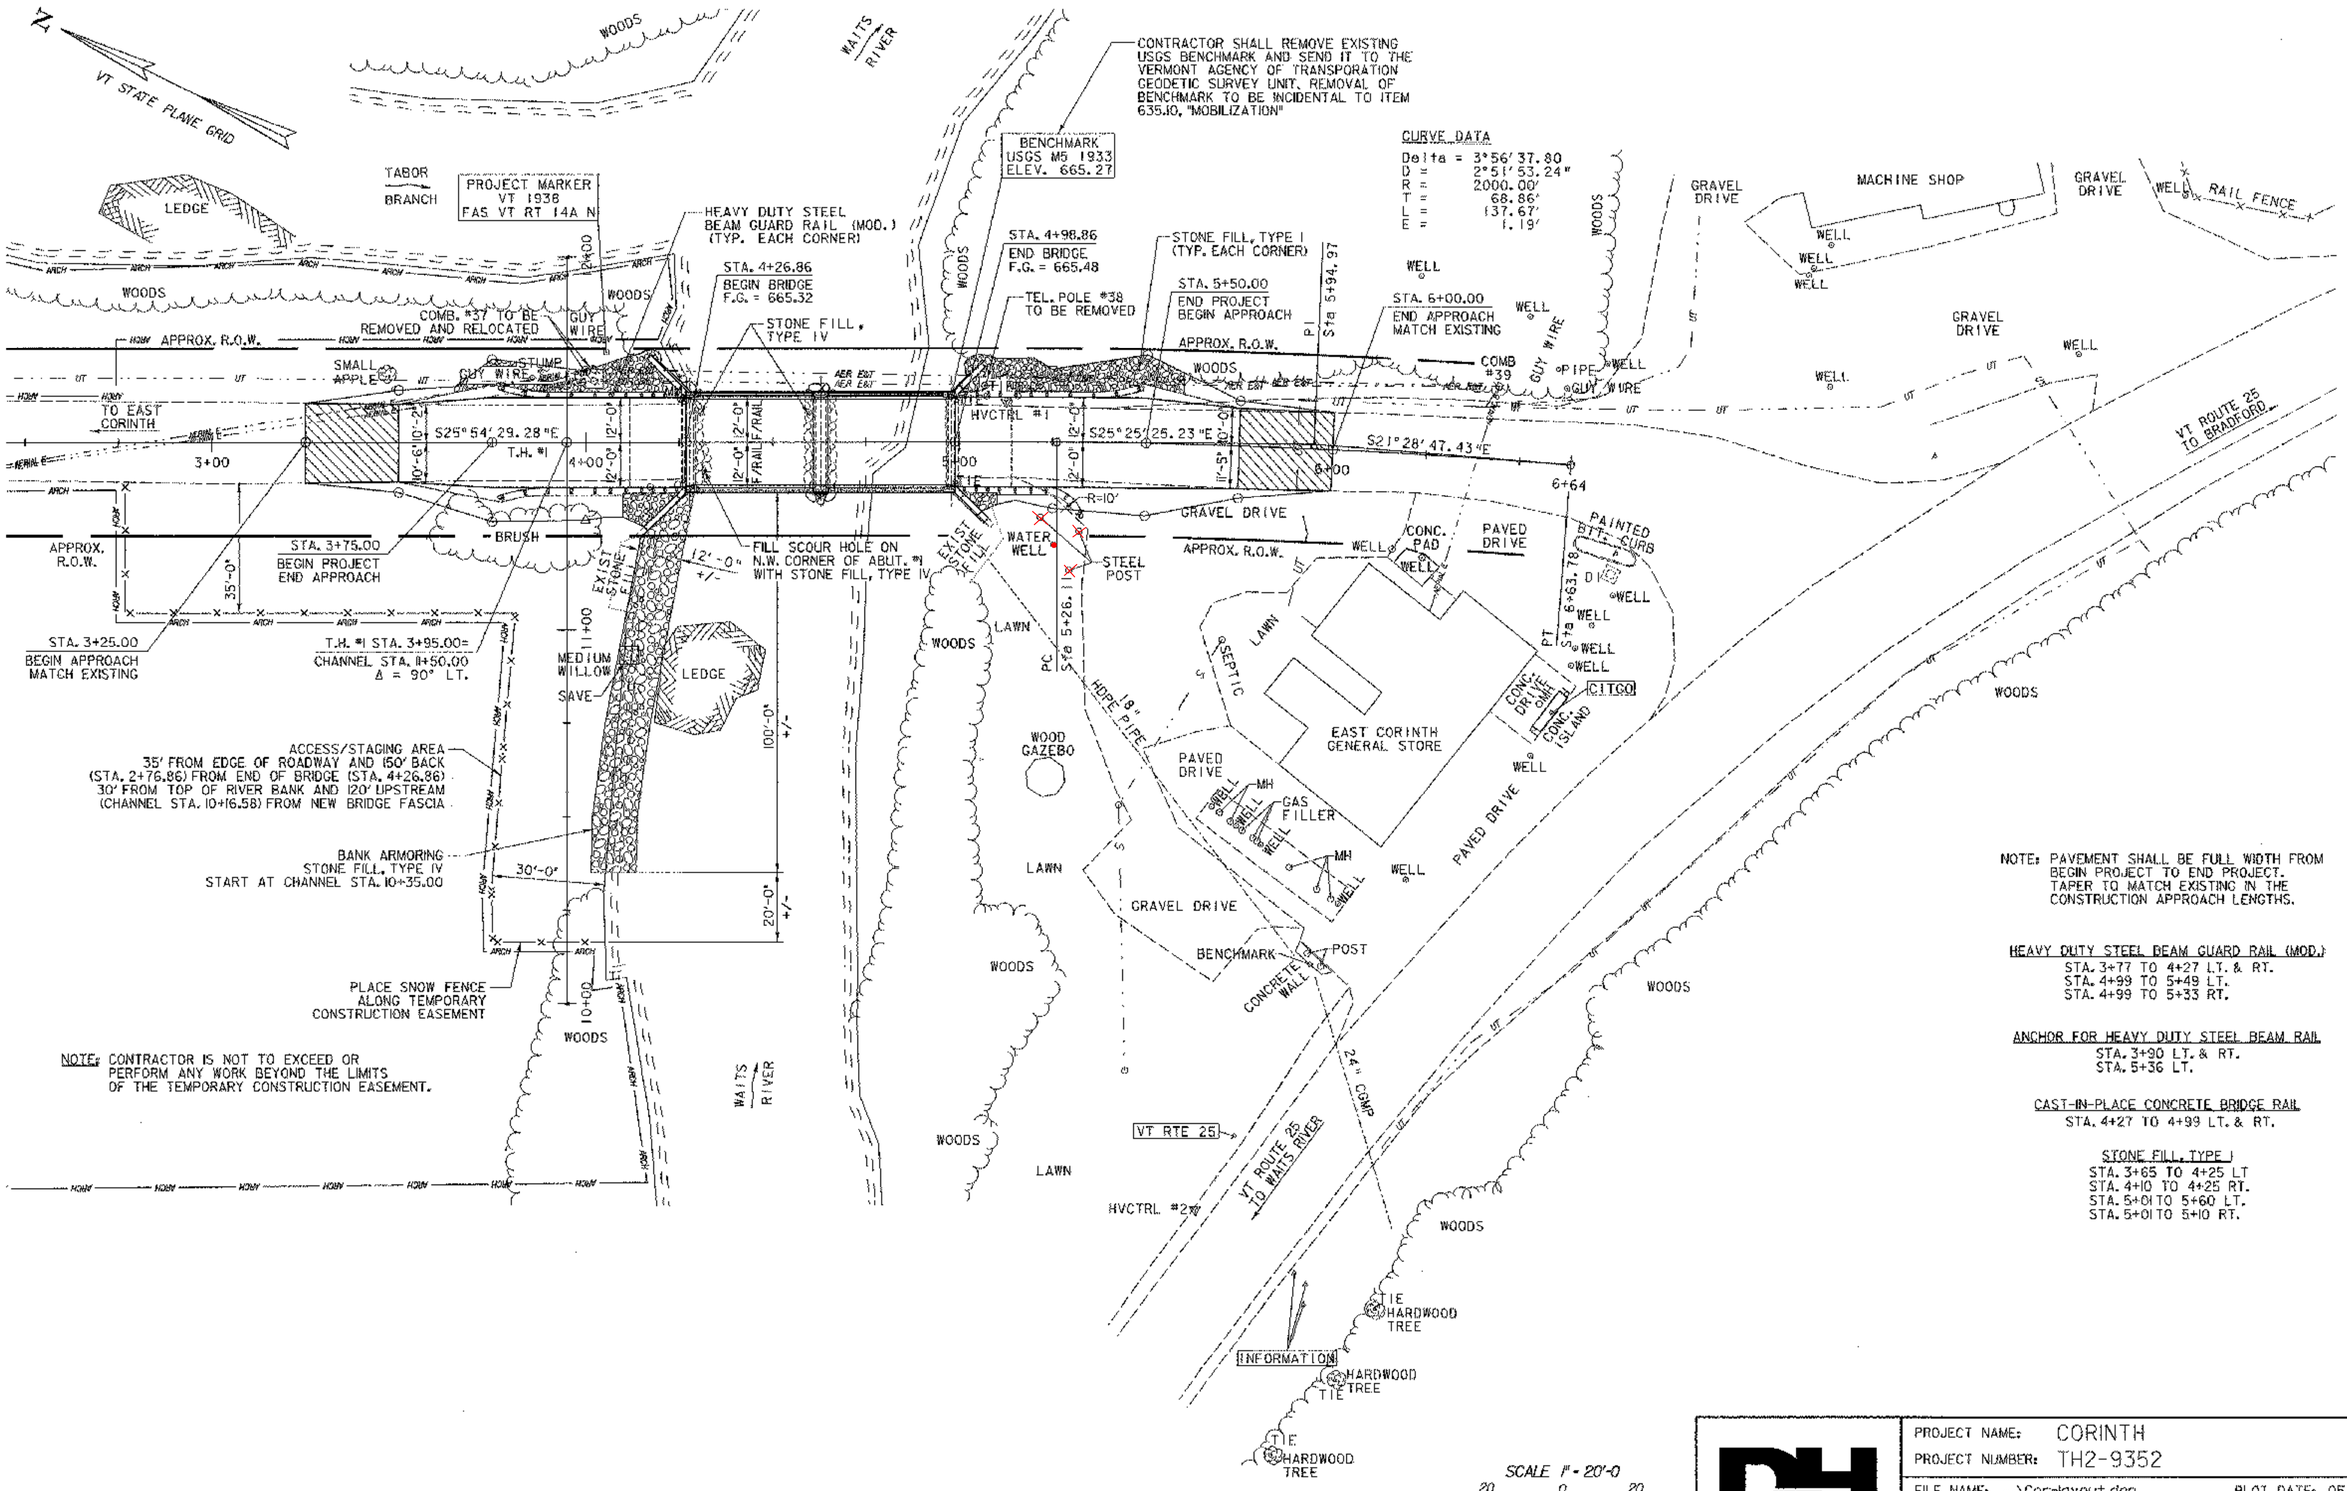

NOTE: PAVEMENT SHALL BE FULL WIDTH FROM BEGIN PROJECT TO END PROJECT. TAPER TO MATCH EXISTING IN THE CONSTRUCTION APPROACH LENGTHS.

HEAVY DUTY STEEL BEAM GUARD RAIL (MOD.)
STA. 3+77 TO 4+27 LT. & RT.
STA. 4+99 TO 5+49 LT.
STA. 4+99 TO 5+33 RT.

ANCHOR FOR HEAVY DUTY STEEL BEAM RAIL
STA. 3+90 LT. & RT.
STA. 5+36 LT.

CAST-IN-PLACE CONCRETE BRIDGE RAIL
STA. 4+27 TO 4+99 LT. & RT.

STONE FILL, TYPE I
STA. 3+65 TO 4+25 LT
STA. 4+10 TO 4+25 RT.
STA. 5+01 TO 5+60 LT.
STA. 5+01 TO 5+10 RT.

Dufresne-Henry

PROJECT NAME: CORINTH
PROJECT NUMBER: TH2-9352

FILE NAME: ...\Cor-layout.dgn
PROJECT LEADER: MJC
DESIGNED BY: SEB
LAYOUT SHEET

PLOT DATE: 05/07/2003
DRAWN BY: SEB
CHECKED BY: MJC
SHEET 7 OF 28