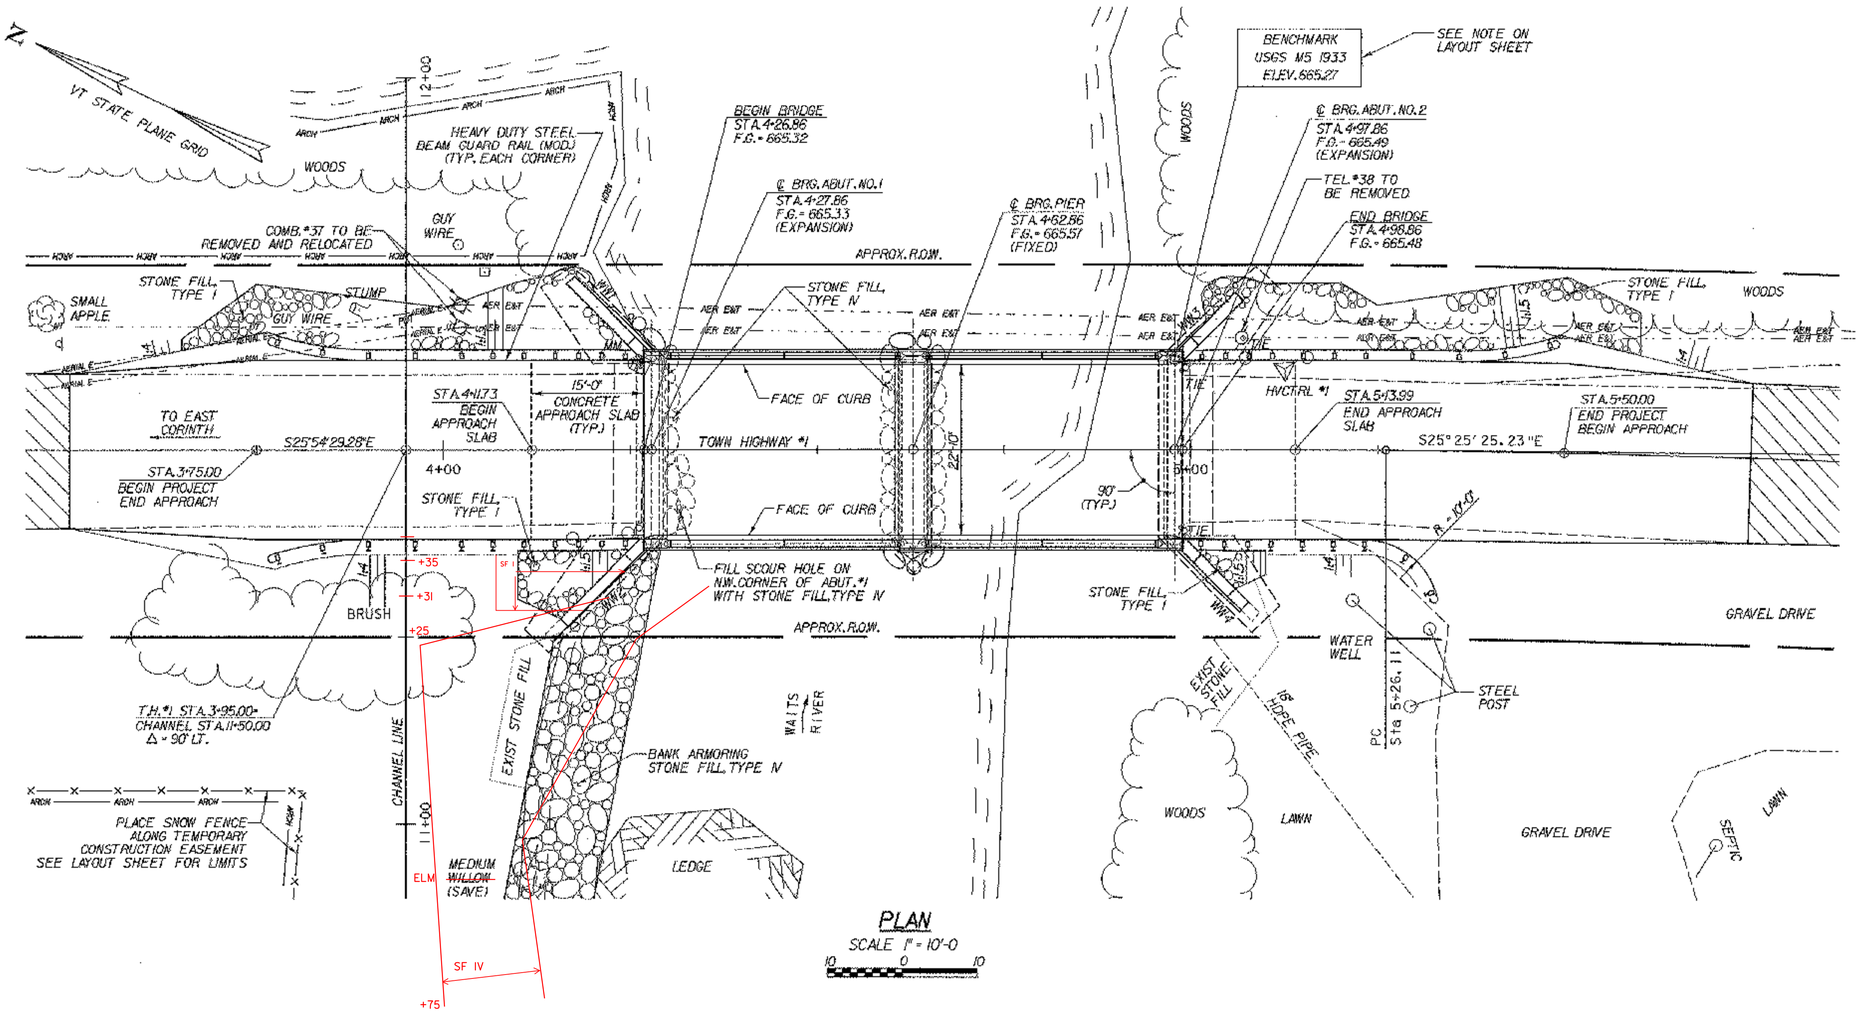

PLAN

SCALE 1" = 10'-0

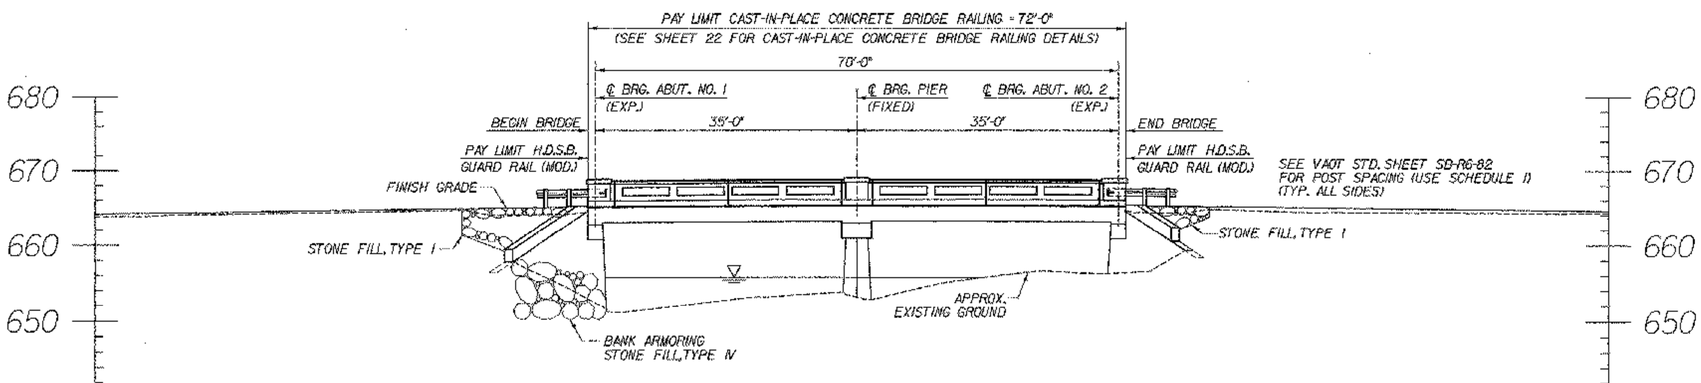

ELEVATION

SCALE 1" = 10'-0

STATE OF VERMONT
AGENCY OF TRANSPORTATION

Town Of CORINTH	Bridge No. 10C
Highway No. T.H. 1	Log Sta. / Surv. Std.
TOWN HIGHWAY NO. 1 OVER WAITS RIVER	
PLAN & ELEVATION	
Designed By S. BURBANK	Drawn By A. THIBAULT
Checked By M. CHENETTE Date 05/03	Bridge Design Supervisor M. CHENETTE Date 05/03
PROJECT CORINTH	PROJECT NO. TH2-9352
DH CAD Filename: ...\Cor-plan.dgn	Plot Date: 05/07/2003
Bridge Sheet No.	Sheet 12 of 28

Dufresne-Henry