Metric

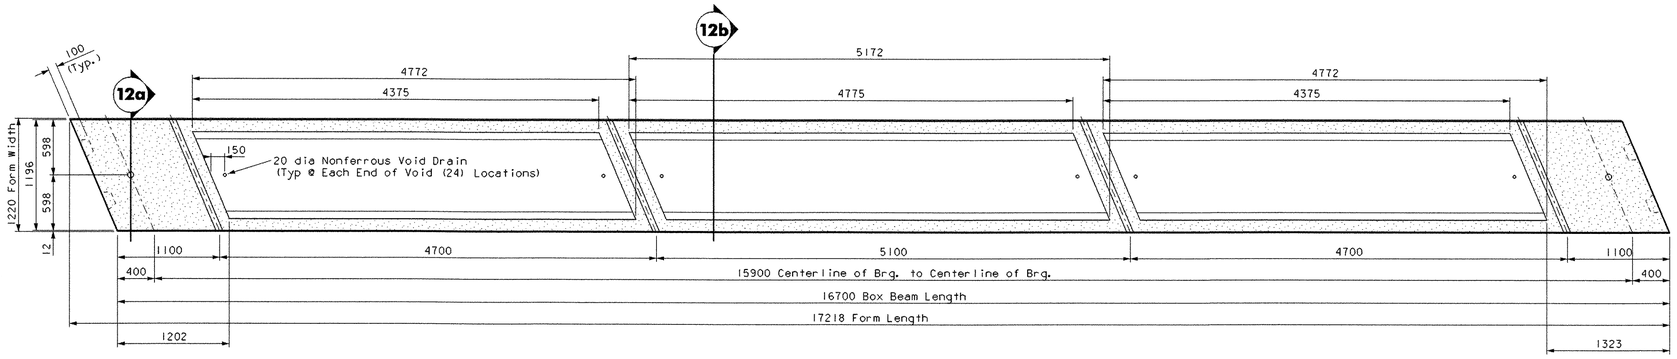

9 BOX BEAM 2, 3, 4, 5 DIMENSIONAL PLAN @ STRAND ELEVATION

1:30

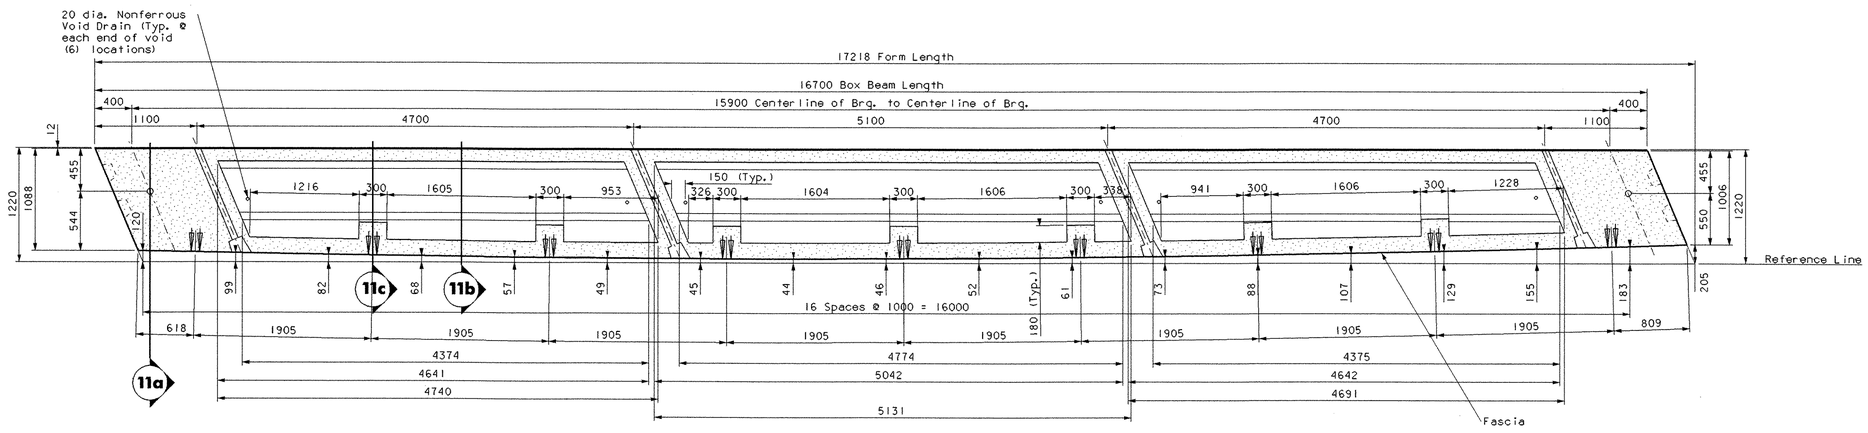

10 BOX BEAM 6 DIMENSIONAL PLAN @ STRAND ELEVATION

1:30

RIGHT FASCIA /INTERIOR PRESTRESSED BOX BEAM DETAILS

PROJECT NAME: Charleston	
PROJECT NUMBER: BRO 1449 (22)	
FILE NAME: 93J051/STR. /sj051psl.dgn	PLOT DATE: 13-APR-2006
PROJECT MANAGER: M. EVANS-MONGEON	DRAWN BY: G. Colgrove
DESIGNED BY: George Colgrove	CHECKED BY: S. Scribner
IPARM: sj051ps3.i	SHEET 30 OF 50