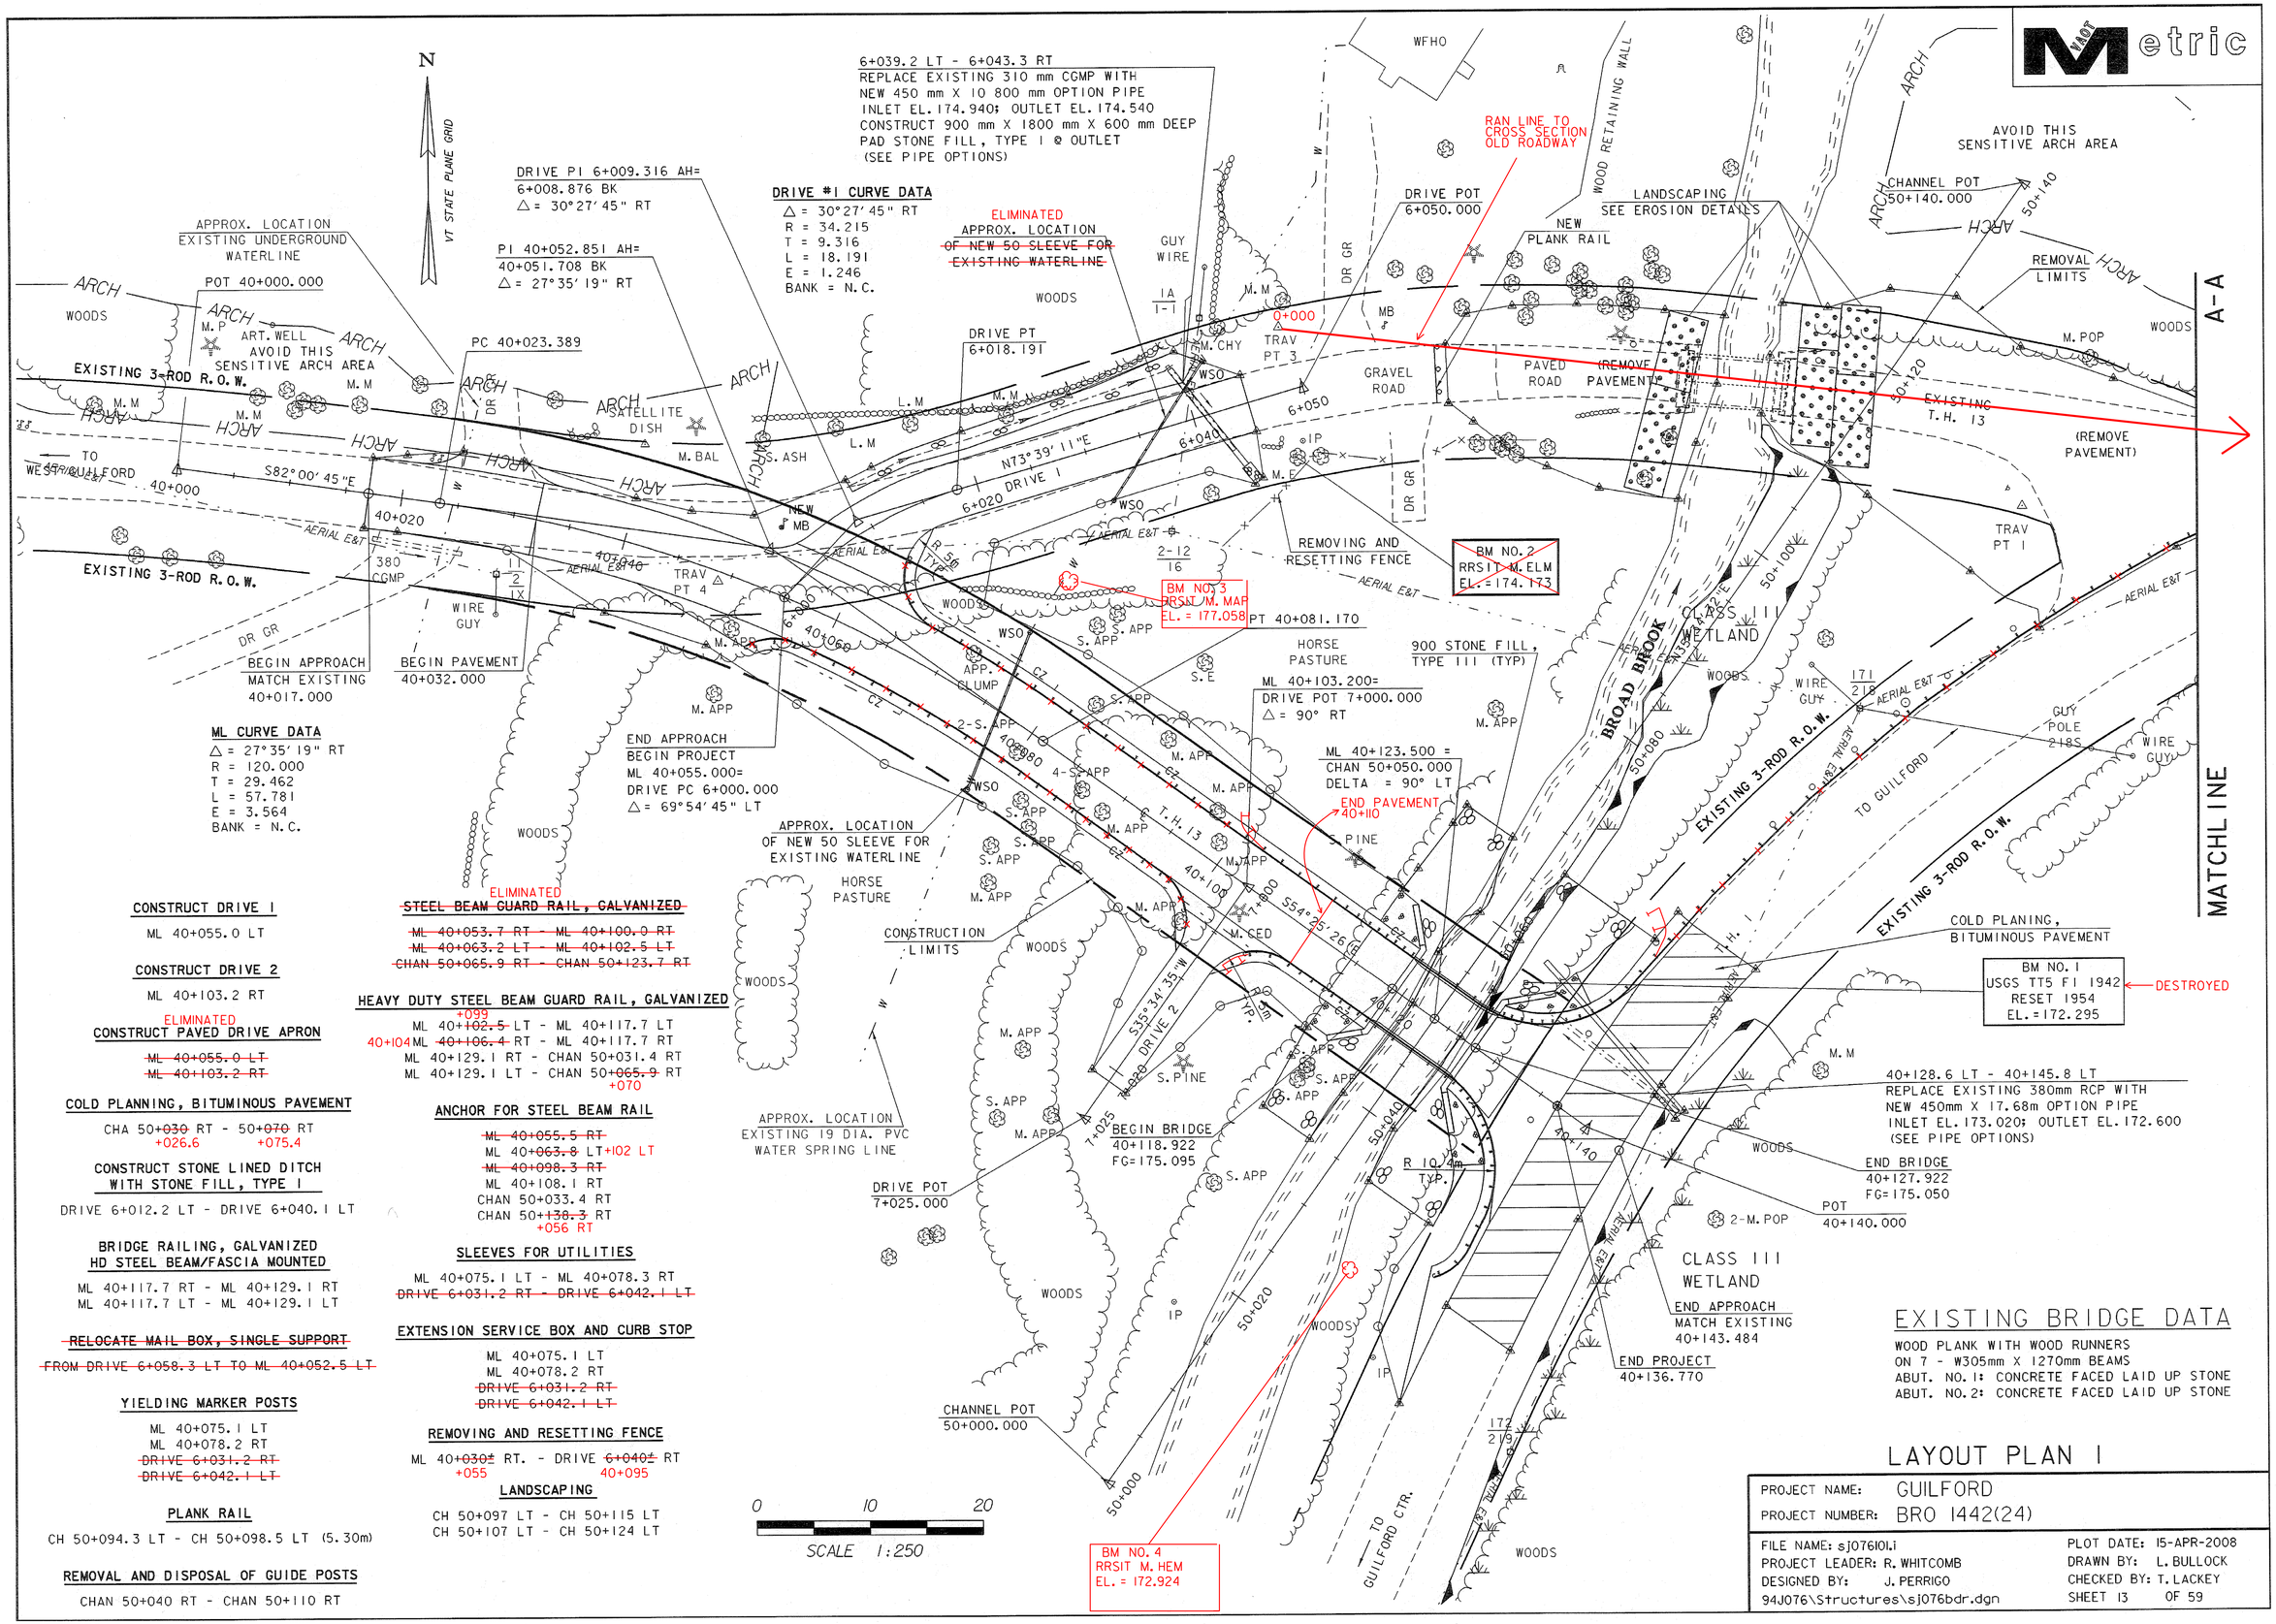

EXISTING BRIDGE DATA

WOOD PLANK WITH WOOD RUNNERS
ON 7 - W305mm X 1270mm BEAMS
ABUT. NO. 1: CONCRETE FACED LAID UP STONE
ABUT. NO. 2: CONCRETE FACED LAID UP STONE

LAYOUT PLAN 1

PROJECT NAME: GUILFORD	
PROJECT NUMBER: BRO 1442(24)	
FILE NAME: sj076101.i	PLOT DATE: 15-APR-2008
PROJECT LEADER: R. WHITCOMB	DRAWN BY: L. BULLOCK
DESIGNED BY: J. PERRIGO	CHECKED BY: T. LACKEY
94J076\Structures\sj076bdr.dgn	SHEET 13 OF 59