Guilford BRO 1442(24)

Old Bonnyvale Road Cross Sections

Project Sheet # 11 of 28

Zero @ 0+015

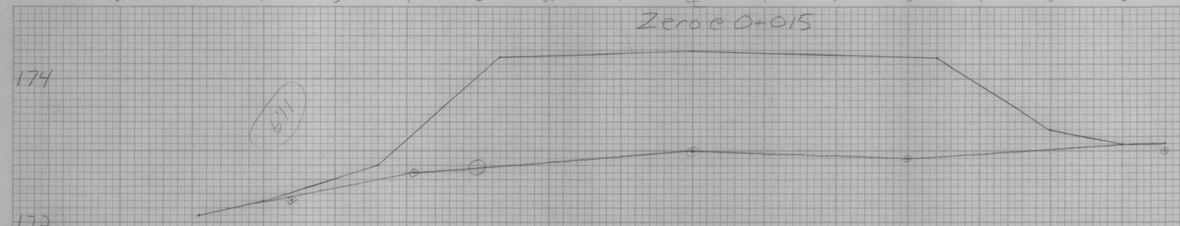

0+025

Unclassified Exc = 11.9 m²

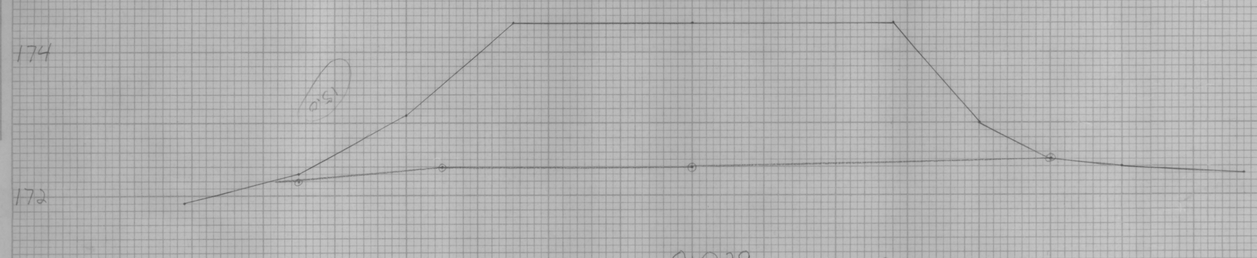

0+029

Unclassified Exc = 15.0 m²

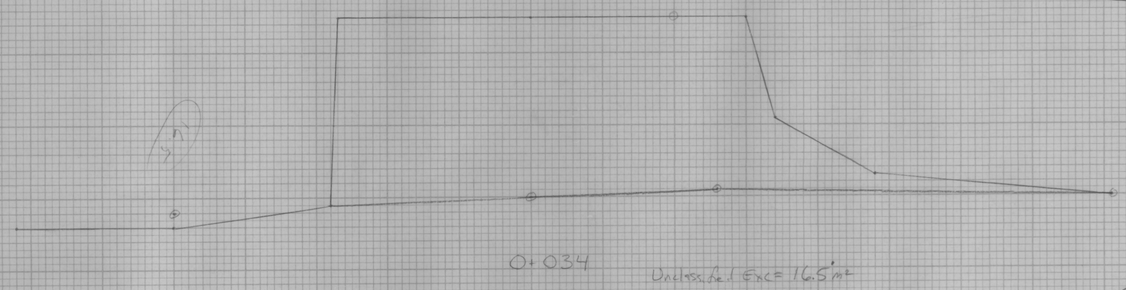

0+034

Unclassified Exc = 16.5 m²

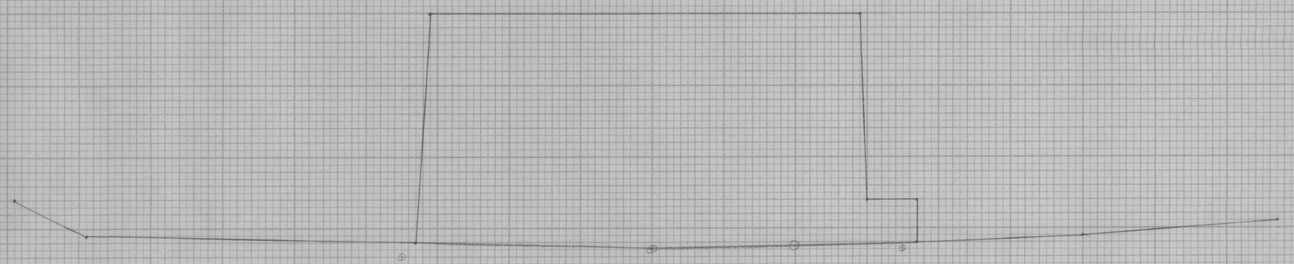

0+038 (Both-back)

Unclassified Exc = 20.4 m²

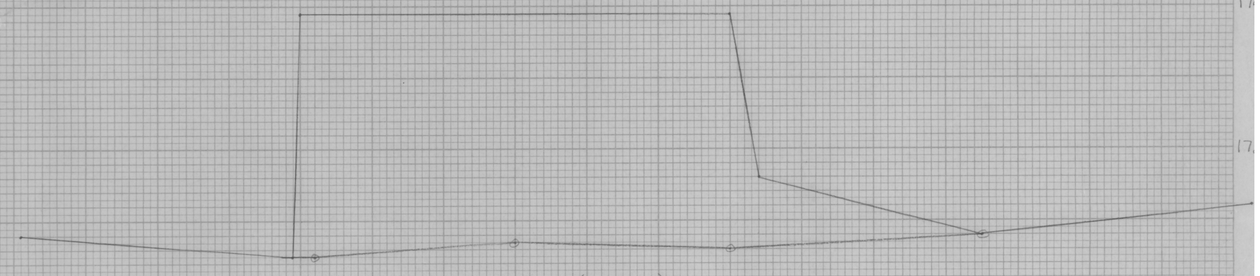

0+045 (Both-ahead)

Unclassified Exc = 22.2 m²

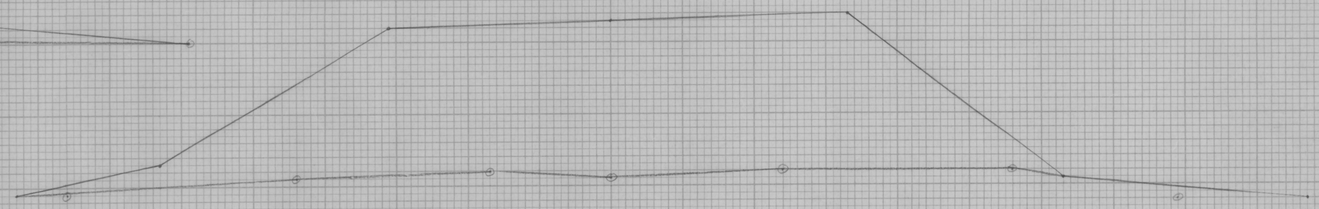

0+050

Unclassified Exc = 21.0 m²

for 6/4/08

✓ M.W.H. 1/26/10

ORIGINAL SURVEY — SURVEYED, PLOTTED, TEMPLATE, NOTE BOOK, NO., AREAS CHECKED, BY, DATE

FINAL SURVEY — SURVEYED, PLOTTED, TEMPLATE, NOTE BOOK, NO., AREAS CHECKED, BY, DATE