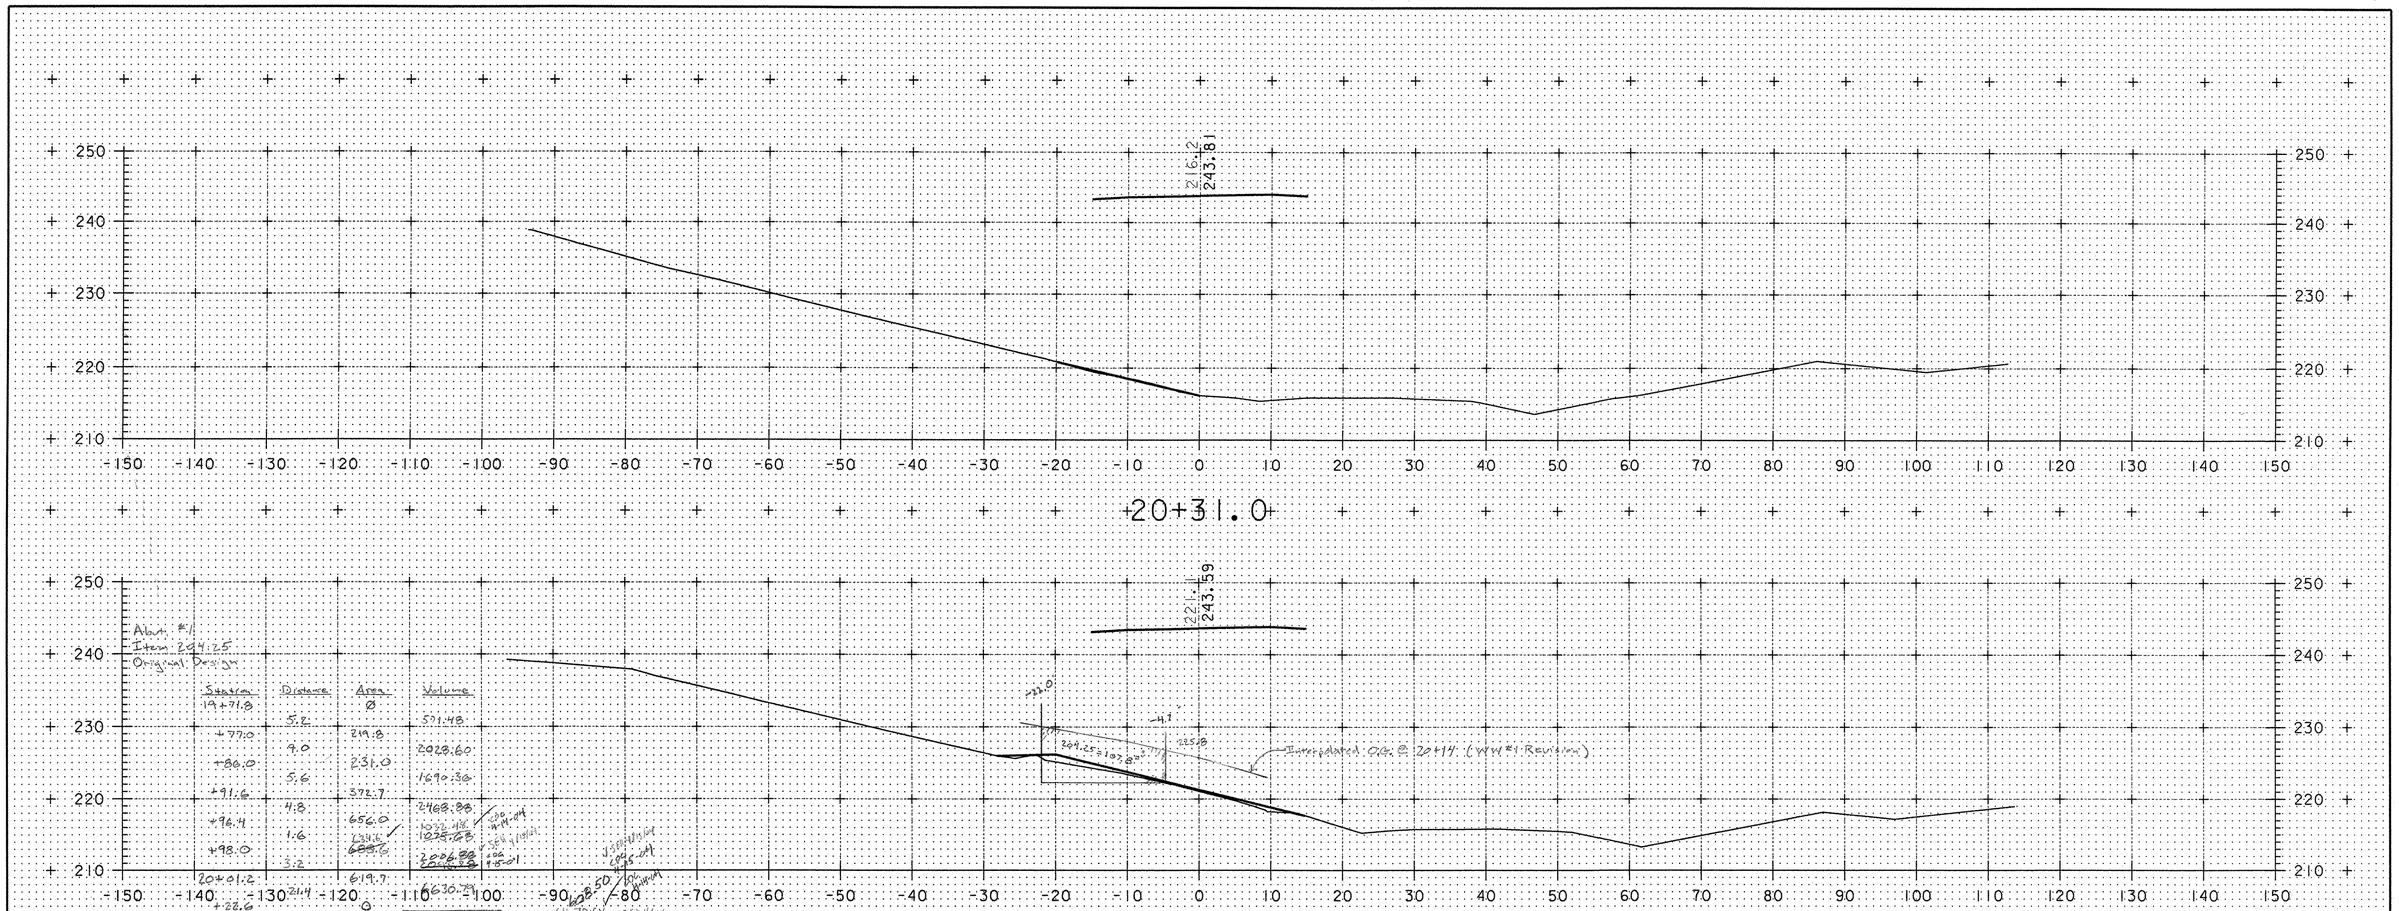

Abut. #1
Item 204.25
Original Design

Station	Distance	Area	Volume
19+71.8		Ø	
	5.2		571.48
+77.0		219.8	
	9.0		2028.60
+86.0		231.0	
	5.6		1690.36
+91.6		372.7	
	4.8		2468.88
+96.4		656.0	
	1.6		1072.48
+98.0		1346.6	
		685.6	1275.68
	3.2		2006.88
20+01.2		619.7	
			6630.23

16559.03 (1/27) = 613.30 CY

16129.47

CDC 4-5-04

PAY REVISED

Abut. #1
Item 204.25
Wing Wall #1 Revised

Station	Dist.	Area	Volume
19+71.8		Ø	
	5.2		571.48
+77.0		219.8	
	9.0		2028.60
+86.0		231.0	
	5.6		1690.36
+91.6		372.7	
	3.4		1398.25
+95 (BK)		449.8	
+95 (AH)		634.1	
	19.0		7048.05
20+14.0		107.8	
	7.3		393.47
+21.3		Ø	

13130.21 (1/27) = 486.3 CY

CDC 4-5-04

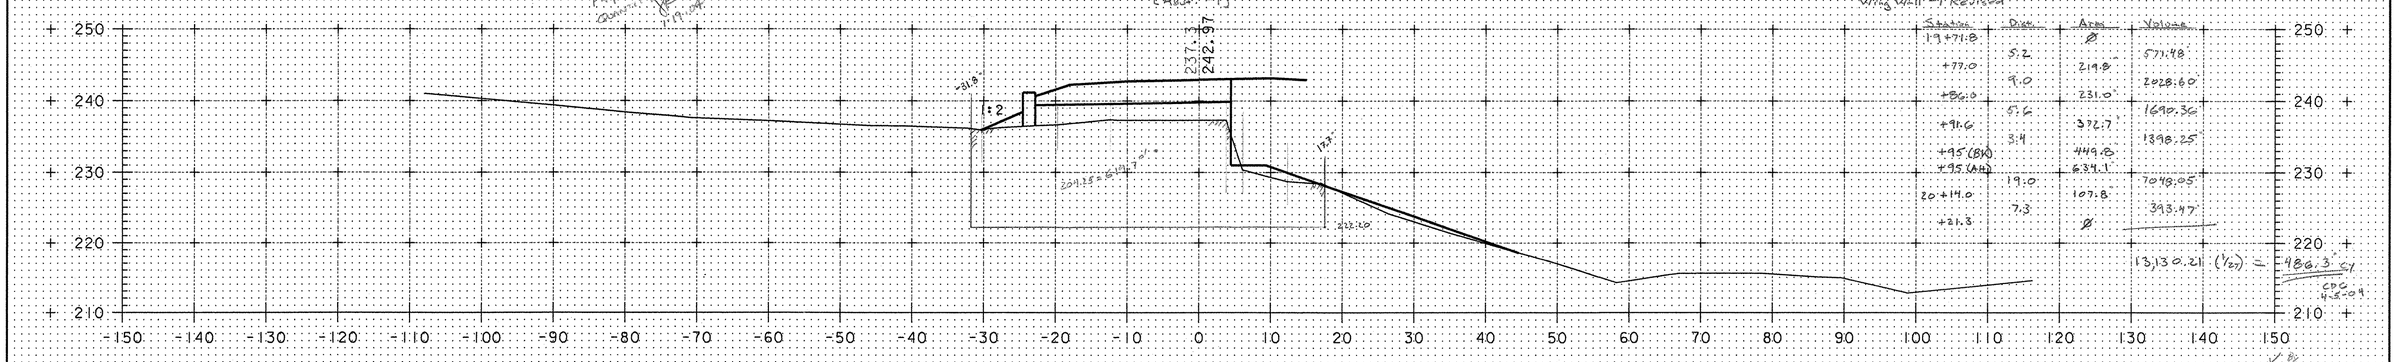

✓ By SEH 4/13/04

Item 204.25, Structure Excavation

SCALE 1" = 10'-0

BOSTWICK ROAD

PROJECT NAME: SHELBURNE
PROJECT NUMBER: BRO J445(30)

FILE NAME: m:\1595402 Bostwick\HWY\INROADS\BRC-Construction Sections.x
PROJECT LEADER: MBZ
PLOT DATE: 12-FEB-2004
DESIGNED BY: DMB
DRAWN BY: DMB
CHECKED BY: MDL
SHEET 3 OF 6

102 SE