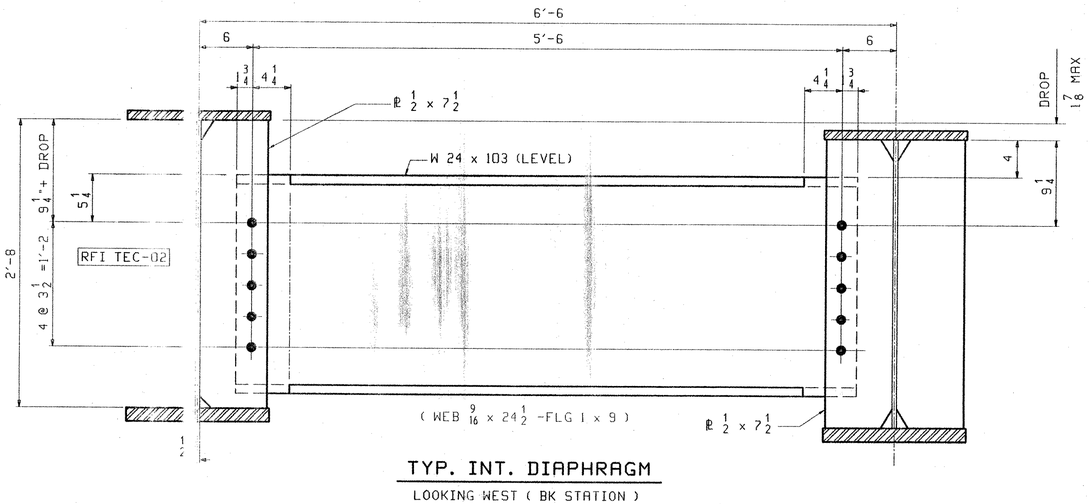

TYP. INT. DIAPHRAGM

LOOKING WEST (BK STATION)

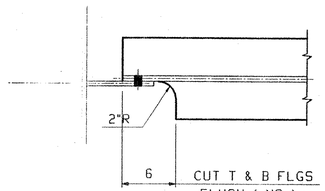

**** NOTE ****
THE PURPOSE OF THIS DRAWING IS TO COORDINATE GEOMETRIC CONTROL INFORMATION AND CONNECTION SPACING. THIS DWG IS SUBMITTED FOR INFORMATION ONLY & IS NOT INTENDED FOR SHOP FABRICATION. DETAIL DWGS WILL SHOW ALL WELDING AND DIMENSIONS REQ'D FOR FABRICATION.

MATL A709-50W
HOLES ... 15/16 Ø
BOLTS.... 7/8 Ø A325-3

RECEIVED
CK'D BY _____ OK'D BY _____
DEC 09 2003
RESUBMIT _____ APPROVED
BY RKW DATE 1-8-04

REV.	REMARKS	DATE	DWN	CHK	APP	Q.A.	NO.	DIA.	LGT	TYPE	WASHER
	OUT FOR APPROVAL	12/03									
	OUT FOR APPROVAL										
	ISSUED TO SHOP										
	FIELD & OFFICE										

MATERIAL:	ELECTRODES:	HOLES:	SHOP BOLTS:

SURFACE PREP. & PAINT:

DESCRIPTION: LAYOUTS	DRAWN BY	DATE
JOB: BOSTWICK ROAD OVER VERMONT RAILWAY	WJG	11/03
BRIDGE NO. 15 HIGHWAY NO. TH 3	CHKD BY	
TOWN OF SHELBURNE	JTB	11/14
ENGR: McFarland-Johnson, INC.	APPROV BY	
CONTRACTOR: S.D. IRELAND BROS. CORP.	SUPERVISOR	W. J. GATTI
PROJ NO. BRO 1445(30)	Q.A.	
CUSTOMER: VERMONT AGENCY OF TRANSPORTATION		

TENSOR 2409

CASCO BAY STEEL STRUCTURES, INC.
75 SPRING HILL ROAD SACO, MAINE 04072
PHONE (207) 282-7360 FAX. (207) 282-1179

JOB NO.	DRG. NO.
209	TD1
	REV. △

123 sc

F:\M Fri Nov 21 10:04:50 EST 2003 c:\revit_jobs\2409-TD1.Rev0