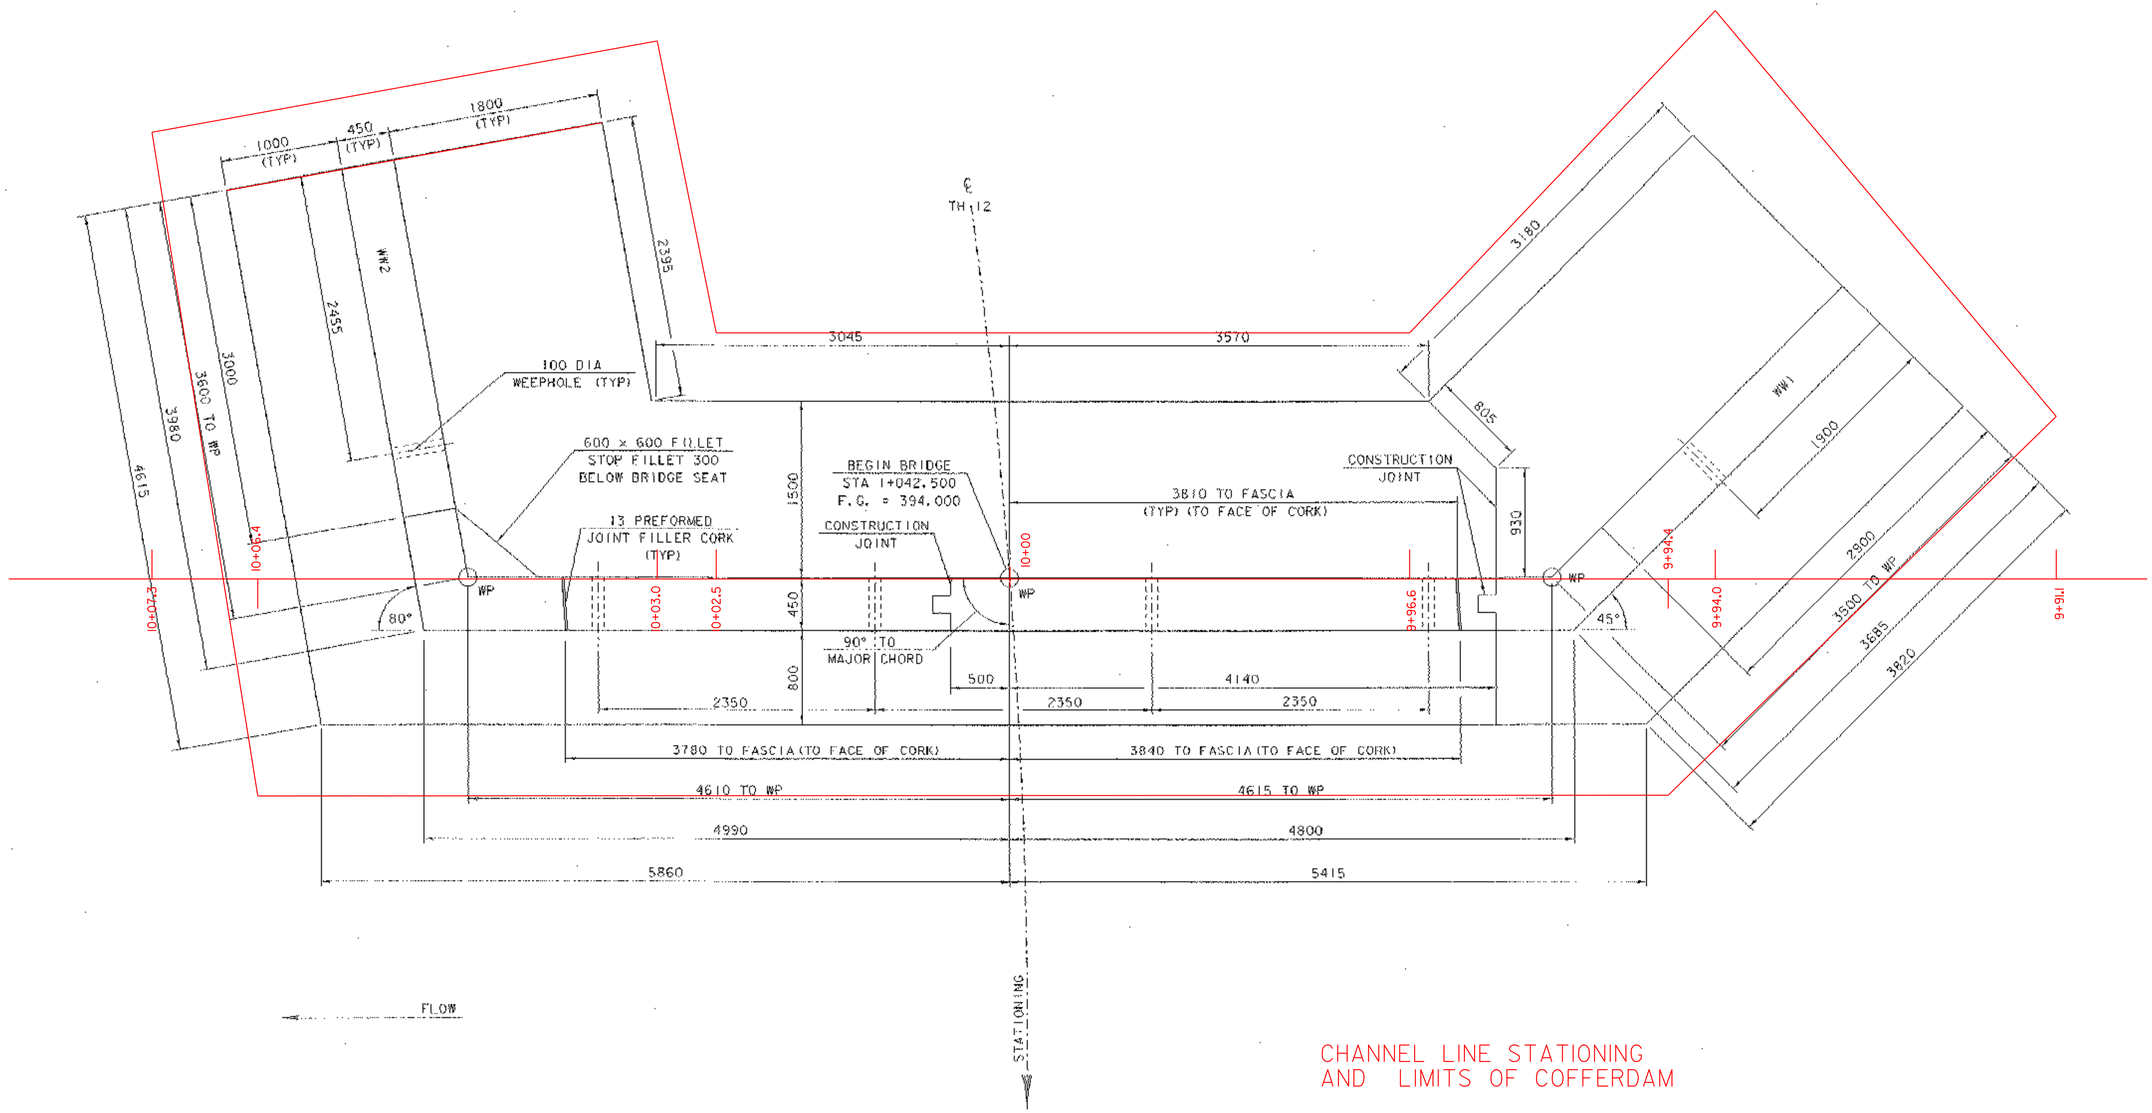

CHANNEL LINE STATIONING
AND LIMITS OF COFFERDAM

ABUTMENT #1 PLAN

SCALE: 1:25

SHEET NAME: **ABUTMENT #1 PLAN**	
PROJECT NAME: STAMFORD	HIGHWAY NO.: TH 12
PROJECT NUMBER: TH3 9411	BRIDGE NO.: 14
	OVER: LESURE BROOK
FILE NAME: /strl/94J072/sJ072sub.dgn	PLOT DATE: 16-OCT-2003
PROJECT MANAGER: G.S. ROGERS	DRAWN BY: J. GILMORE
DESIGNED BY: C. MEUNIER	IPARM NAME: sJ072ab1.I
BRIDGE SHEET NUMBER:	SHEET 23 OF 38