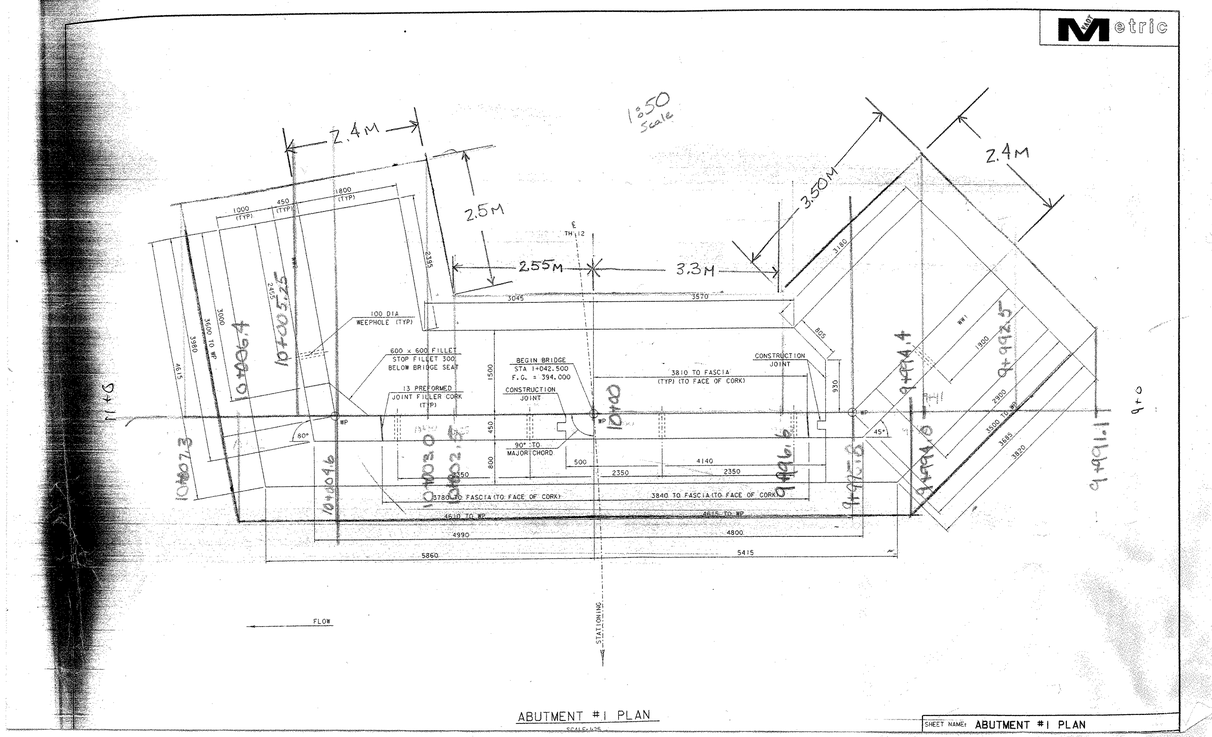

ABUTMENT #1 PLAN

SCALE: 1:75

SHEET NAME: ABUTMENT #1 PLAN

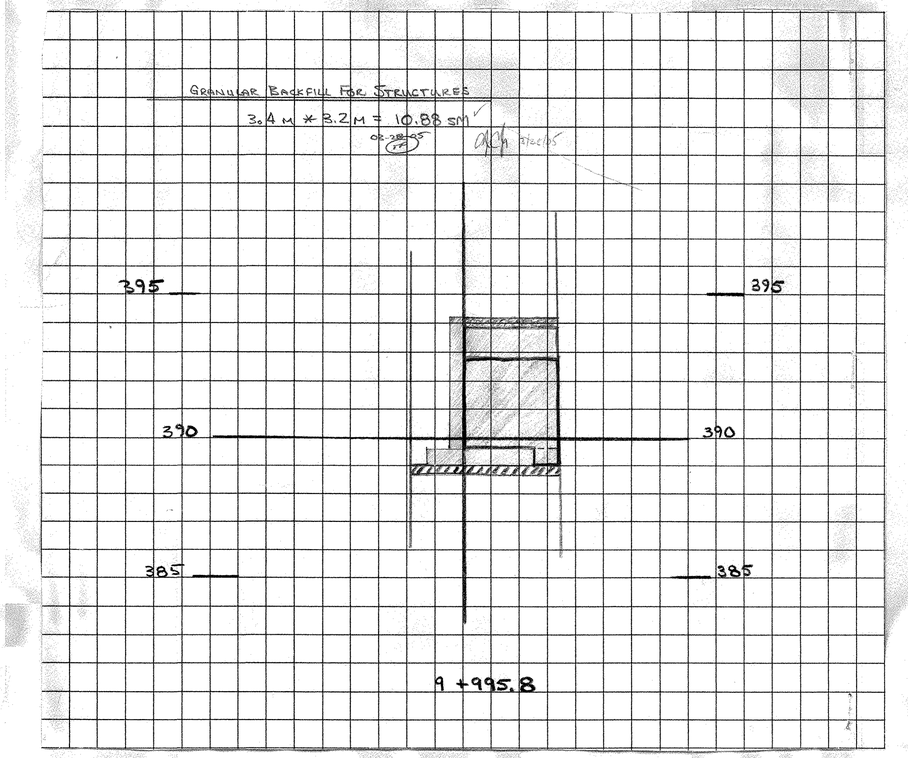

040