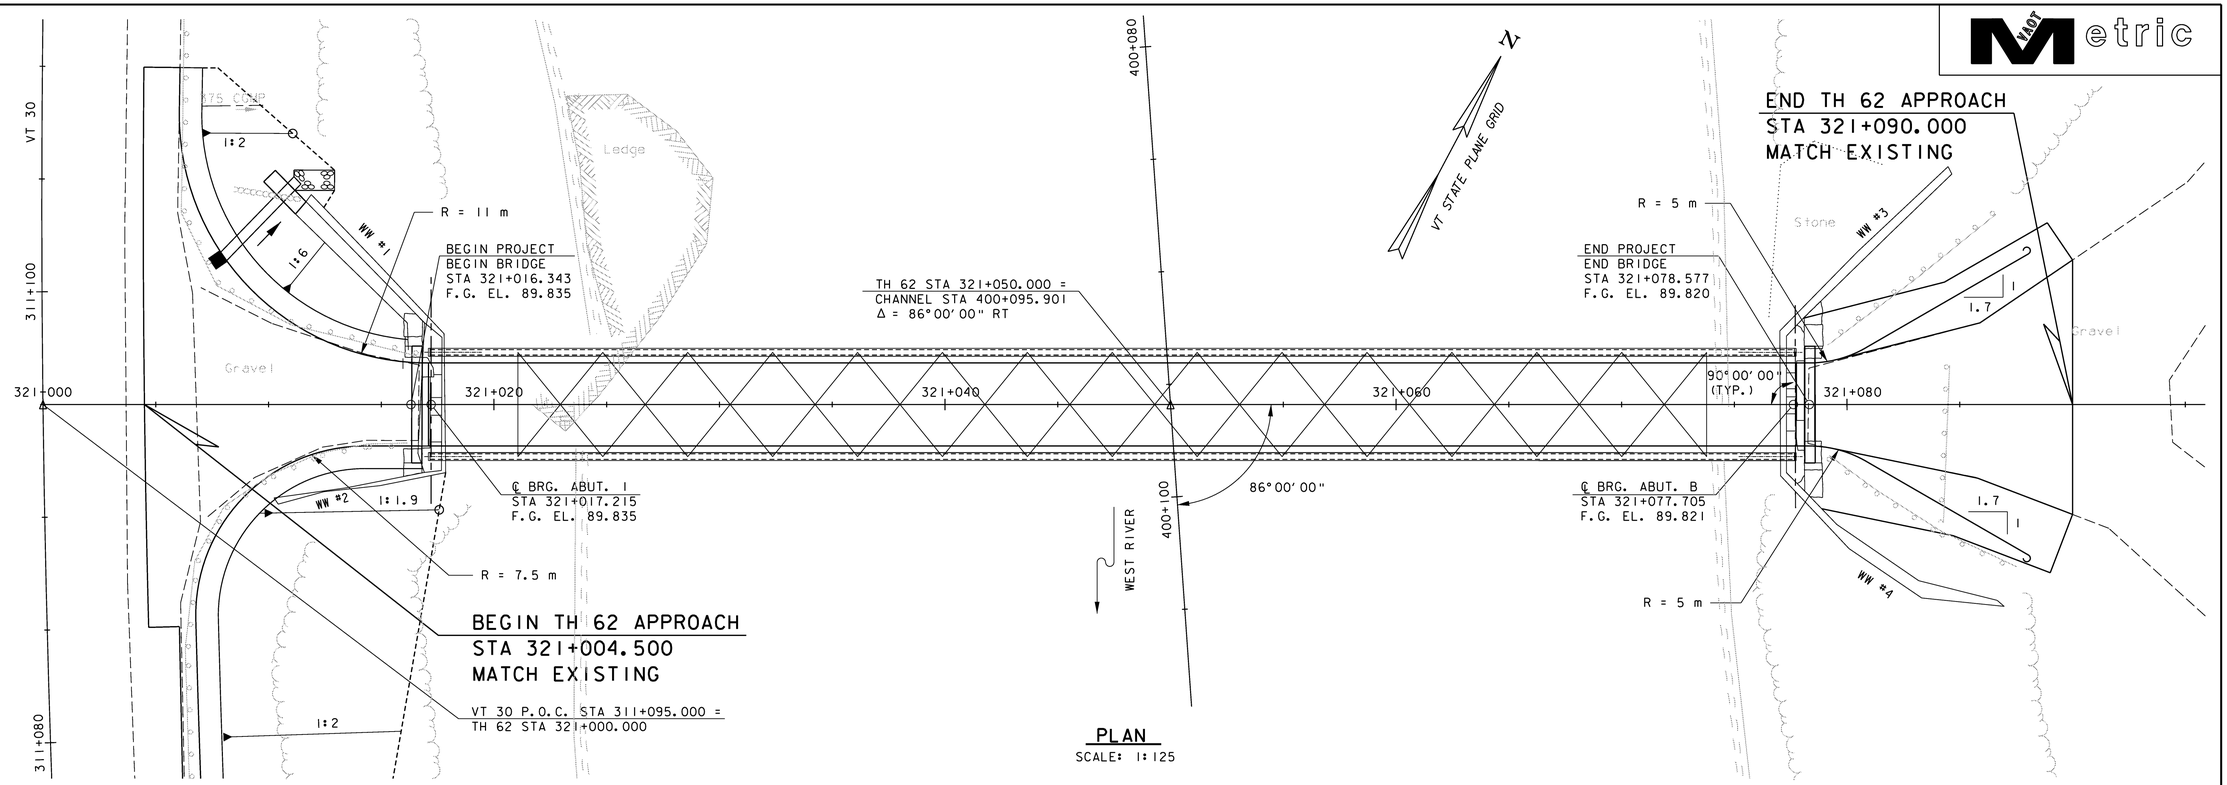

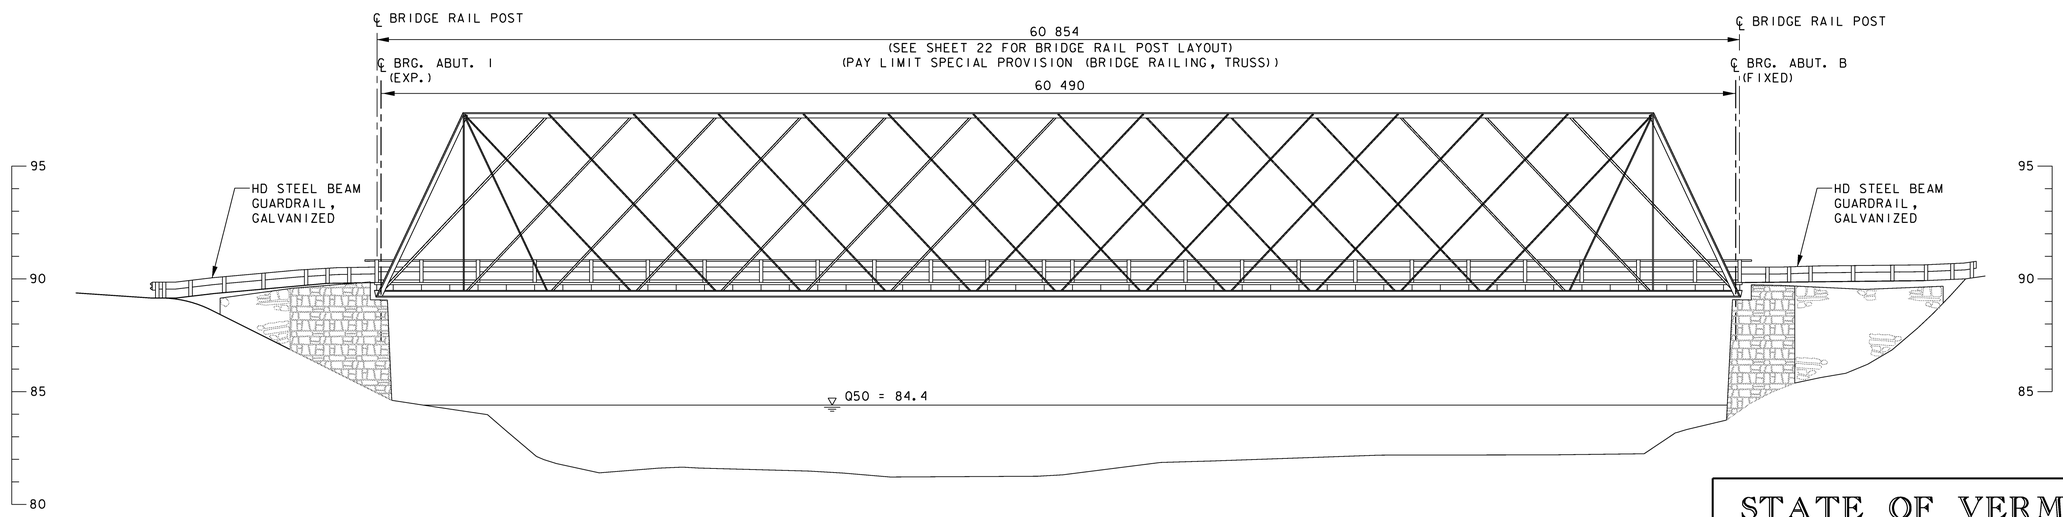

VANASSE HANGEN BRUSTLIN, INC.

STATE OF VERMONT
AGENCY OF TRANSPORTATION

Town Of DUMMERSTON	Bridge No. 37
	Log Sta.
Highway No. TH 62	Surv. Sta.
TH 62 OVER WEST RIVER	
PLAN & ELEVATION	
Designed By T.S. BRYANT	Drawn By C.L. CILLEY
Checked By S.M. HODGDON Date 4/09	Bridge Design Supervisor S.M. HODGDON Date 4/09
PROJECT DUMMERSTON	PROJECT NO. BHO 1442 (28)
I.G.C. Info.	
Bridge Sheet No. ZJ080GPE	Sheet 8 of 49

VHB NO. 5192 plot date: 4/3/2009