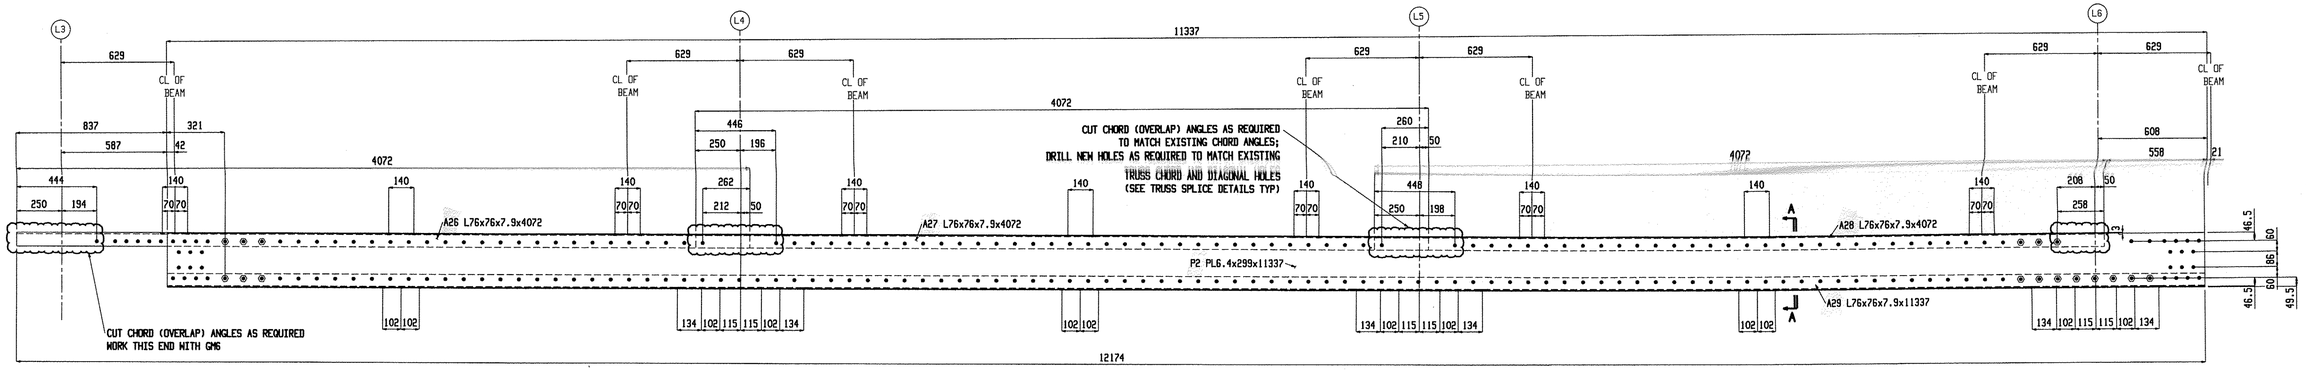

2 GROUP MEMBERS GM7

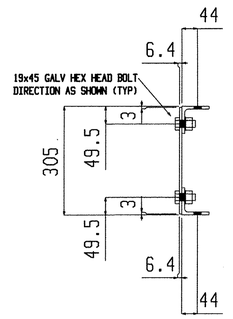

Section A-A
GM7

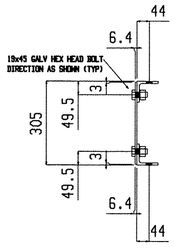

Section A-A
GM8

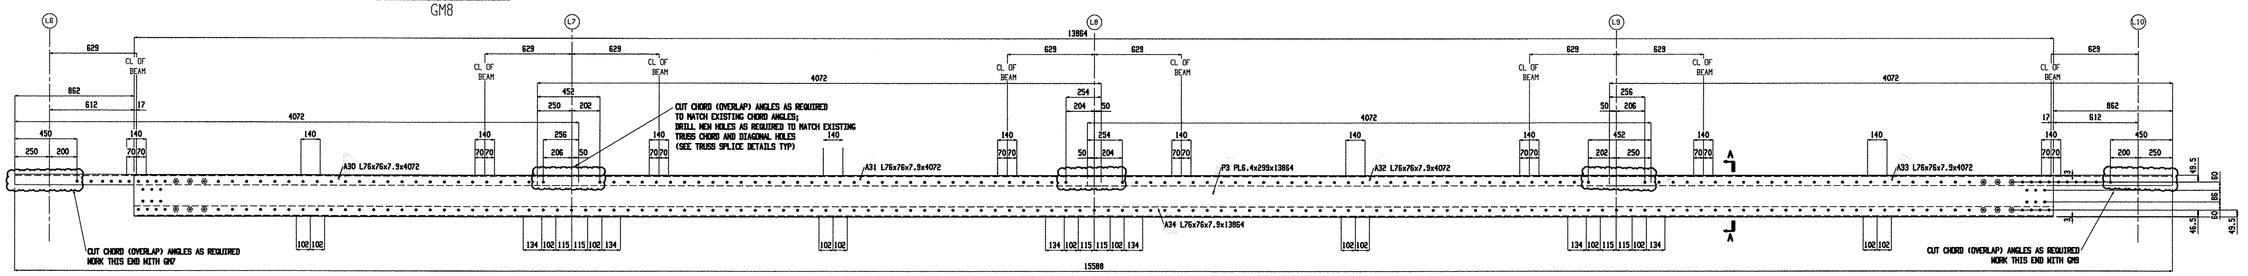

2 GROUP MEMBERS GM8

BILL OF MATERIAL

Qty Tot.	Piece Mark	Description	Length	Seq NO.	Seq Qty	Adv ABM #	Steel Grade	Remarks
2	GM7	GROUP MEMBER						
2	P2 .	PL6.4x299	11337				M270M-345	
2	A29 .	L76x76x7.9	11337				M270M-345	
2	A26 .	L76x76x7.9	4072				M270M-345	
2	A27 .	L76x76x7.9	4072				M270M-345	
2	A28 .	L76x76x7.9	4072				M270M-345	

BILL OF MATERIAL

Qty Tot.	Piece Mark	Description	Length	Seq NO.	Seq Qty	Adv ABM #	Steel Grade	Remarks
2	GM8	GROUP MEMBER						
2	P3 .	PL6.4x299	13864				M270M-345	
2	A34 .	L76x76x7.9	13864				M270M-345	
2	A30 .	L76x76x7.9	4072				M270M-345	
2	A31 .	L76x76x7.9	4072				M270M-345	
2	A32 .	L76x76x7.9	4072				M270M-345	
2	A33 .	L76x76x7.9	4072				M270M-345	

BILL OF MATERIAL

Qty Tot.	Piece Mark	Description	Length	Seq NO.	Seq Qty	Adv ABM #	Steel Grade	Remarks

Total weight : 1722

Nov 06 2009 10:54:06 AM

RECEIVED
CK'D BY_____ OK'D BY_____
NOV 17 2009
RESUBMIT_____ APPROVED_____ As Noted
BY DATE

Renaud Bros. Inc.
283 Fort Bridgeman Rd. #2
Vernon, VT. 05354
Phone 1-802 257-7383

Rev.No: | Date:

Holes: 21mm UNO
BOLTS: 19mm DIA. M164M-I GALV UNO
Steel GR: M270M-GR345 UNO
Paint: PER SPECS (GREEN) UNO ☐ Product?
Surface Prep: PER SPECS

Project:
DUMMERSTON BRIDGE
DUMMERSTON, VT

Date: 9-9-09
Job No. BHO 1442(28)
DWN. BY: EG
Checked: MRS
Sheet No. ~~GM7, GM8~~ Sheet#