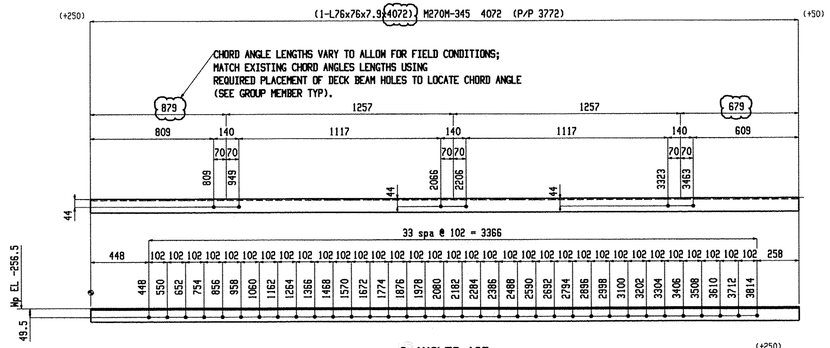

2 ANGLES A35

SHOP NOTE:
TOE DIRECTION NEAR SIDE

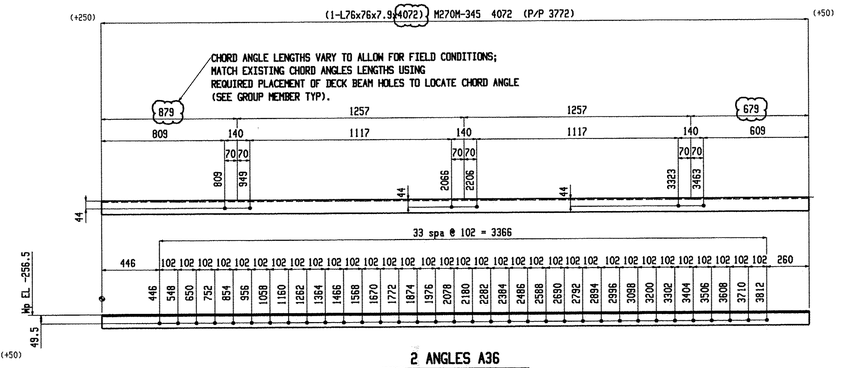

2 ANGLES A36

SHOP NOTE:
TOE DIRECTION NEAR SIDE

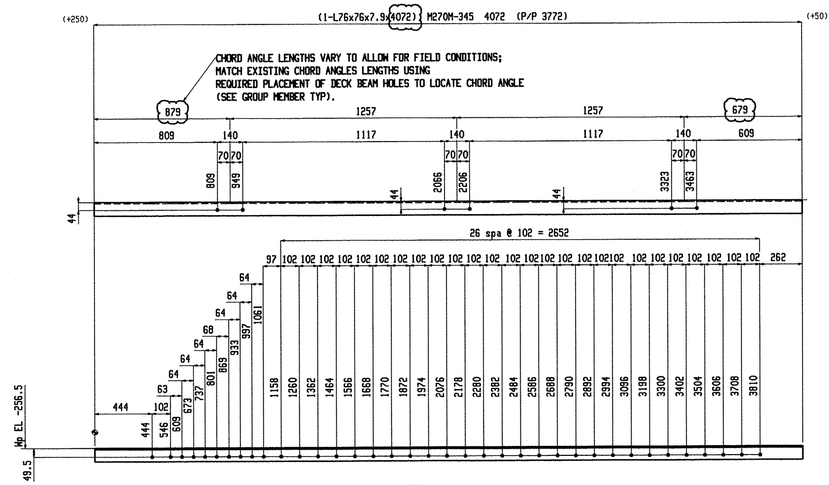

2 ANGLES A37

SHOP NOTE:
TOE DIRECTION NEAR SIDE

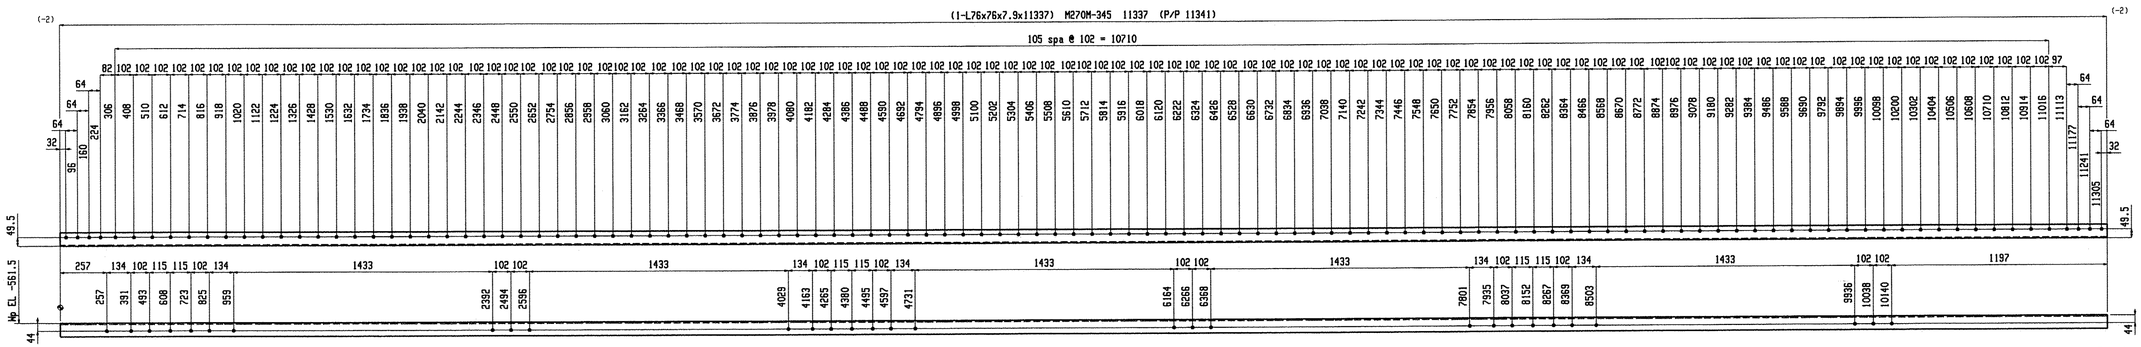
(-2)
(1-L76x76x7.9x11337) M270M-345 11337 (P/P 11341)
(-2)
105 spa @ 102 = 10710
82 102 102 102 102 102 102 102 102 102 102 102 102 102 102 102 102 102 102 102