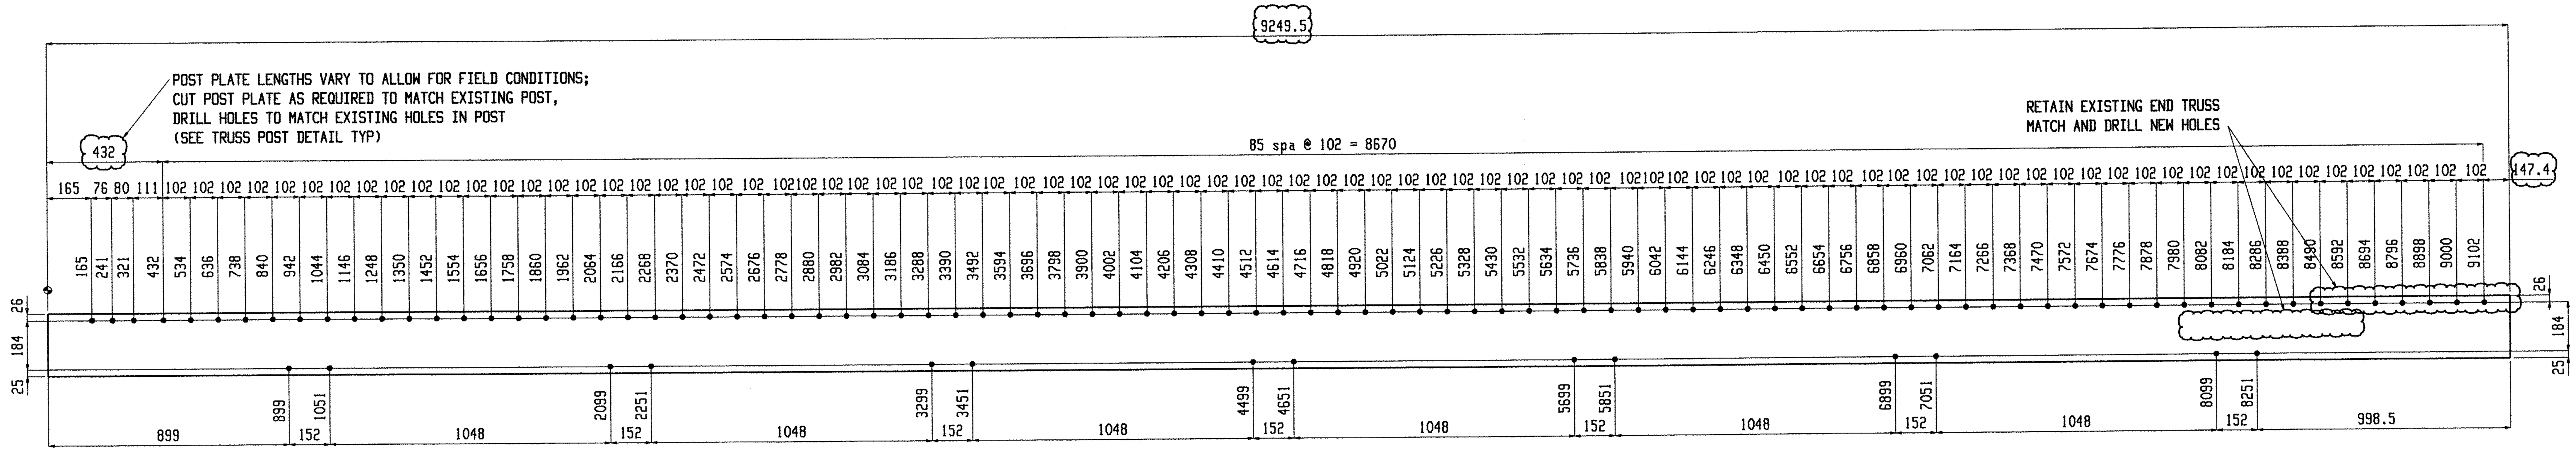

8 MISCS P5

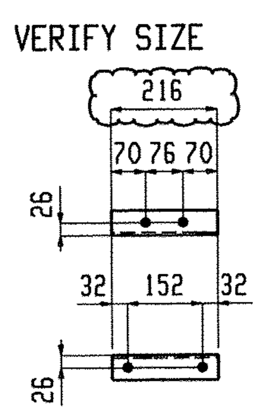

56 MISCS M8

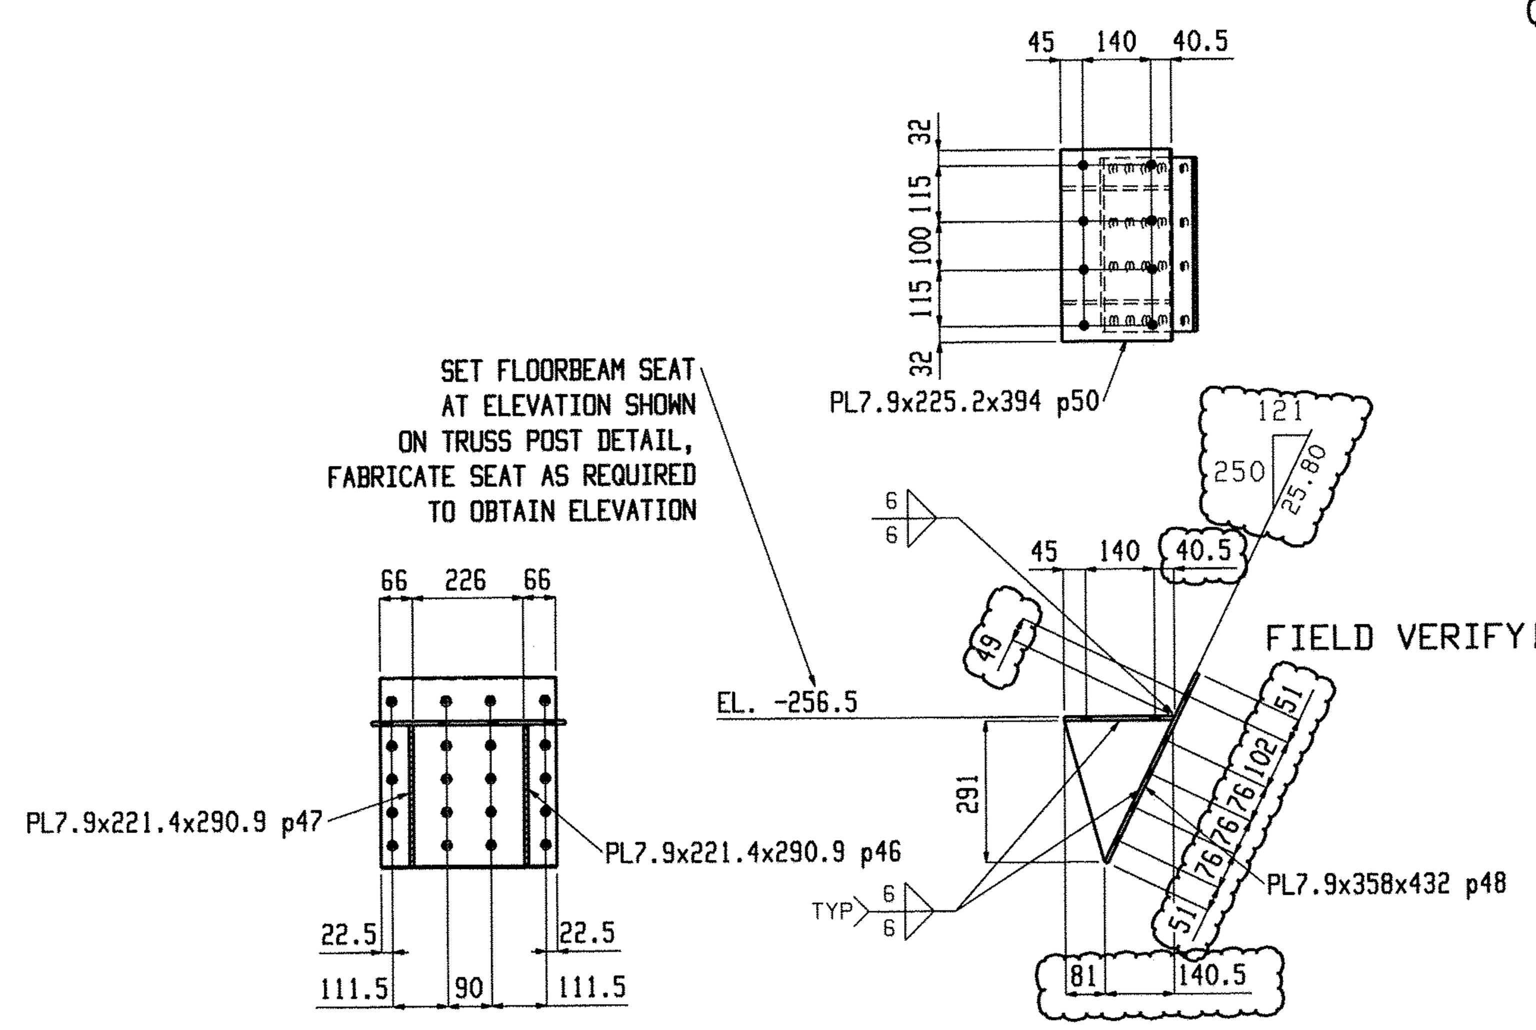

4 MISCS M9

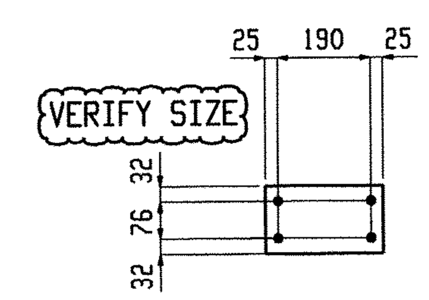

28 MISCS M10

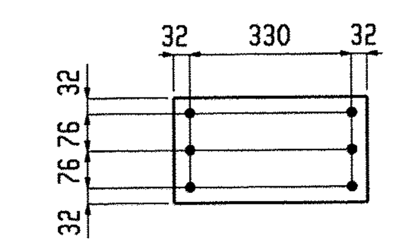

48 MISCS M11

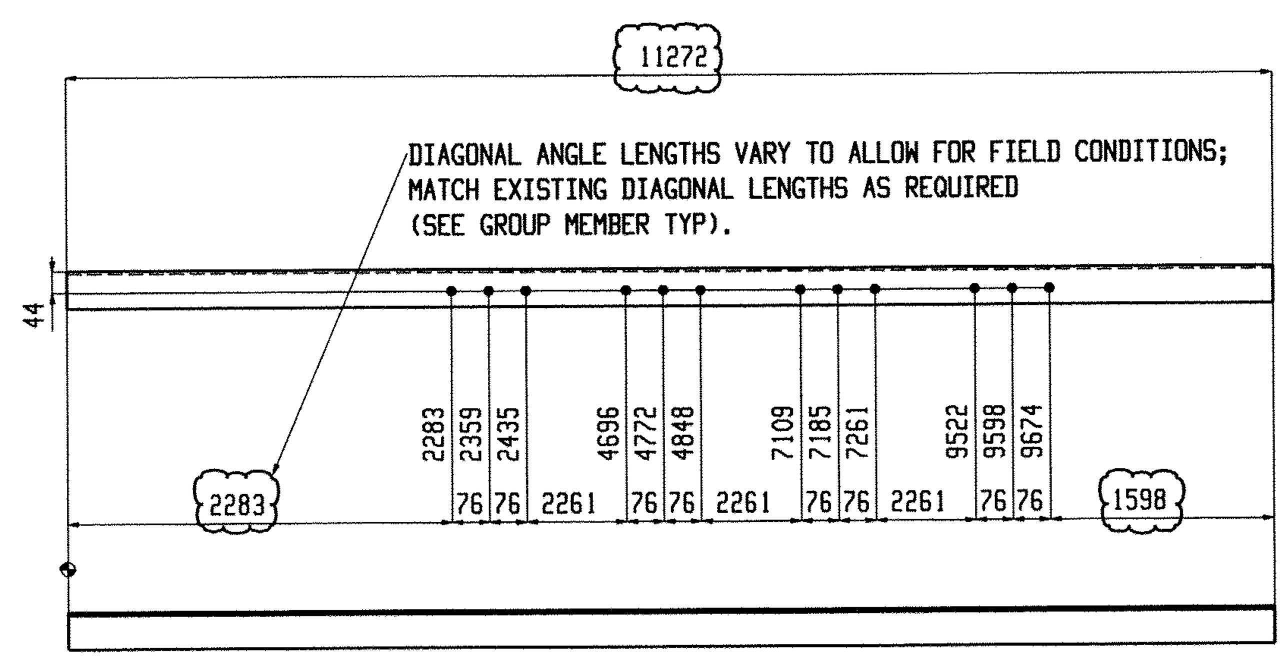

4 MISCS A46

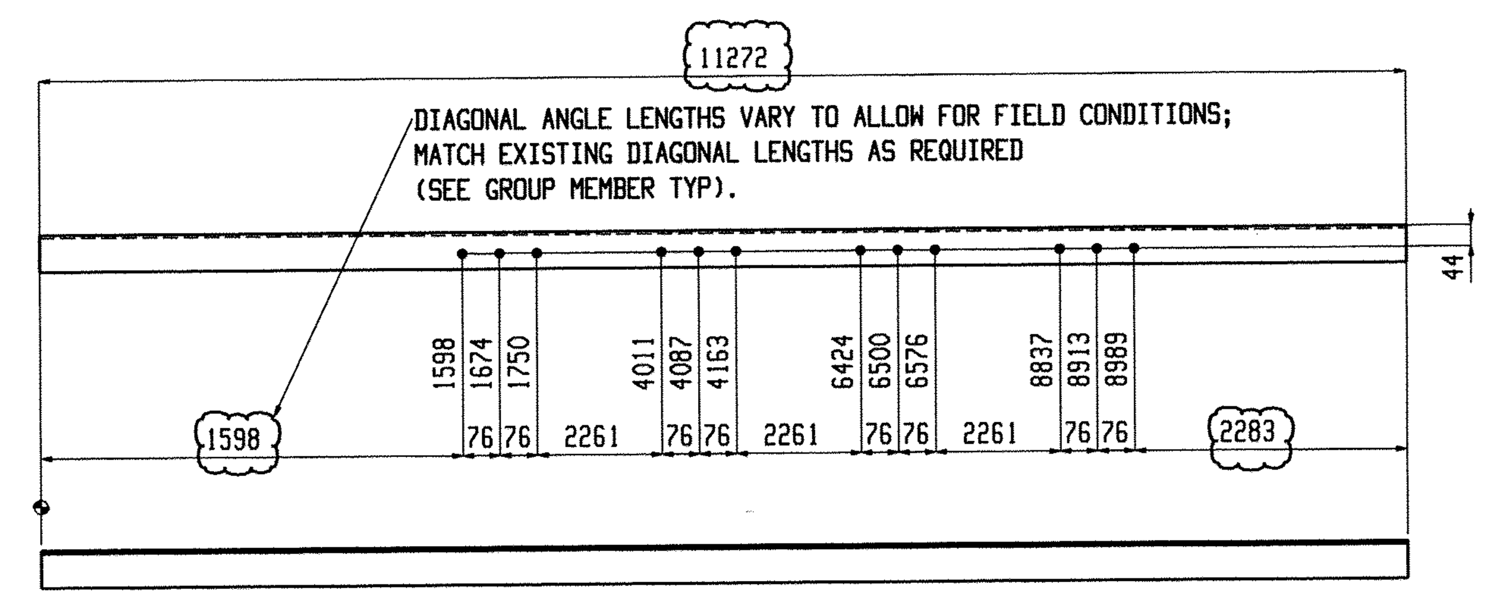

4 MISCS A45

RECEIVED
CK'D BY ____ OK'D BY ____
NOV 17 2009
APPROVED ✓ AS NOTED
BY DATE

NOTE: WORK THIS DRAWING WITH GROUP MEMBER GM11,GM13&GM14

BILL OF MATERIAL

Qty Tot.	Piece Mark	Description	Length	Seq NO.	Seq Qty	Adv ABM #	Steel Grade	Remarks
8	P5	MISC		1	8			
8	P5	PL6.4x235	9249.5				M270M-345	
56	M8	MISC		1	56			
56	M8	L51x51x6.4	216				M270M-345	
4	M9	MISC		1	4			
4	p48	PL7.9x358	432				M270M-345	
4	p50	PL7.9x225.2	394				M270M-345	

BILL OF MATERIAL

Qty Tot.	Piece Mark	Description	Length	Seq NO.	Seq Qty	Adv ABM #	Steel Grade	Remarks
4	p46	PL7.9x221.4	291				M270M-345	
4	p47	PL7.9x221.4	291				M270M-345	
28	M10	MISC		1	28			
28	M10	PL6.4x140	240				M270M-345	
48	M11	MISC		1	48			
48	M11	PL6.4x216	394				M270M-345	

BILL OF MATERIAL

Qty Tot.	Piece Mark	Description	Length	Seq NO.	Seq Qty	Adv ABM #	Steel Grade	Remarks
4	A45	MISC		1	4			
4	A45	L76x76x6.4	11272				M270M-345	
4	A46	MISC		1	4			
4	A46	L76x76x6.4	11272				M270M-345	

Total weight : 1931

Nov 06 2009 10:55:30 AM

Renaud Bros. Inc.
283 Fort Bridgeman Rd. #2
Vernon, VT. 05354
Phone 1-802 257-7383

Holes:	21mm UNO
BOLTS:	19mm DIA. M164M-I GALV UNO
Steel GR:	M270M-GR345 UNO
Paint:	PER SPECS (GREEN) UNO — product?
Surface Prep:	PER SPECS

Rev.No: | Date:

Project: DUMMERSTON BRIDGE
DUMMERSTON, VT

Date:	Job No.
9-9-09	BHO 1442(28)

DWN. BY:	Checked:	Sheet No.
EG	MRS	17