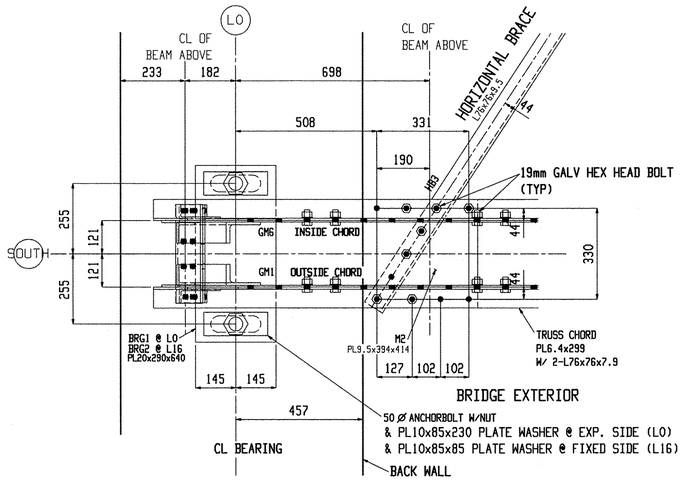

BRACE_DETAIL_L0

Elevation: -571 (U.N.)
(SIM L16)

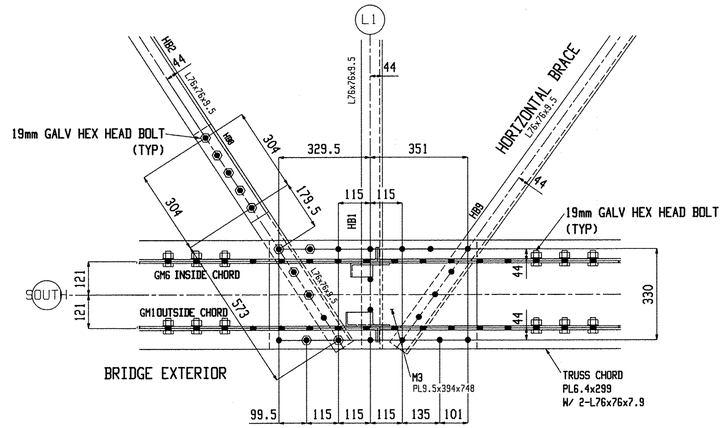

BRACE_DETAIL_L1

Elevation: -571 (U.N.)
(SIM L15)

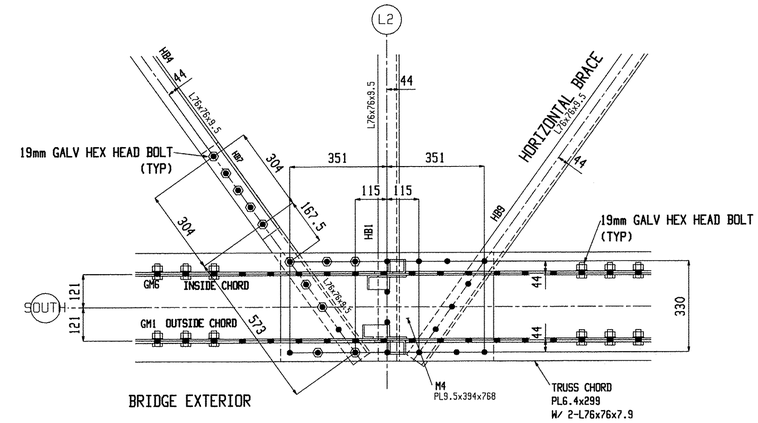

BRACE_DETAIL_L2

Elevation: -571 (U.N.)
(SIM L4,L5,L7,L9,
L11,L12&L14)

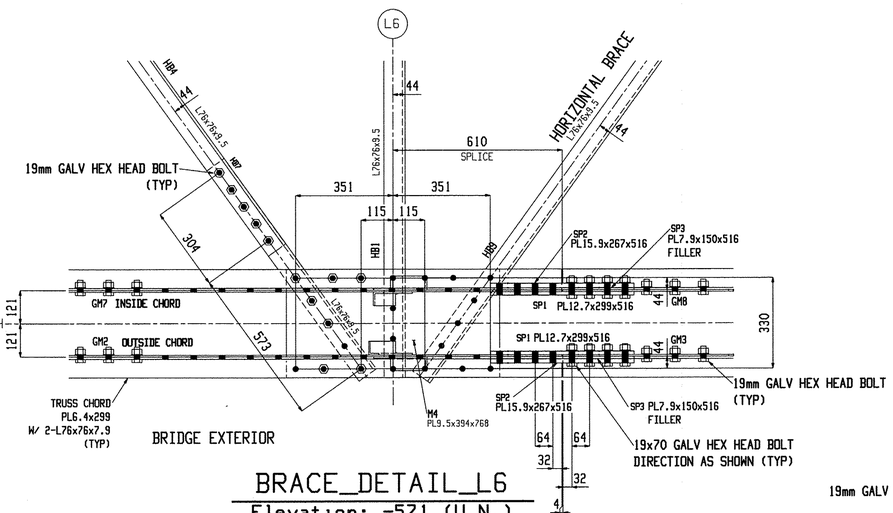

BRACE_DETAIL_L6

Elevation: -571 (U.N.)
(SIM L10)

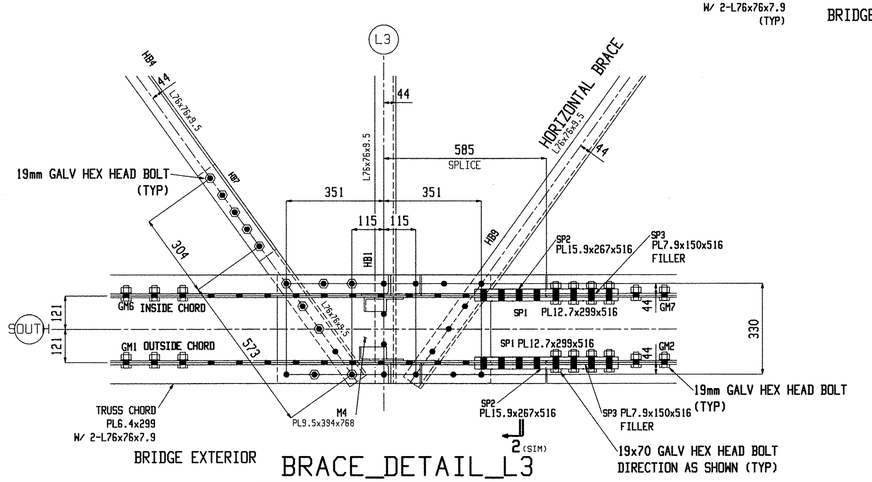

BRACE_DETAIL_L3

Elevation: -571 (U.N.)
(SIM L13)

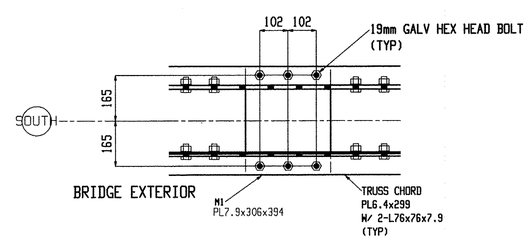

DETAIL_A

Elevation: -571 (U.N.)

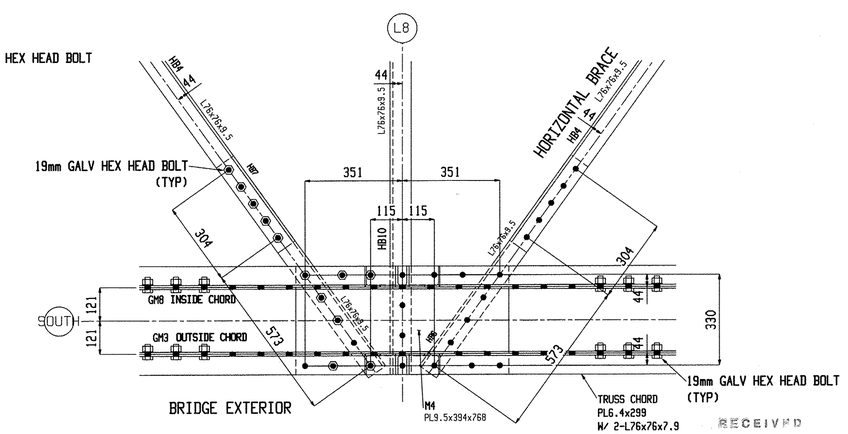

BRACE_DETAIL_L8

Elevation: -571 (U.N.)

RECEIVED
CK'D BY _____ OK'D BY _____
NOV 17 2009
APPROVED
BY DATE

Renaud Bros. Inc.
283 Fort Bridgeman Rd. #2
Vernon, VT. 05354
Phone 1-802 257-7383

Holes:	21mm UNO
BOLTS:	19mm DIA. M164M-I GALV UND
Steel GR:	M270M-GR345 UND
Paint:	PER SPECS (GREEN) UND product?
Surface Prep:	PER SPECS

Rev.No: Date:

Project:
DUMMERSTON BRIDGE
DUMMERSTON, VT

Date: 9-9-09		Job No. BHO 1442(28)
DWN. BY: EG	Checked: MRS	Sheet No. E4

Nov 06 2009 10:56:15 AM