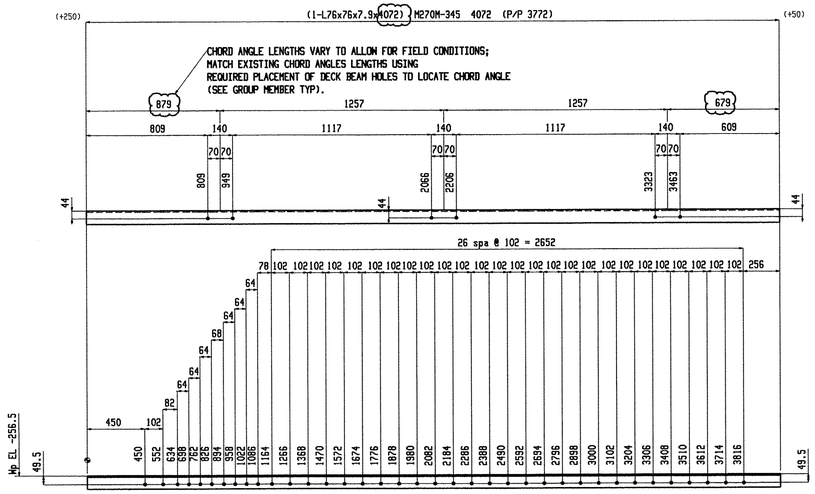

2 ANGLES A9

SHOP NOTE:
TOE DIRECTION NEAR SIDE

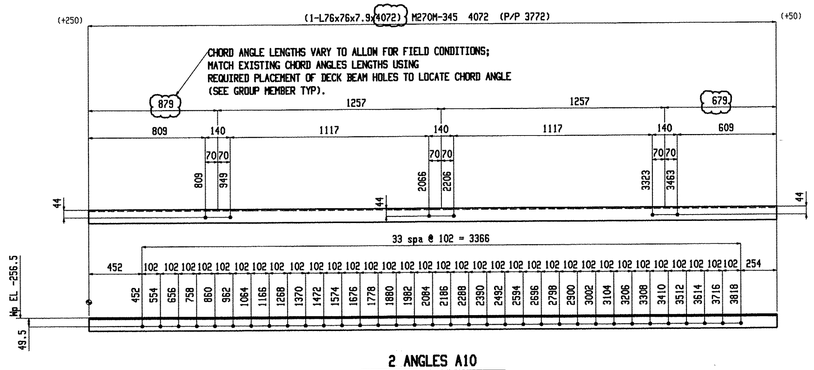

2 ANGLES A10

SHOP NOTE:
TOE DIRECTION NEAR SIDE

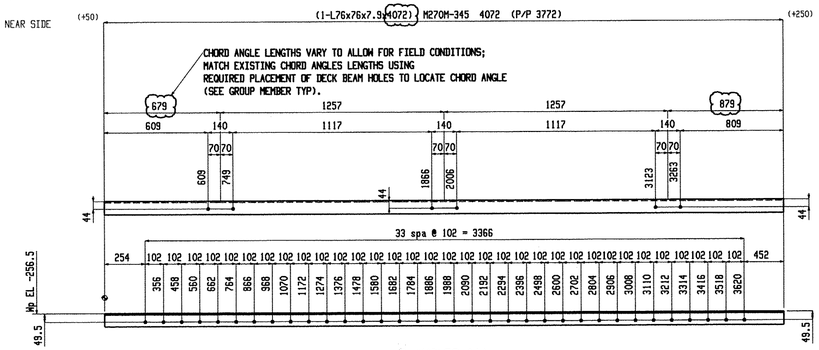

2 ANGLES A11

SHOP NOTE:
TOE DIRECTION NEAR SIDE

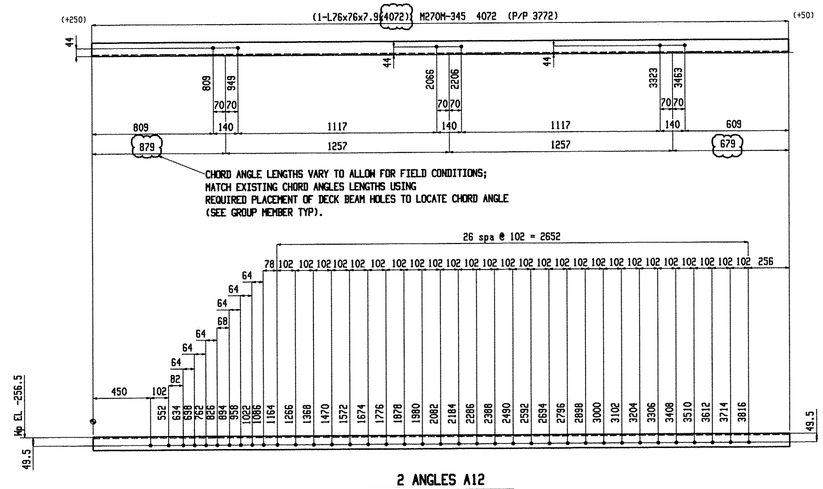

2 ANGLES A12

SHOP NOTE:
TOE DIRECTION FAR SIDE

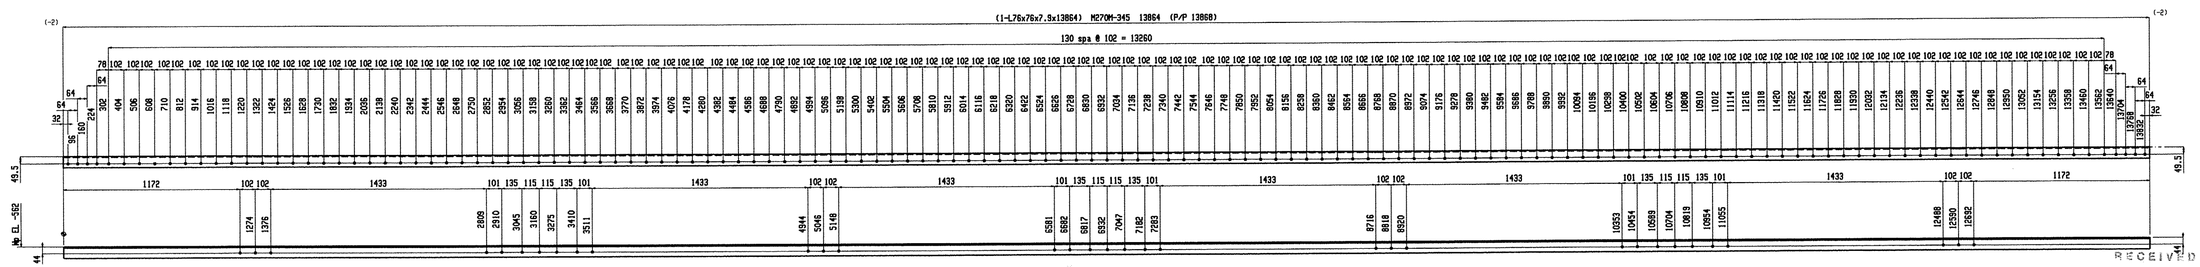

2 ANGLES A13

SHOP NOTE:
TOE DIRECTION NEAR SIDE

RECEIVED
OK'D BY_____ OK'D BY_____
NOV 17 2009
RESUBMIT_____ APPROVED ✓ AS NOTED
BY DATE

NOTE: WORK THIS DRAWING WITH GROUP MEMBER GM3

BILL OF MATERIAL

Qty Tot.	Piece Mark	Description	Length	Seq NO.	Seq Qty	Adv ABM #	Steel Grade	Remarks
2	A9	ANGLE		1	2			
2	A9	L76x76x7.9	4072				M270M-345	
2	A10	ANGLE		1	2			
2	A10	L76x76x7.9	4072				M270M-345	

BILL OF MATERIAL

Qty Tot.	Piece Mark	Description	Length	Seq NO.	Seq Qty	Adv ABM #	Steel Grade	Remarks
2	A11	ANGLE		1	2			
2	A11	L76x76x7.9	4072				M270M-345	
2	A12	ANGLE		1	2			
2	A12	L76x76x7.9	4072				M270M-345	

BILL OF MATERIAL

Qty Tot.	Piece Mark	Description	Length	Seq NO.	Seq Qty	Adv ABM #	Steel Grade	Remarks
2	A13	ANGLE		1	2			
2	A13	L76x76x7.9	13864				M270M-345	

Total ~~weight~~ : 542

Nov 06 2009 10:54:48 AM

Renaud Bros. Inc.
283 Fort Bridgeman Rd. #2
Vernon, VT. 05354
Phone 1-802 257-7383

Rev.No: | Date:

Holes: 21mm UNO
BOLTS: 19mm DIA. M164M-I GALV UNO
Steel GR: M270M-GR345 UNO
Paint: PER SPECS (GREEN) UNO
Surface Prep: PER SPECS

Product?

Project:
DUMMERSTON BRIDGE
DUMMERSTON, VT

Date: 9-9-09
Job No. BHO 1942 (38)
DWN. BY: EG
Checked: MRS
Sheet No. 7