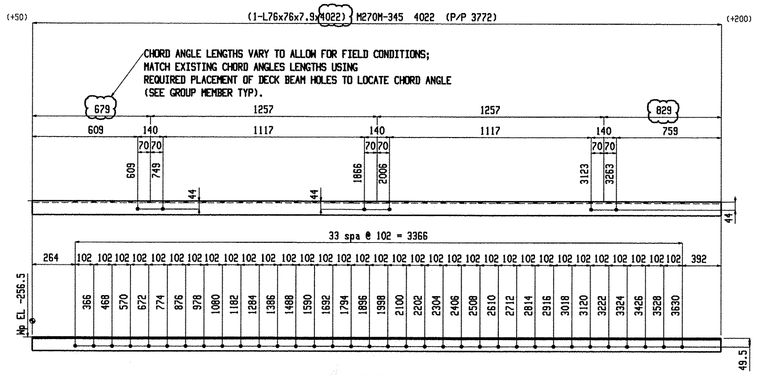

2 ANGLES A18

SHOP NOTE:
TOE DIRECTION NEAR SIDE

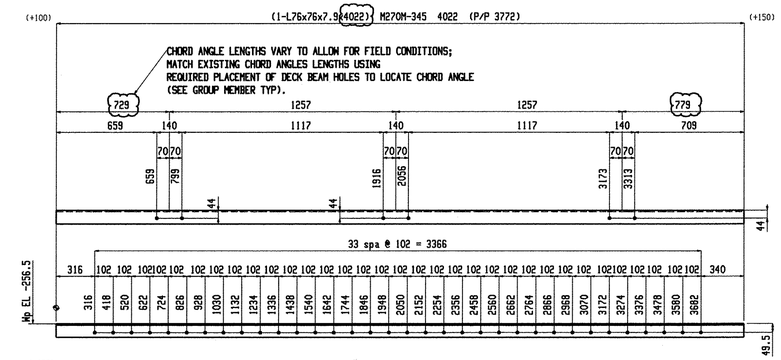

2 ANGLES A19

SHOP NOTE:
TOE DIRECTION NEAR SIDE

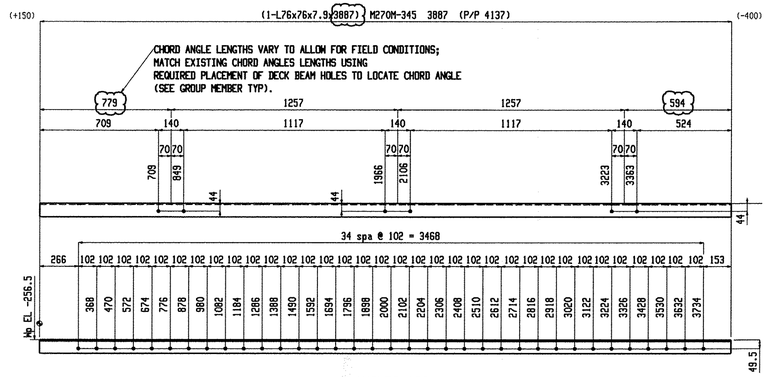

2 ANGLES A20

SHOP NOTE:
TOE DIRECTION NEAR SIDE

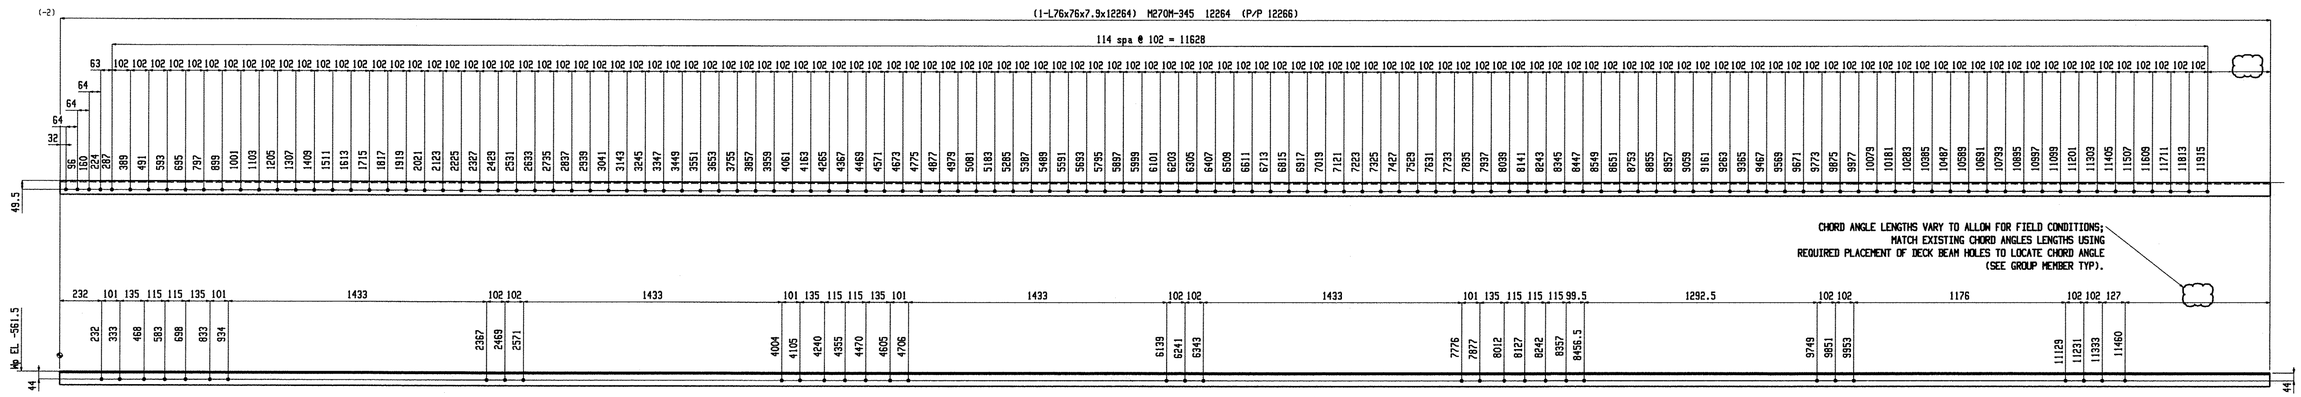
(-2)
(1-L76x76x7.9x12264) M270M-345 12264 (P/P 12266)
114 spa @ 102 = 11628
63 102 102 102 102 102 102 102 102 102 102 102 102 102 102 102 102 102 102 102