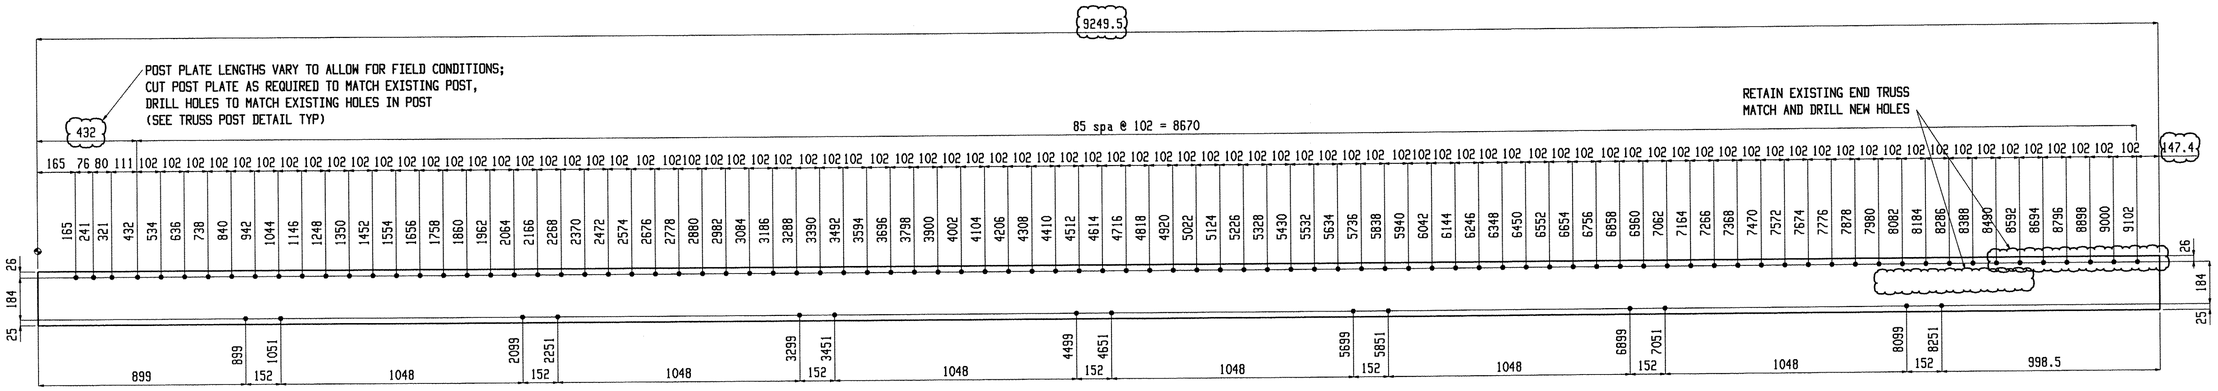
9249.5
POST PLATE LENGTHS VARY TO ALLOW FOR FIELD CONDITIONS;
CUT POST PLATE AS REQUIRED TO MATCH EXISTING POST,
DRILL HOLES TO MATCH EXISTING HOLES IN POST
(SEE TRUSS POST DETAIL TYP)
432
85 spa @ 102 = 8670
RETAIN EXISTING END TRUSS
MATCH AND DRILL NEW HOLES
147.4
165 76 80 111 102 102 102